
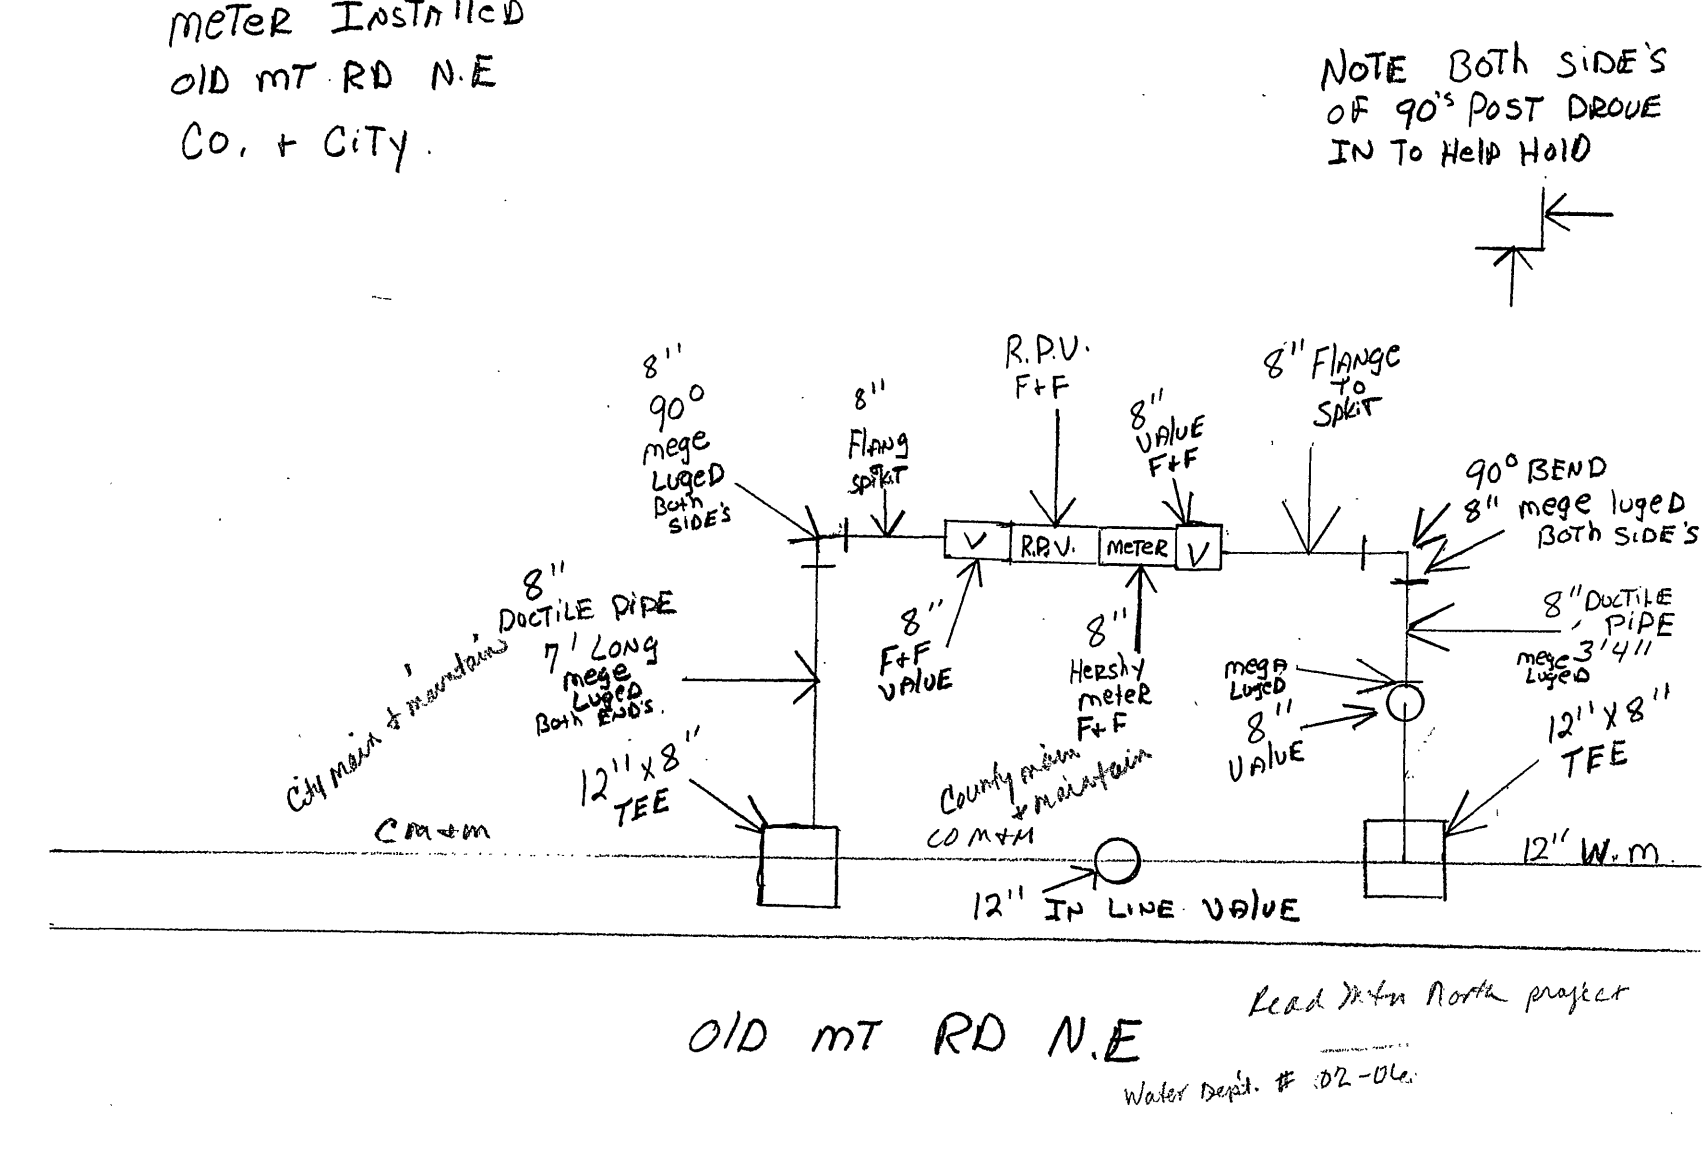
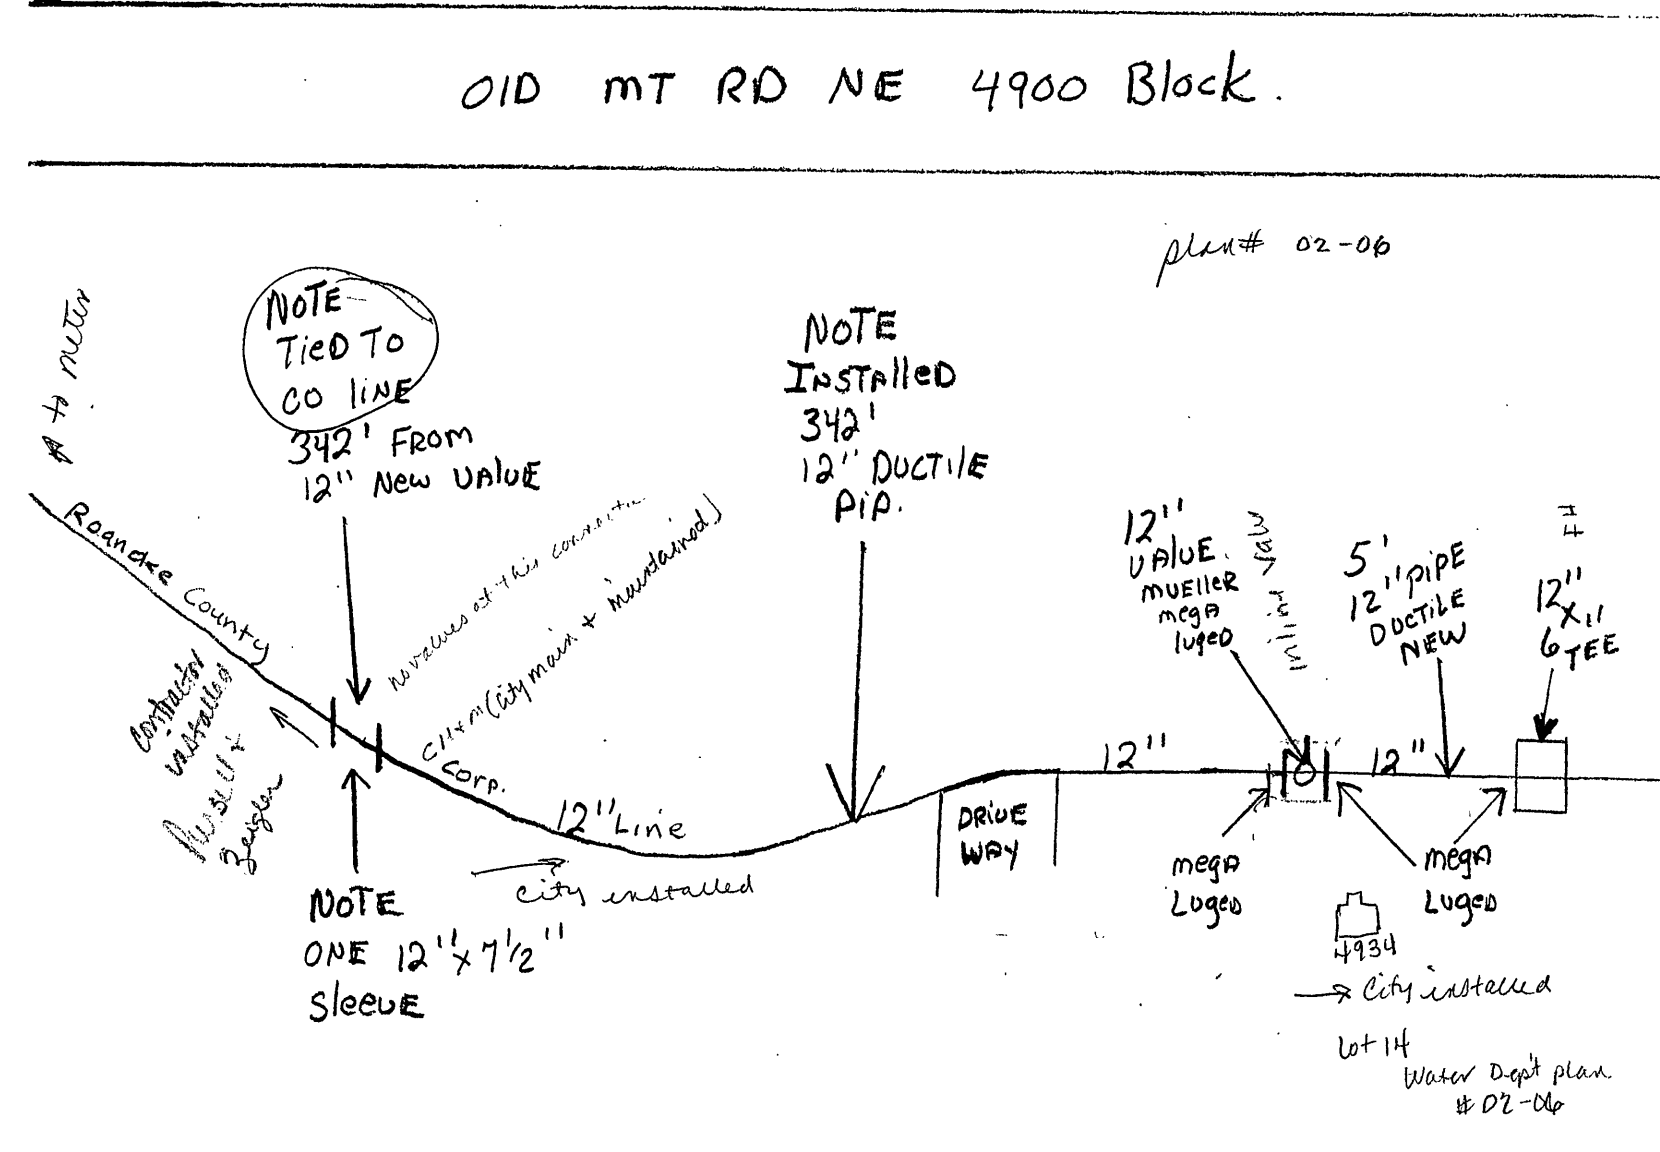
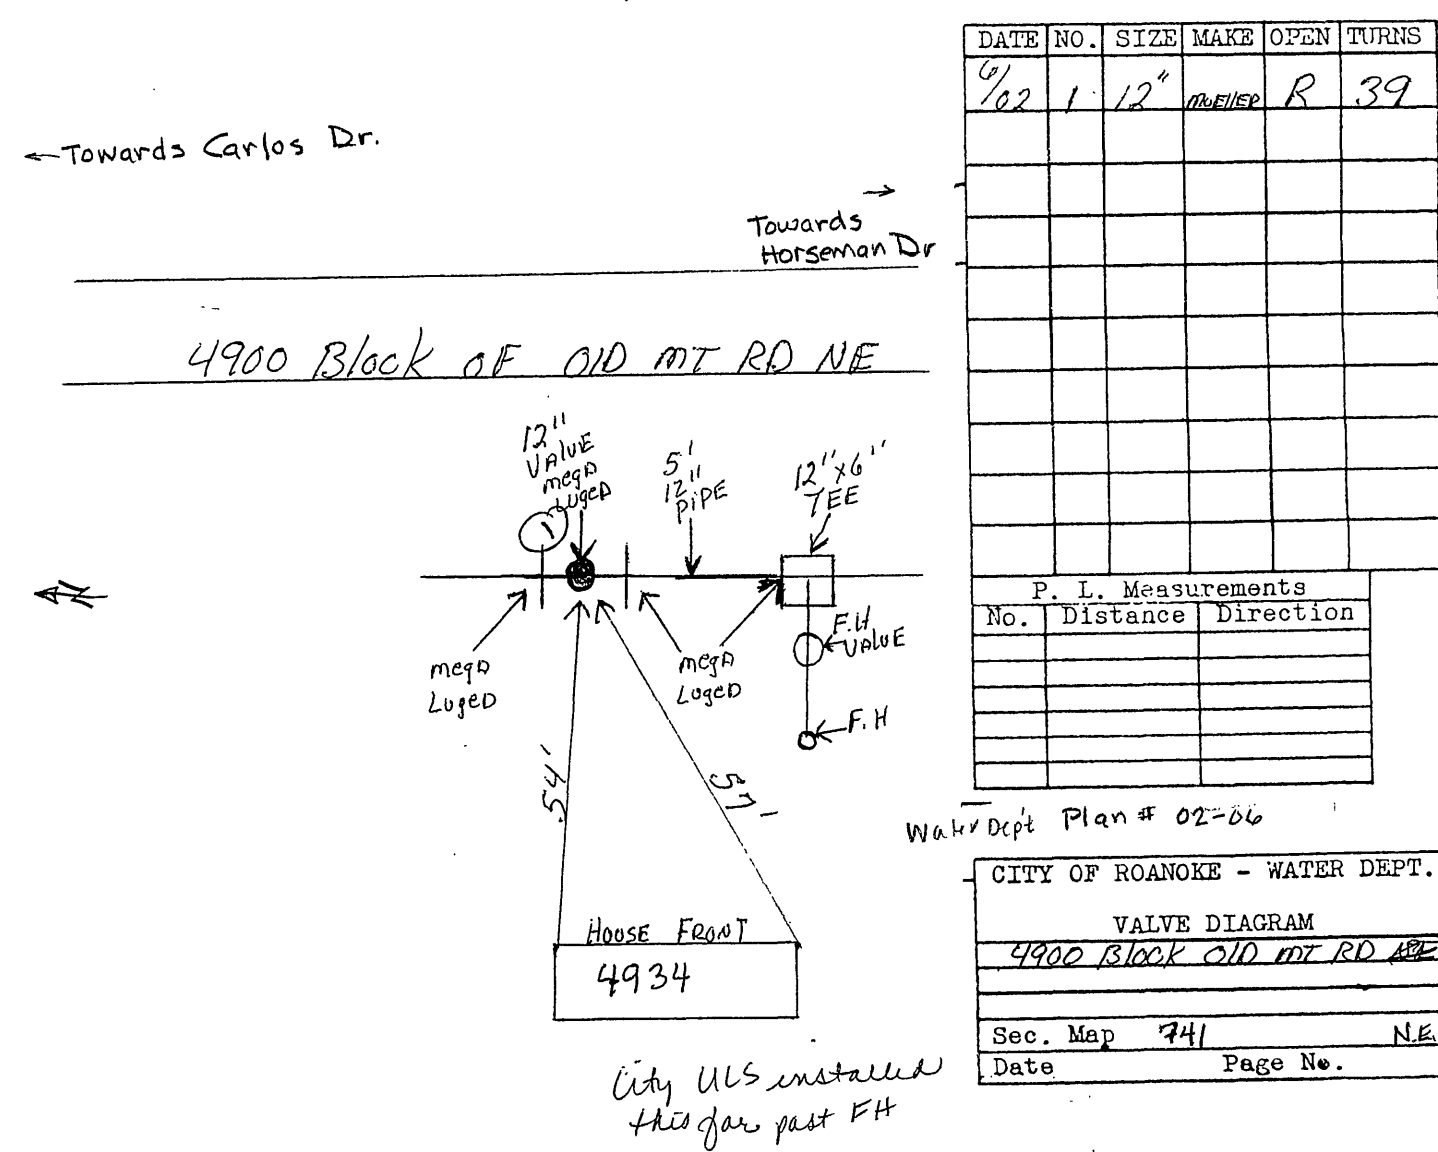


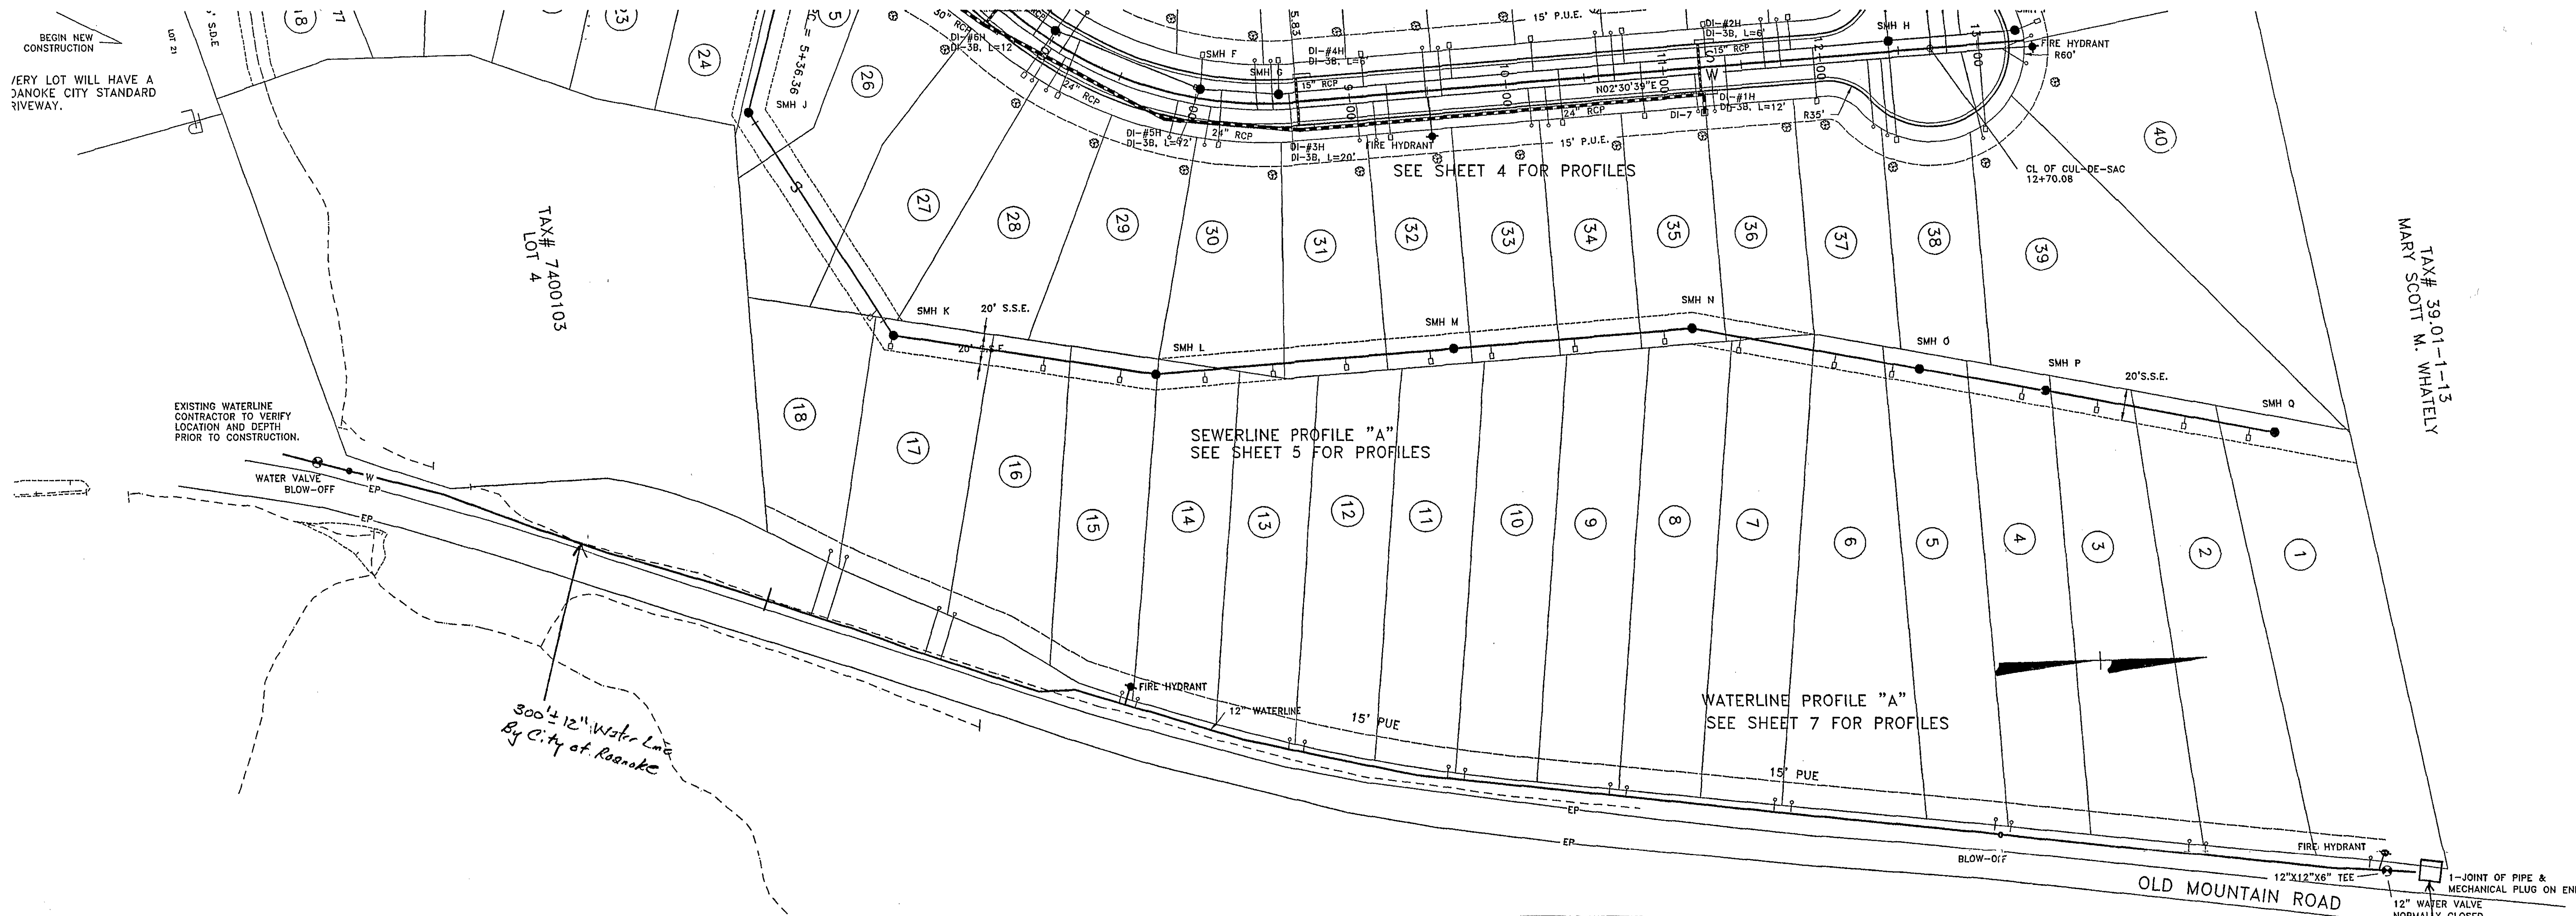


WATER DIVISION	
ROANOKE	VIRGINIA
READ MOUNTAIN - NORTH	
CITY OF ROANOKE	
SCALE: 1" = 50'	DATE: 5/15/02
DIST. MAP: 740	MANAGER WATER DIVISION
PLAN NO: 02-06	DATE: 5/15/02

Roderick F. Pierson, P.E., L.L.S.
P.O. Box 311
1332 Roanoke Road, 220 North
Daleville, VA 24083
(540) 966-3027

REV	DATE	DESCRIPTION	BY	APP
1	09/11/00	PER CITY COMMENTS		
2	09/13/00	PER CITY COMMENTS		

PLAN SHEET
READ MOUNTAIN - NORTH
CITY OF ROANOKE, VIRGINIA

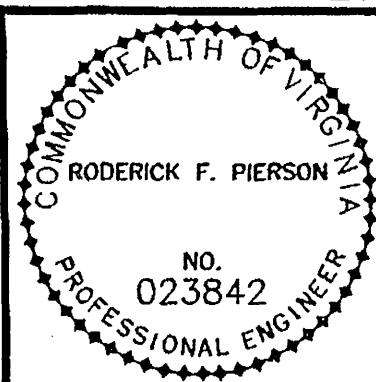

SCALE: 1" = 50'
COMM. NO. R9989
DATE: 06/15/00
SHEET 3