

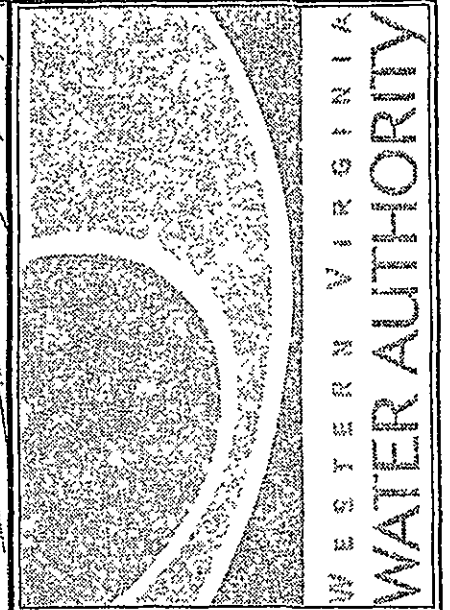


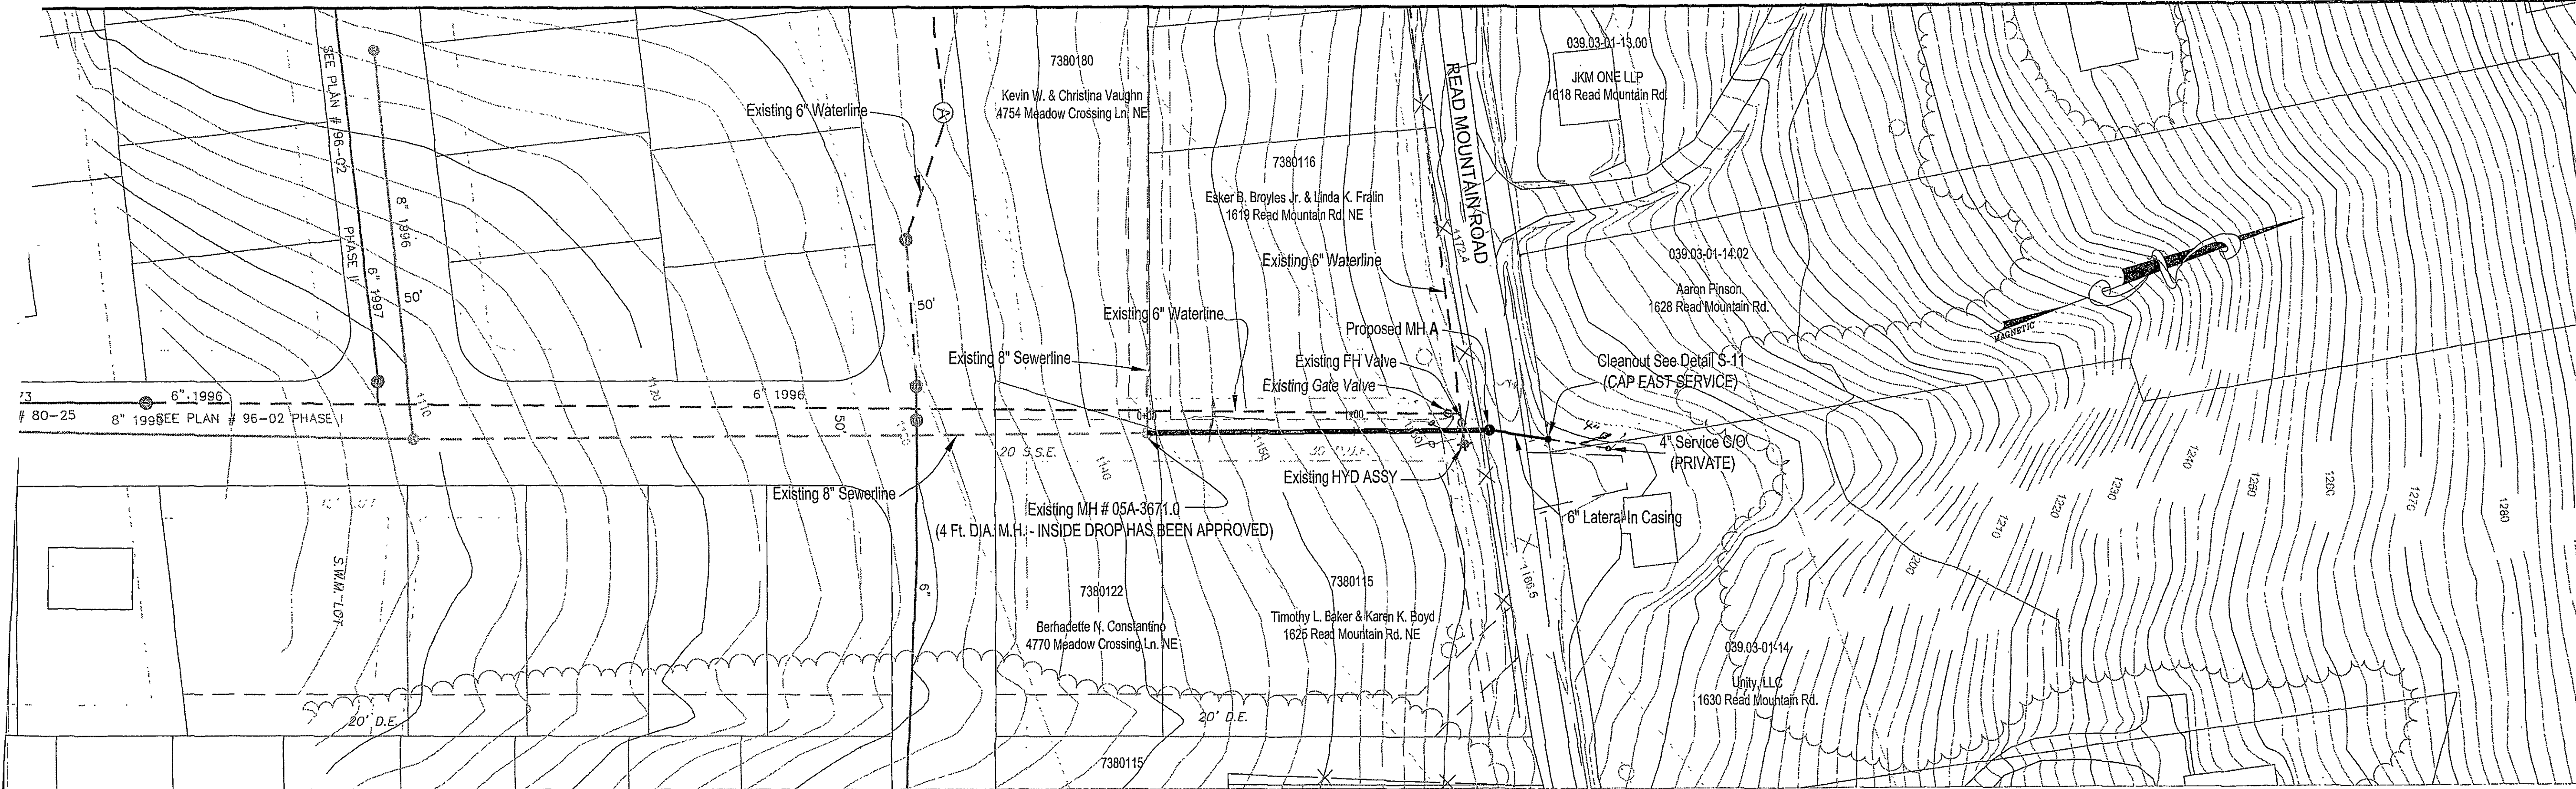

ENGINEERING SERVICES

601 SOUTH JEFFERSON STREET
ROANOKE, VIRGINIA 24011
PHONE: (540) 653-5541




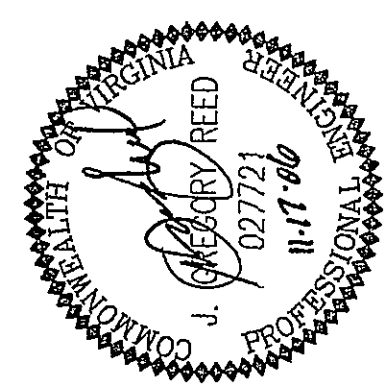


READ MOUNTAIN ROAD
SEWER EXTENSION

LEGEND

- EXISTING SANITARY SEWER
- PROPOSED SANITARY SEWER
- EXISTING SANITARY SEWER MANHOLE
- PROPOSED SANITARY SEWER MANHOLE
- PROPOSED SANITARY SEWER EASEMENT
- PROPERTY LINE
- EXISTING FENCELINE
- EXISTING WATERLINE

AS BUILT
12-12-06
4:15 PM
S.J. Connor
Sons
344-8383

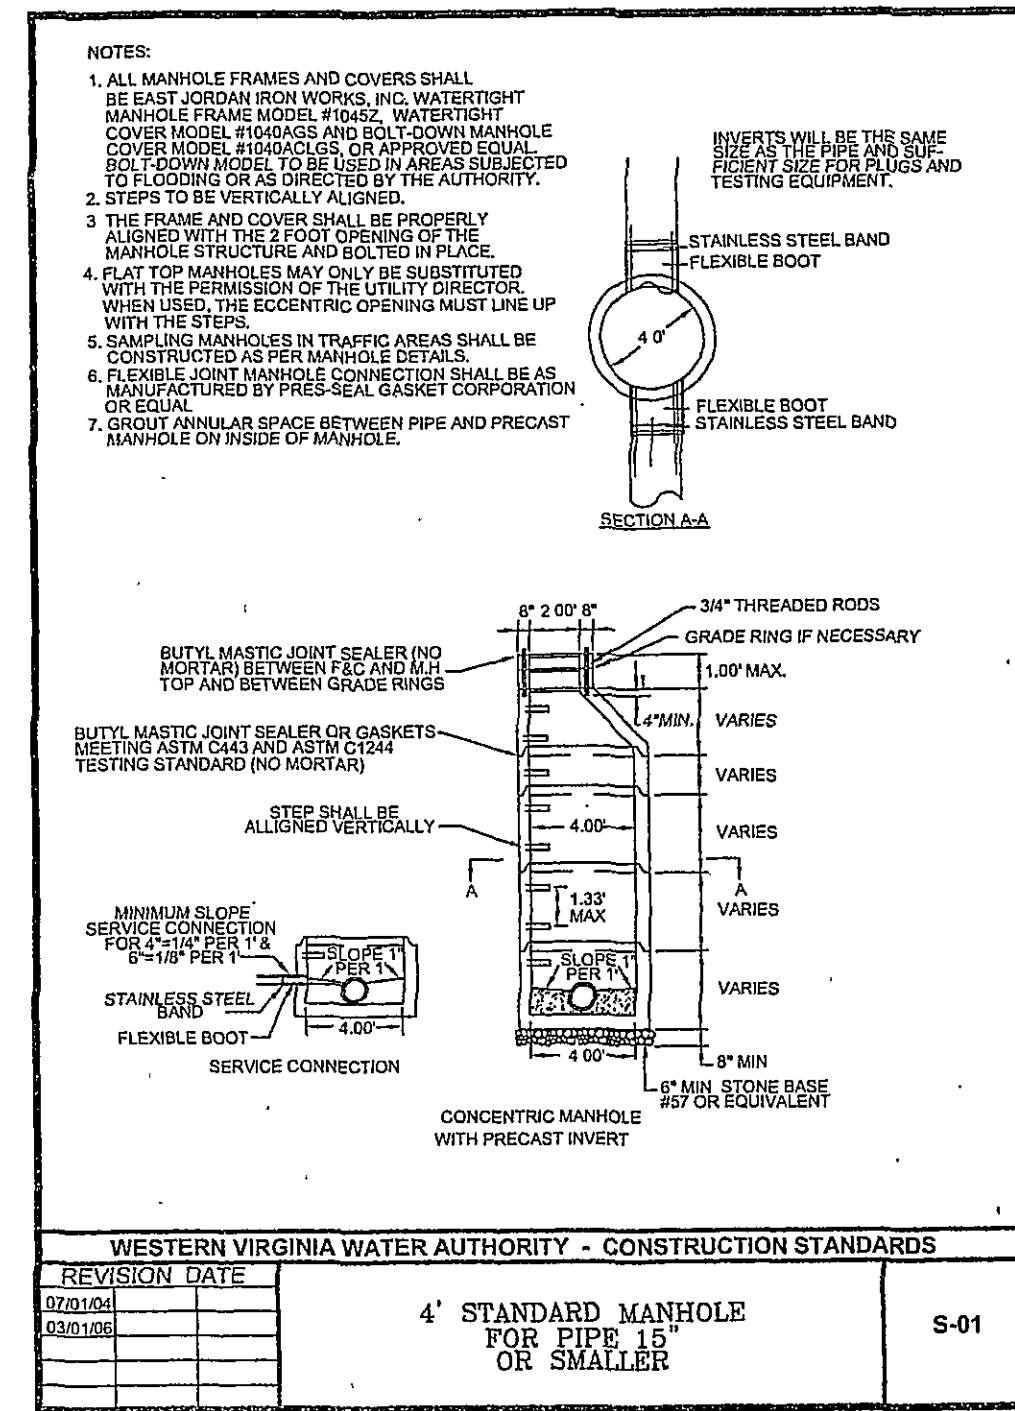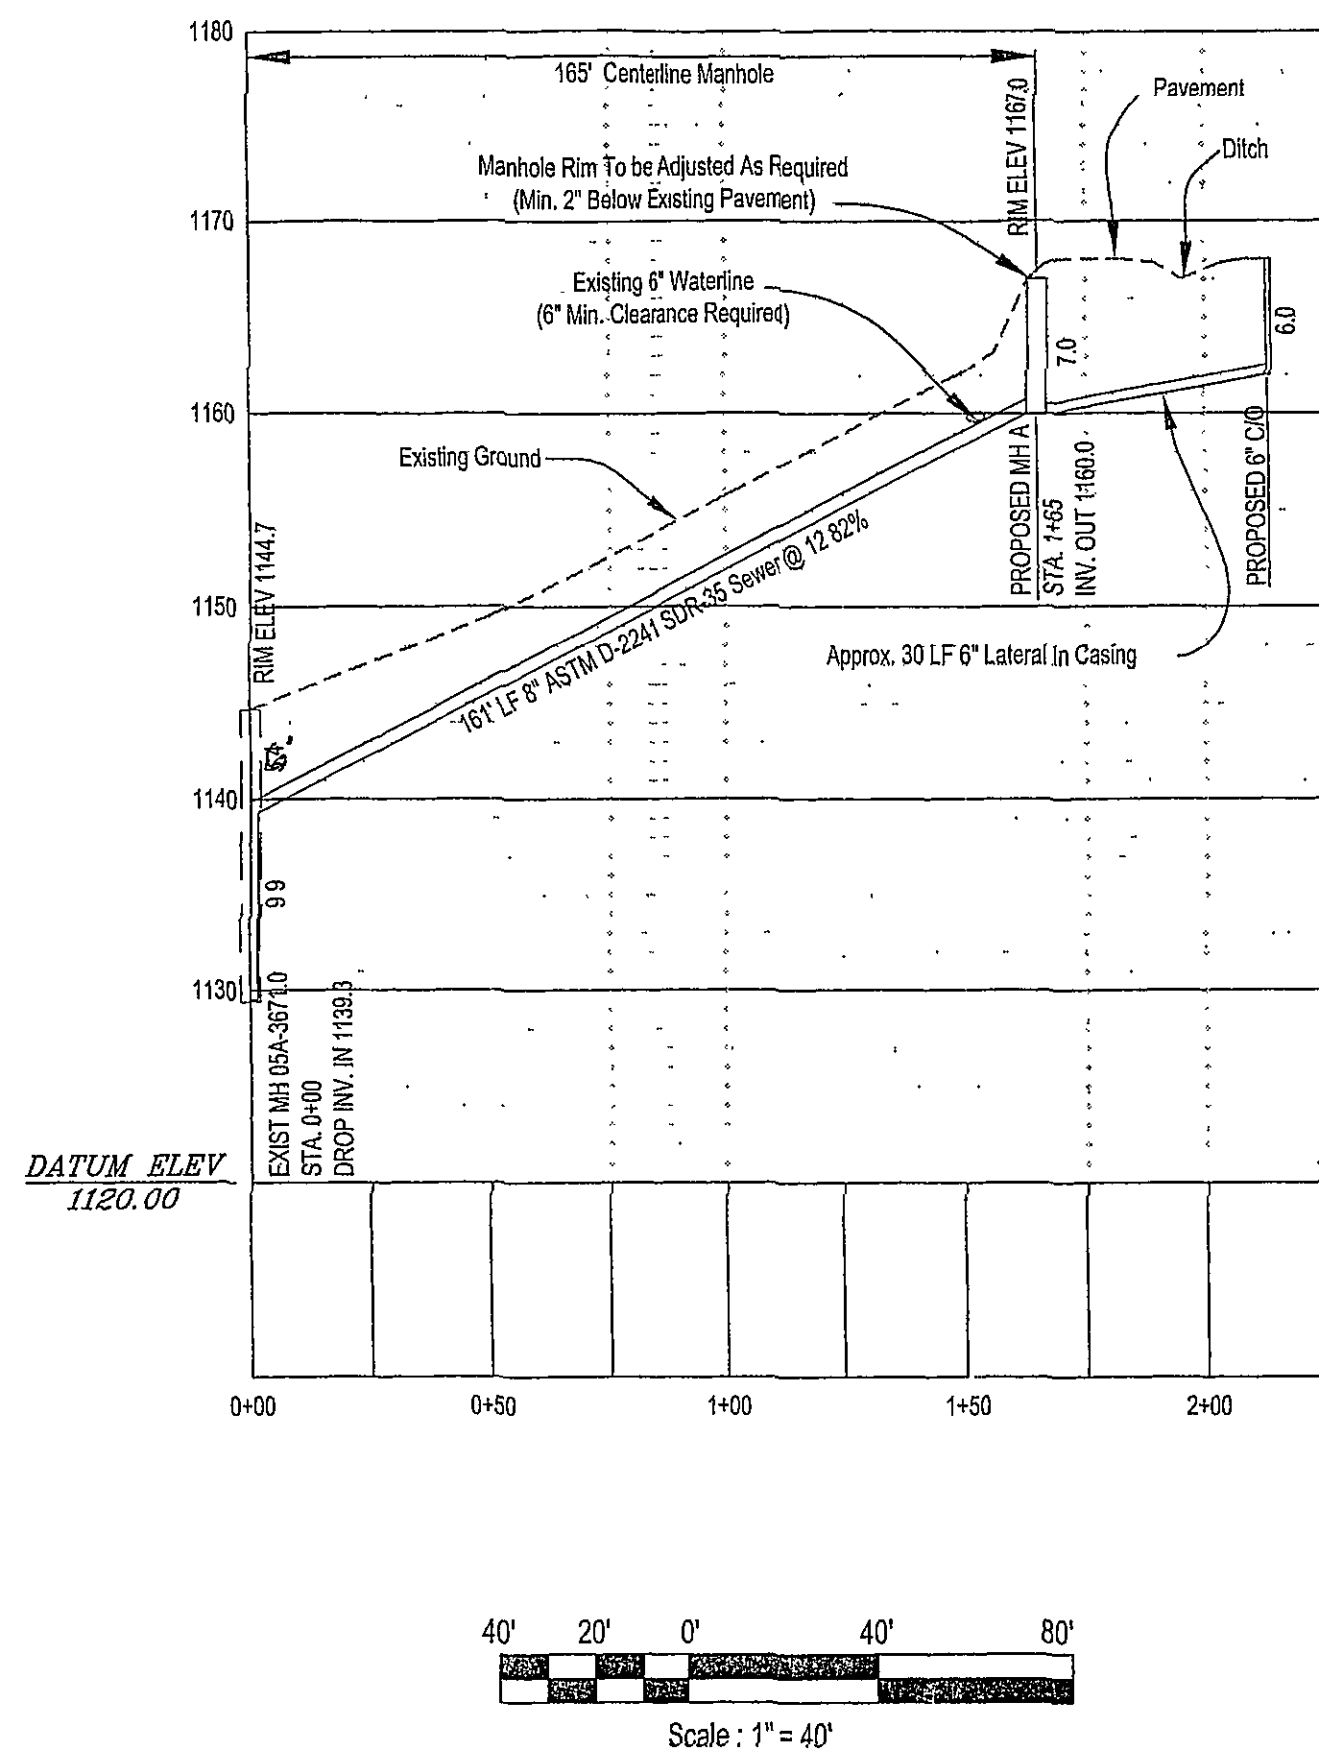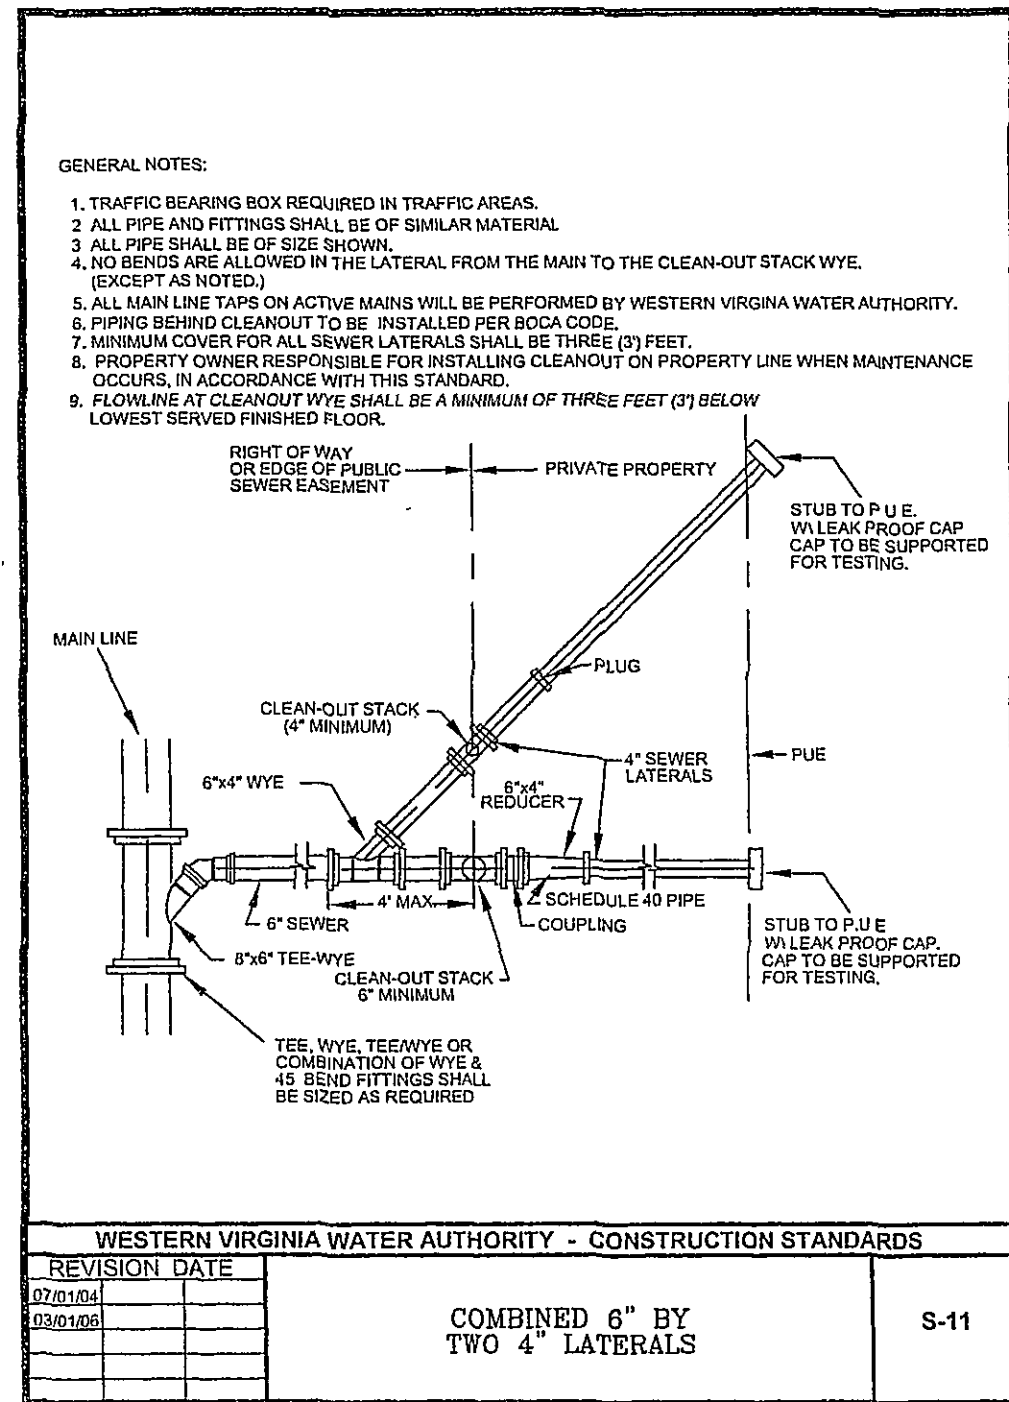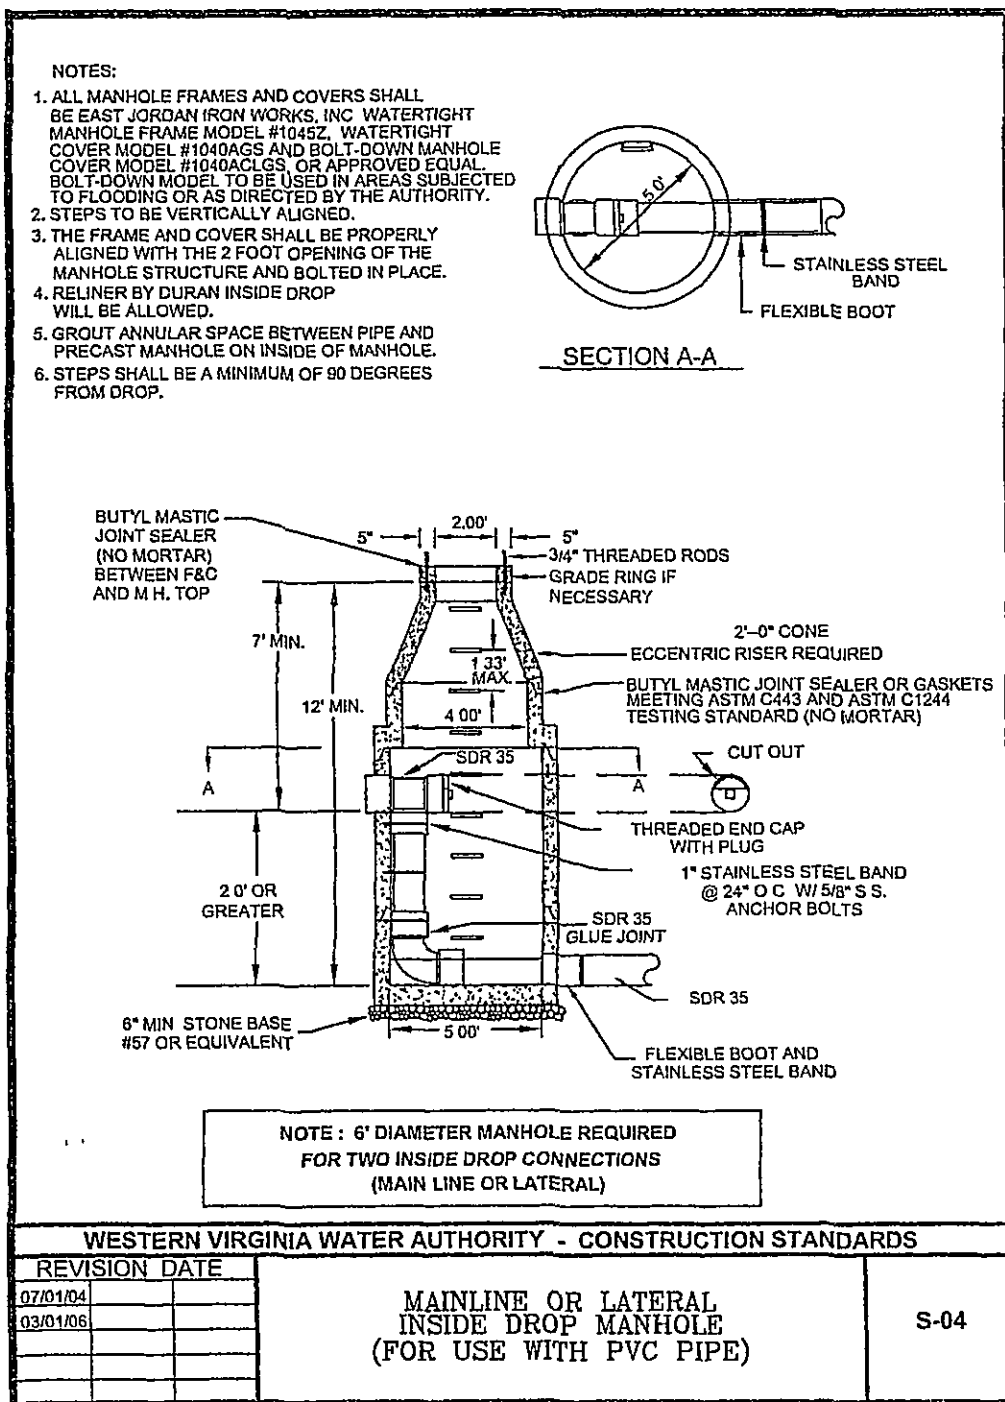

NOTES:

1. ALL WORK SHALL CONFORM TO WESTERN VIRGINIA WATER AUTHORITY DESIGN & CONSTRUCTION STANDARDS LATEST EDITION.