
\mathcal{O}

 \supset

 \square

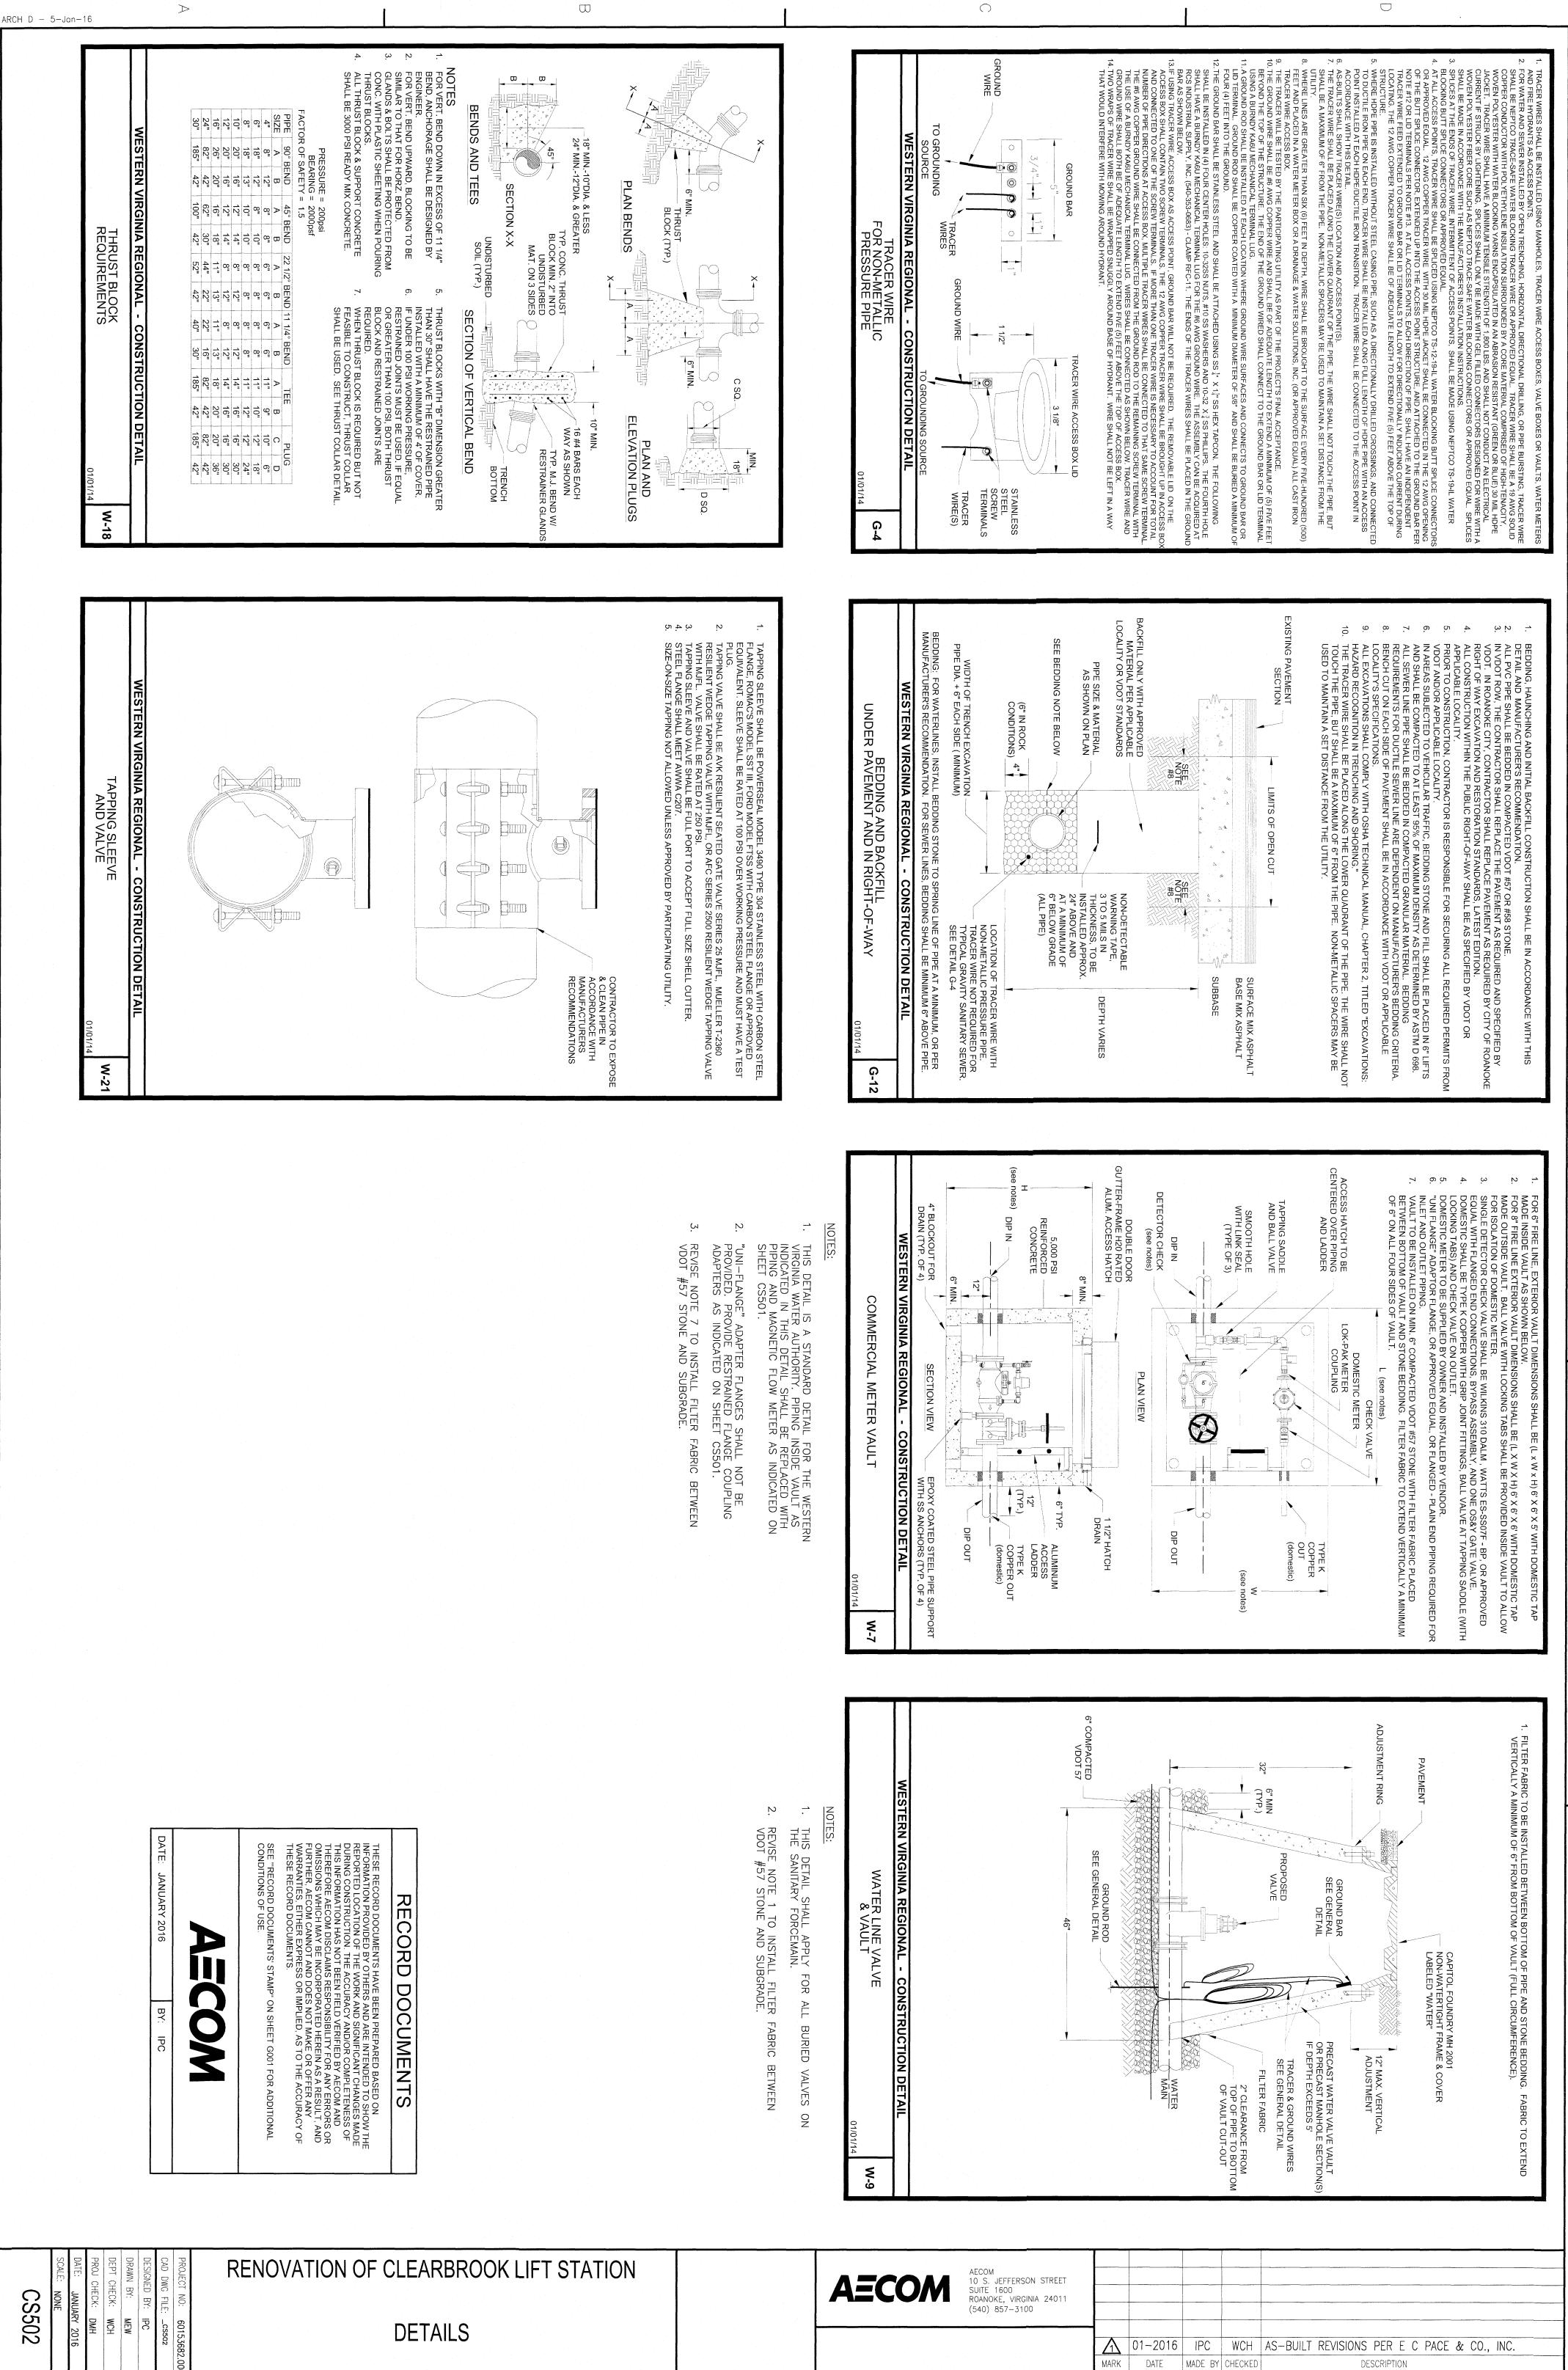

REVISIONS

 \Box