


PROJECT LOCATION MAP

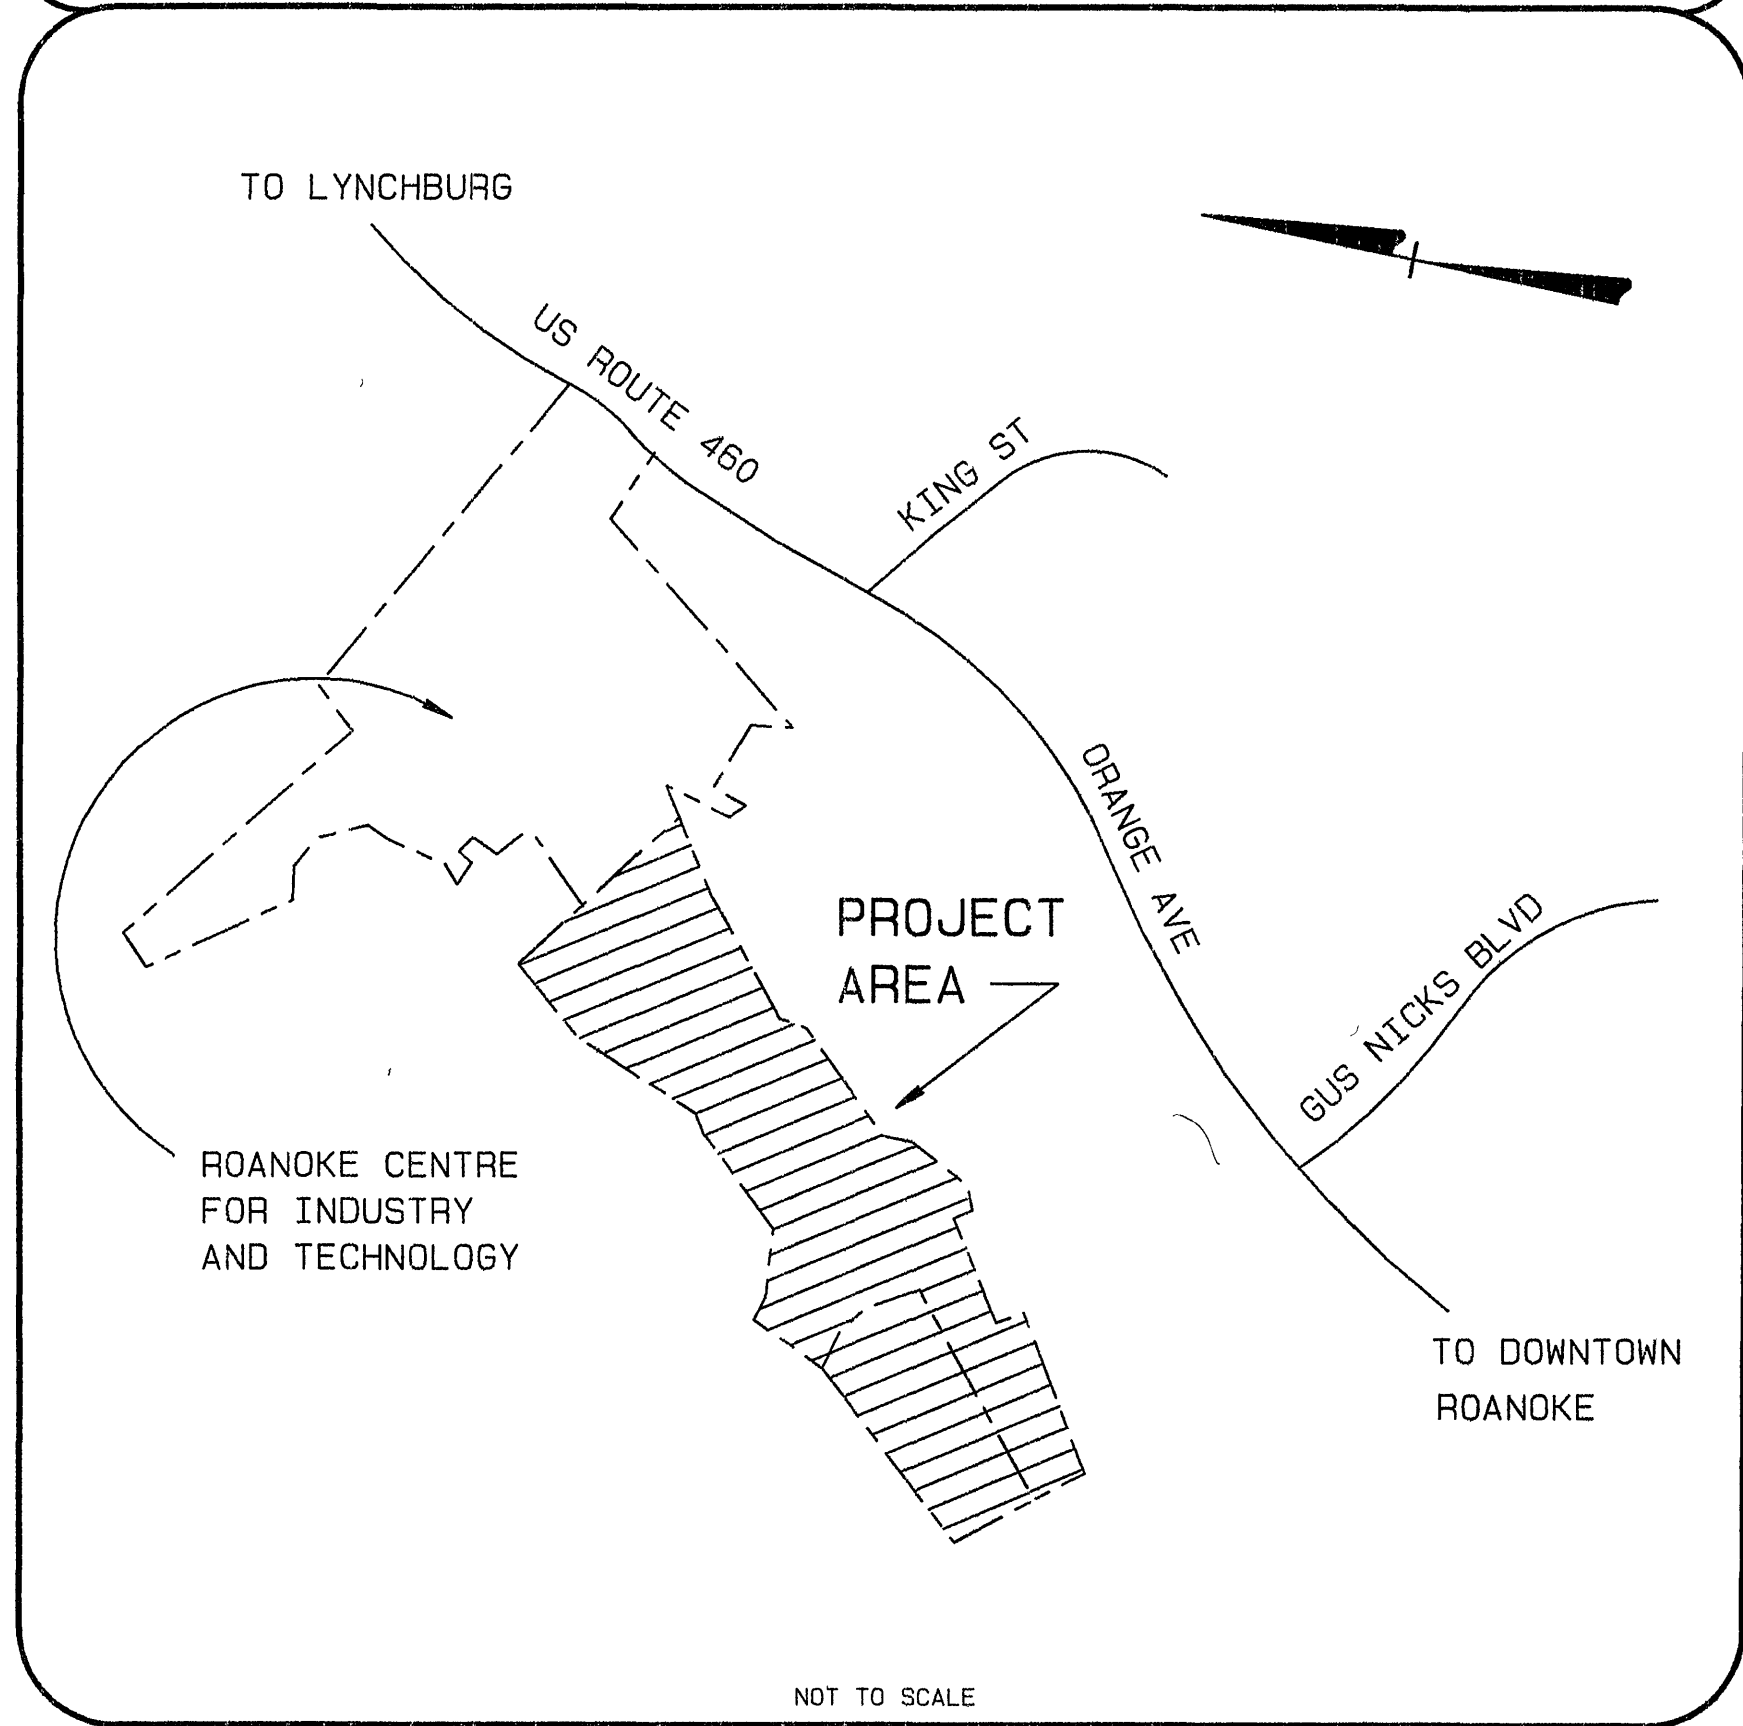

OFFICE OF CITY ENGINEER
ROOM 350
MUNICIPAL BUILDING
215 CHURCH AVENUE, S.W.
ROANOKE, VIRGINIA 24011

INDEX OF SHEETS

- 1 TITLE
- 2 SUMMARY OF QUANTITIES
- 3 ABBREVIATIONS & LEGEND
- 4 SHEET INDEX
- 5 PLAN & PROFILE
- 6 PLAN & PROFILE
- 7 PLAN & PROFILE
- 8 NOT USED
- 9 NOT USED
- 10 NOT USED
- 11 NOT USED
- 12 INVERTED SIPHON OUTLET CHAMBER DETAILS
- 13 INVERTED SIPHON INLET CHAMBER DETAILS

CONSULTING ENGINEERS



CONSULTING ENGINEERS
SURVEYORS
701 FIRST STREET
ROANOKE, VIRGINIA

COMMISSION NUMBER: 1165B

PROJECT NAME

SANITARY SEWER EXTENSION
ROANOKE CENTRE FOR INDUSTRY
AND TECHNOLOGY
CITY OF ROANOKE, VIRGINIA

PROJECT NUMBER: 6209

DSG	DESCRIPTION	DELETE SHEETS 8-11	5-17-94
REVISION BY			DATE
REVISION BY	DESCRIPTION		DATE
REVISION BY	DESCRIPTION		DATE
REVISION BY	DESCRIPTION		DATE

APPROVED FOR CONSTRUCTION

ROANOKE CITY ENGINEER	DATE
DIRECTOR OF PUBLIC WORKS	DATE
DIRECTOR OF PUBLIC UTILITIES AND OPERATIONS	DATE
	DATE
	DATE

ADVERTISED DATE:

SET NUMBER:

SHEET NUMBER: 1 OF 13

RECORD DRAWING

from
Tinker Creek Low
Towards RCIT
Thru fields
RCIT
#6209

325
317

1994
722
723
725