


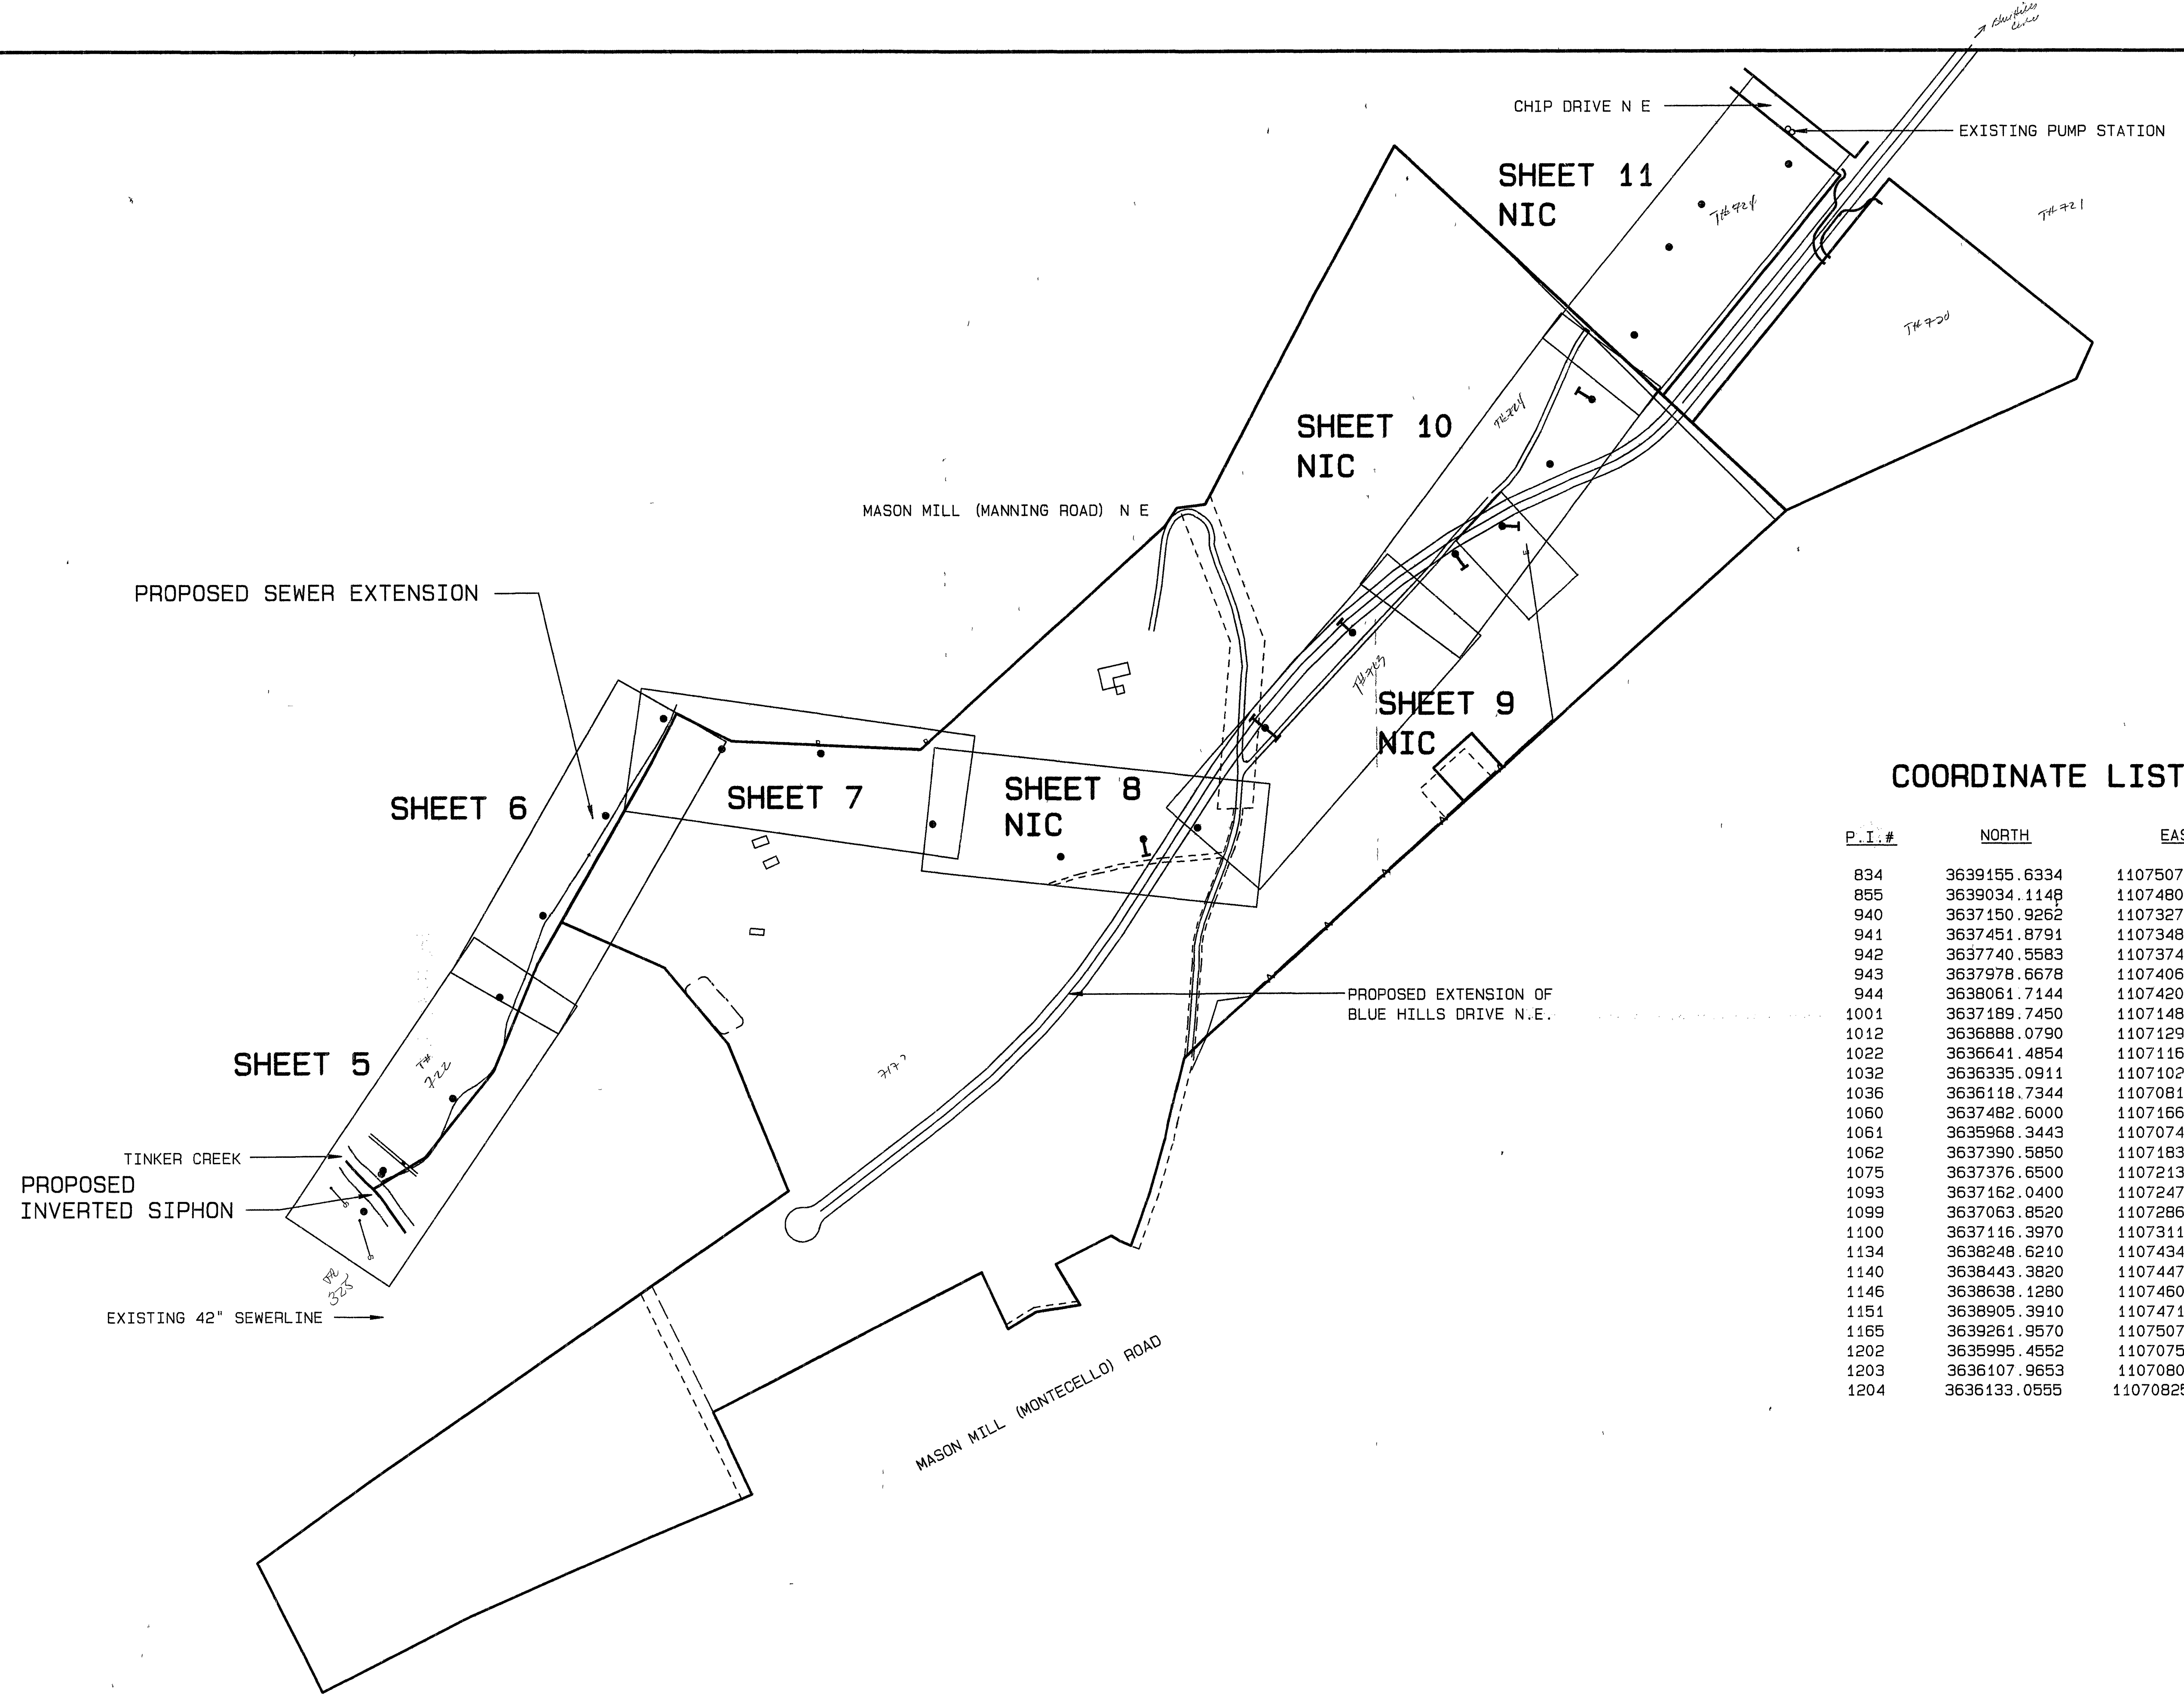


COORDINATE LIST

P.I.#	NORTH	EAST
834	3639155.6334	11075072.3009
855	3639034.1148	11074808.9889
940	3637150.9262	11073278.8534
941	3637451.8791	11073483.2981
942	3637740.5583	11073749.2610
943	3637978.6678	11074061.3121
944	3638061.7144	11074203.7289
1001	3637189.7450	11071486.7700
1012	3636888.0790	11071296.6271
1022	3636641.4854	11071164.7766
1032	3636335.0911	11071022.2312
1036	3636118.7344	11070811.3180
1060	3637482.6000	11071662.9600
1061	3635968.3443	11070740.0624
1062	3637390.5850	11071838.9600
1075	3637376.6500	11072138.6500
1093	3637162.0400	11072476.2400
1099	3637063.8520	11072863.6200
1100	3637116.3970	11073114.1700
1134	3638248.6210	11074348.4000
1140	3638443.3820	11074476.5200
1146	3638638.1280	11074604.6300
1151	3638905.3910	11074710.1900
1165	3639261.9570	11075070.3400
1202	3635995.4552	11070752.9077
1203	3636107.9653	11070806.2155
1204	3636133.0555	11070825.2788

RECORD DRAWING



DESIGNED	JMB
DRAWN	REH
APPROVED	SHM

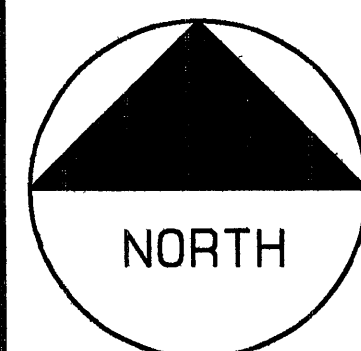

REVISION	DATE	DESCRIPTION	BY	APP
1	5-17-94	DELETE SHEETS 8-11	DSG	WJJ

DATE
JUNE
1992

COMM.
1165B

SANITARY SEWER EXTENSION
ROANOKE CENTRE FOR INDUSTRY & TECHNOLOGY
SHEET INDEX
CITY OF ROANOKE, VIRGINIA

SCALE HORIZ 1"=250'

SHEET
4
PLAN NO.
6209

DTM2.D.1165B.4