


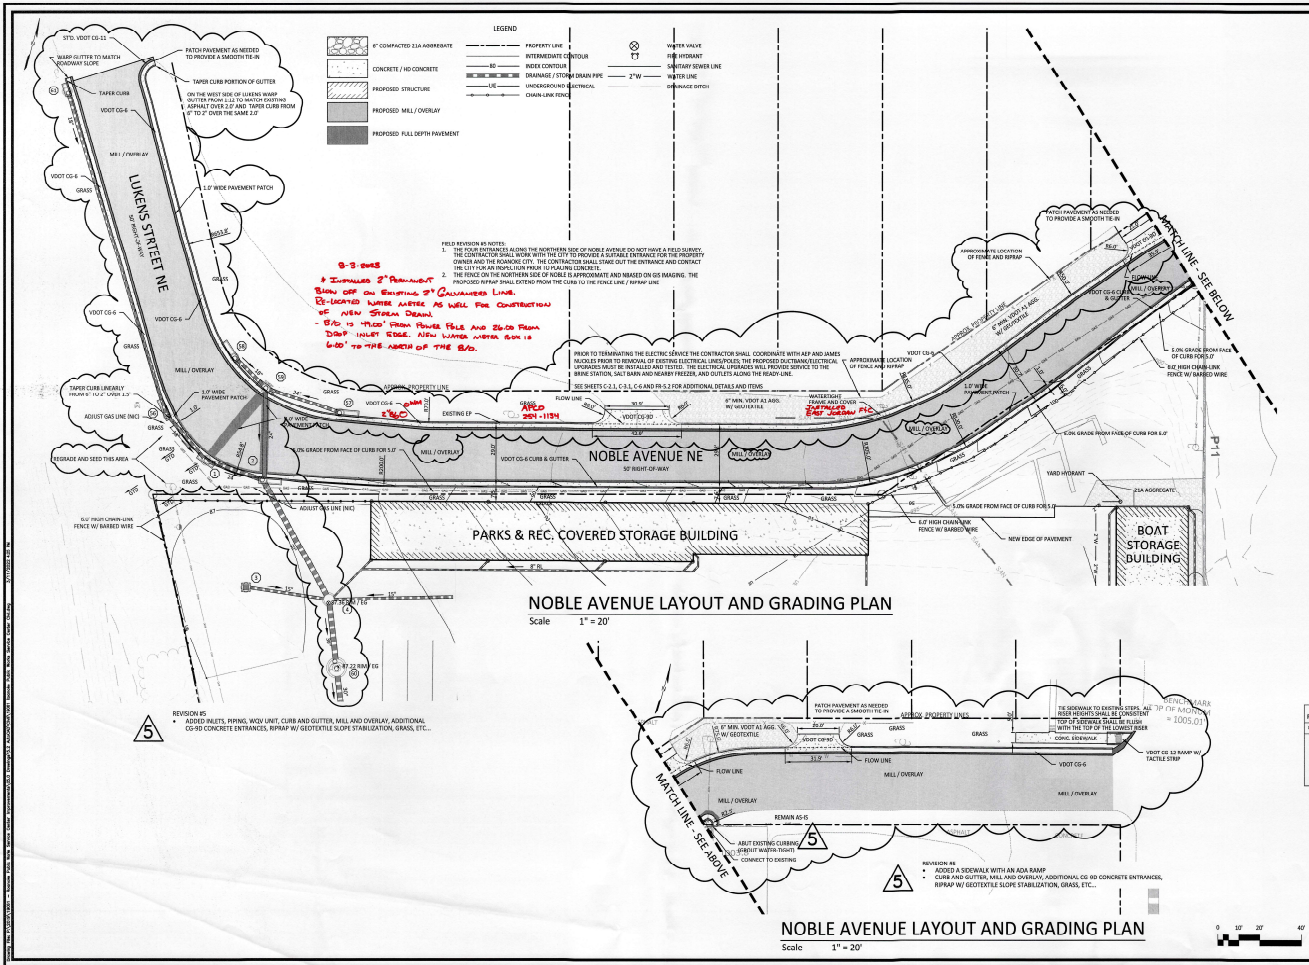

DATE: NOV. 3, 2019
 REVISIONS:
 A JAN. 17, 2021
 A MAR. 17, 2021
 A MAR. 31, 2021
 A FEB. 28, 2022

HUGHES ASSOCIATES ARCHITECTS & ENGINEERS
 1802 Courtyard Road
 Roanoke, Virginia

PUBLIC WORKS SERVICE CENTER IMPROVEMENTS CITY OF ROANOKE
 1802 Courtyard Road
 Roanoke, Virginia

DRAWN BY: JSE
 CHECKED BY: JSE
 FIELD REVISION #5 LAYOUT AND GRADING PLAN
 City of Roanoke Planning, Building & Development COMPREHENSIVE DEVELOPMENT PLAN
 FIELD REVISION APPROVED
 By: Kim H. Hester
 09/09/2022

COMMISSION No. 15001
 SHEET FR-5.2
 1/2" = 1' SCALE

APPROVED
 Kim H. Hester
 City of Roanoke

COMMISSION No. 15001
 SHEET FR-5.2
 1/2" = 1' SCALE