


MELROSE AVE. N. W.

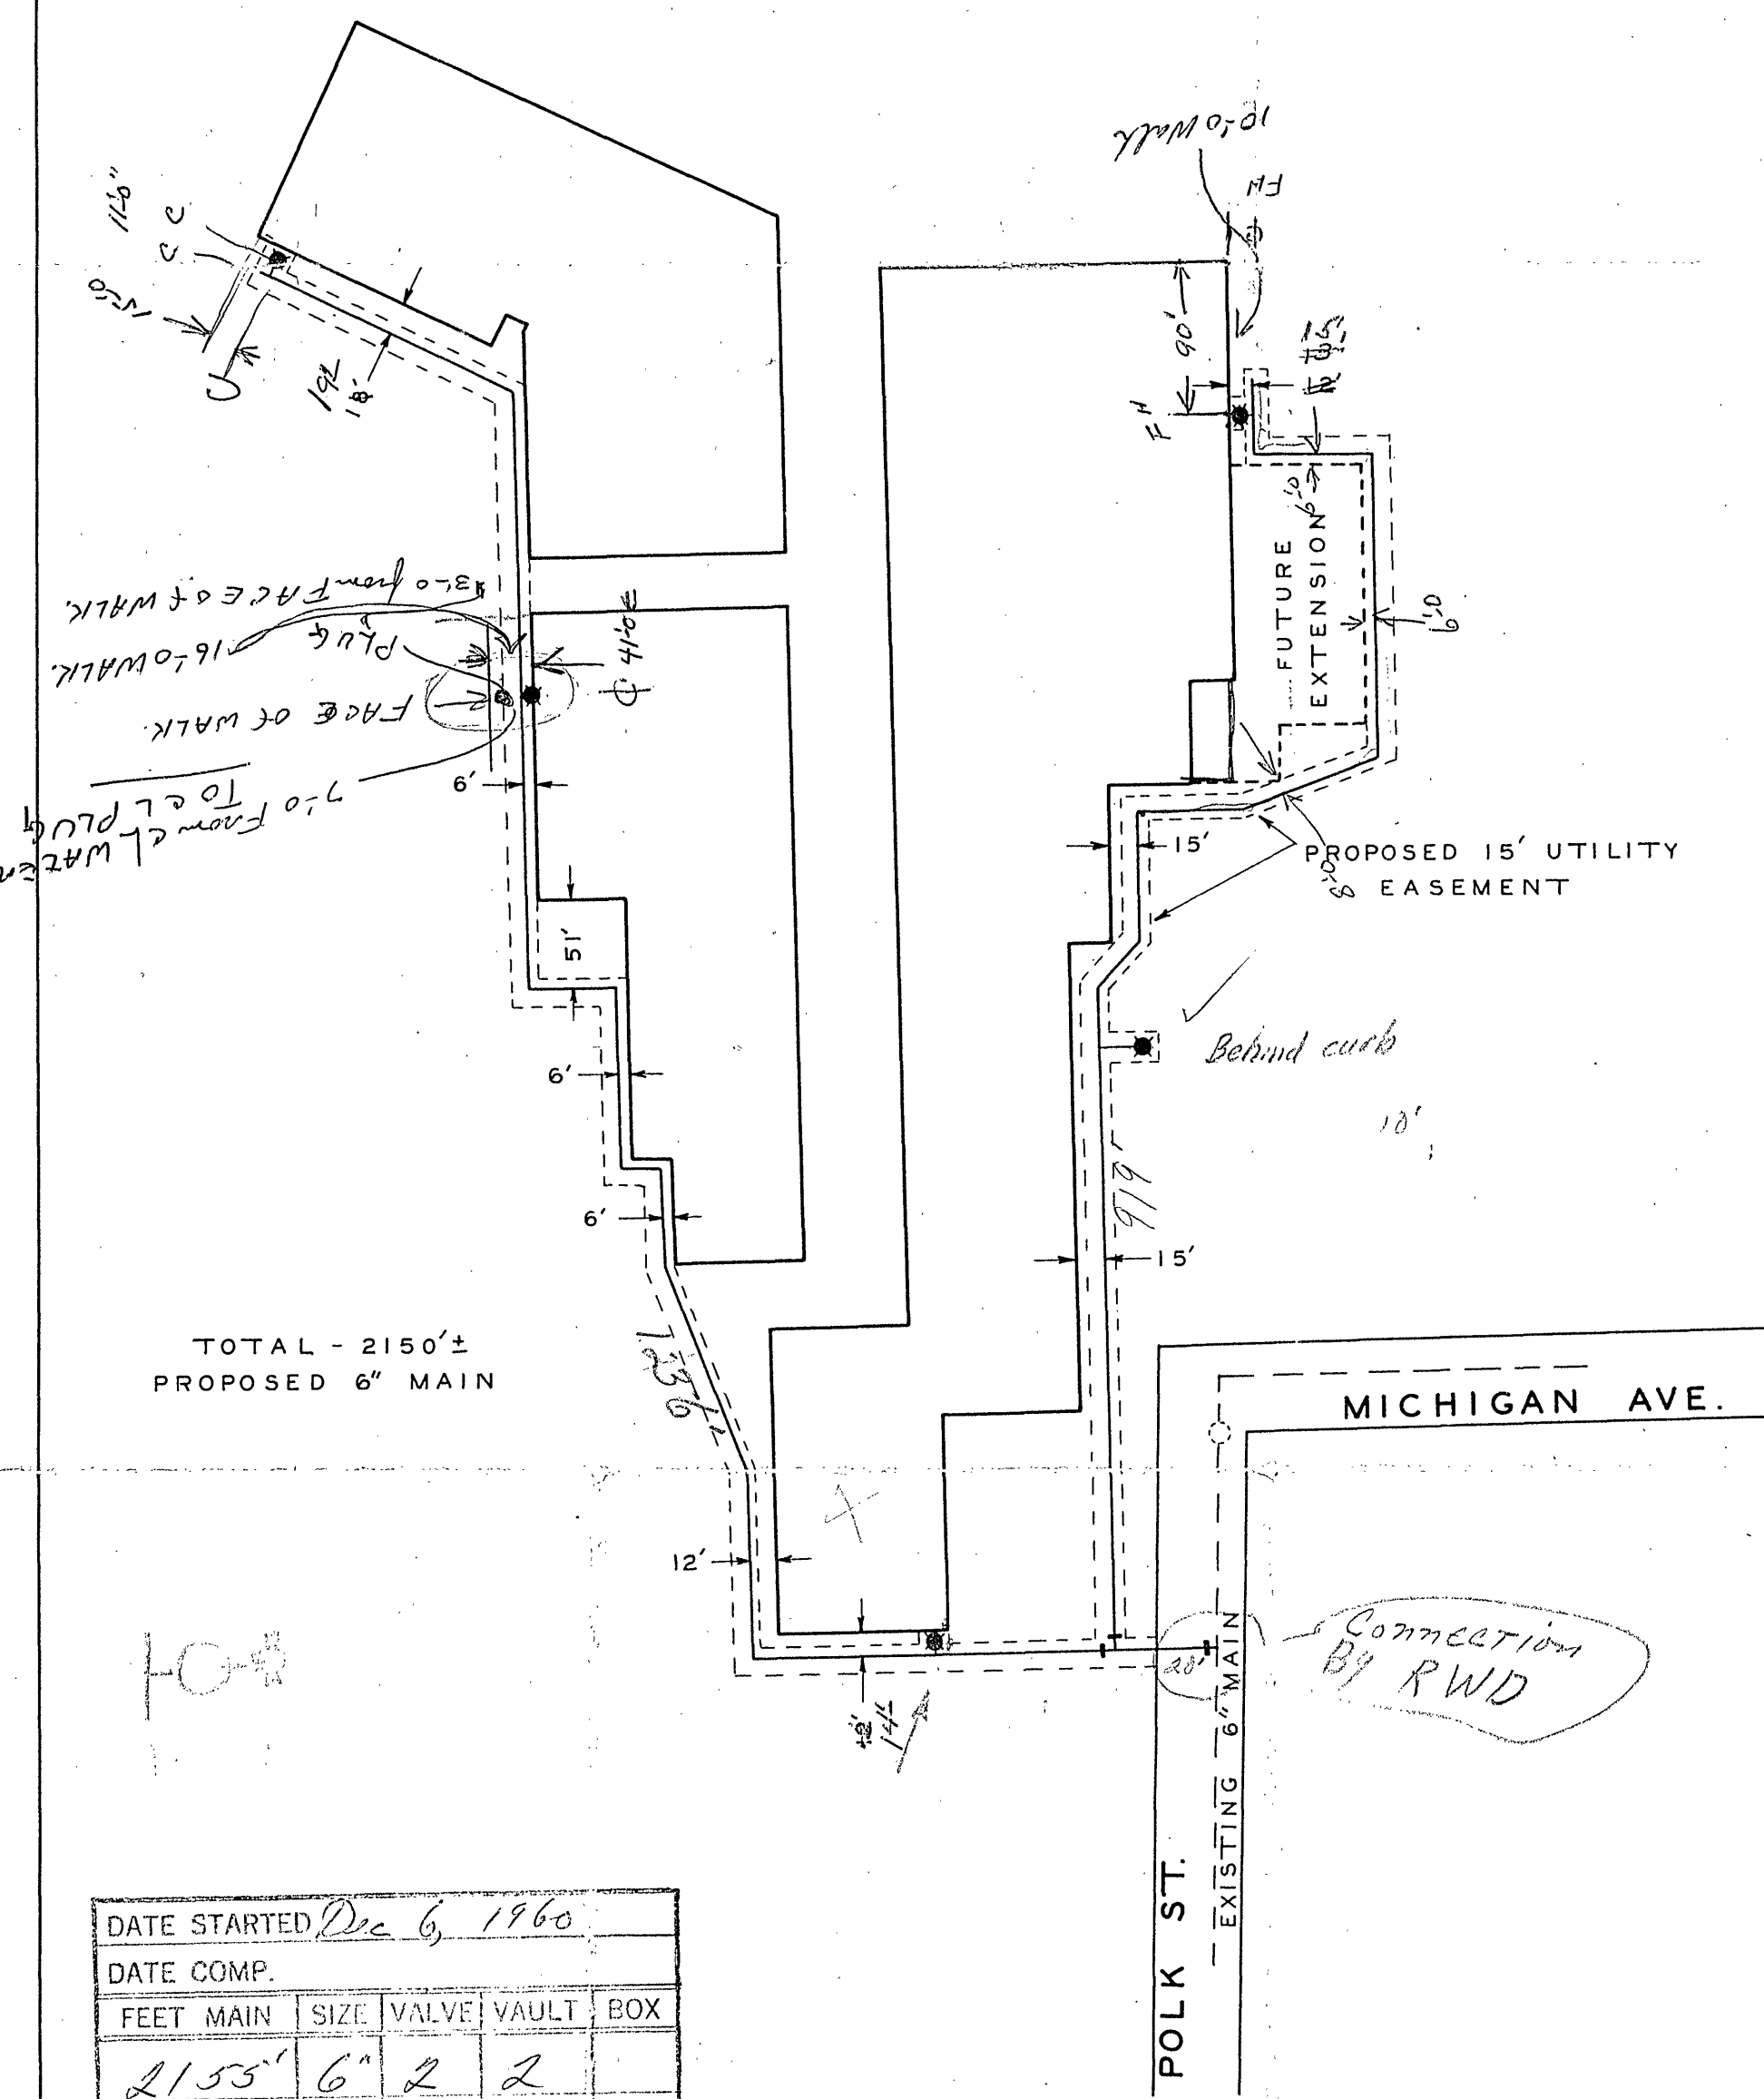

TOTAL - 2150'±
PROPOSED 6" MAIN

DATE STARTED					Dec 6, 1960	
DATE COMP.						
FEET MAIN	SIZE	VALVE	VAULT	BOX		
2155'	6"	2	2			
I. H. COMP.						
F. H. STUD ONLY	5	6"	5	5		
SERV. INS. BY.						
MAINS INS. BY. A. J. Connor						
NO. 3/4" SERV. INS. None						
CITY OR CO. City						
DEPT. INSP. D. J. Mapey						

366-6368
 Russ Bender
 Grand Food Shop.
WATER DEPARTMENT
CITY OF ROANOKE, VA.
ROANOKE-SALEM SHOPPING CENTER
 SCALE - 1" = 100'
 DRAWN BY N.H.C. OCT. 17, 1960