


**PROFILE**  
SCALE: 1"=20' HORIZ.  
1"=10' VERT.

As-Built  
WATER MAP NO. 213,224

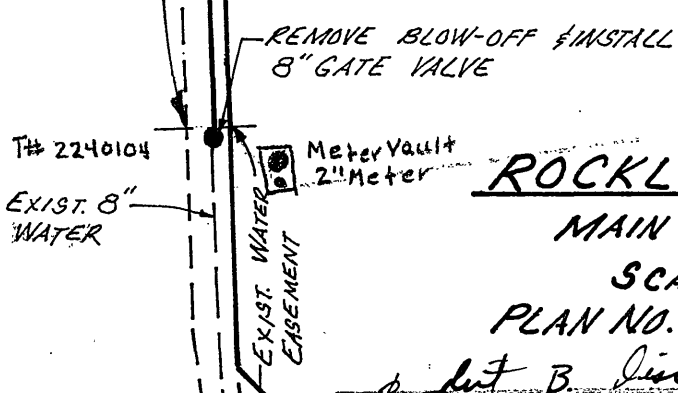

**ROCKLAND DRIVE**  
MAIN EXTENSION  
SCALE: 1"=100'  
PLAN NO. 81-03 - MARCH 30, 1981

*Robert B. Jinn*  
DIRECTOR UTILITIES & OPERATIONS

*Richard B. Bunn*  
CITY ENGINEER OF ROANOKE, VA

*Thomas J. Brady*  
DIRECTOR OF PUBLIC WORKS

*William G. Koby*  
AGENT FOR ROANOKE PLANNING COMM.

30 March, 81  
DATE

30 MAR 81  
DATE

3-30-81  
DATE

30 MARCH 1981  
DATE

DATE STARTED	1981
DATE COMP.	11-1981
FEET MAIN	460'±
SIZE	8"
VALVE	3
VAULT	
BOX	
F. H. COMP.	<input checked="" type="checkbox"/>
F. H. STUB ONLY	<input type="checkbox"/>
SERV. INS. BY:	
MAIN INS. BY:	
NO. 3/4" SERV. INS.	
CITY OR CO.	City
DEPT. INSP.	