


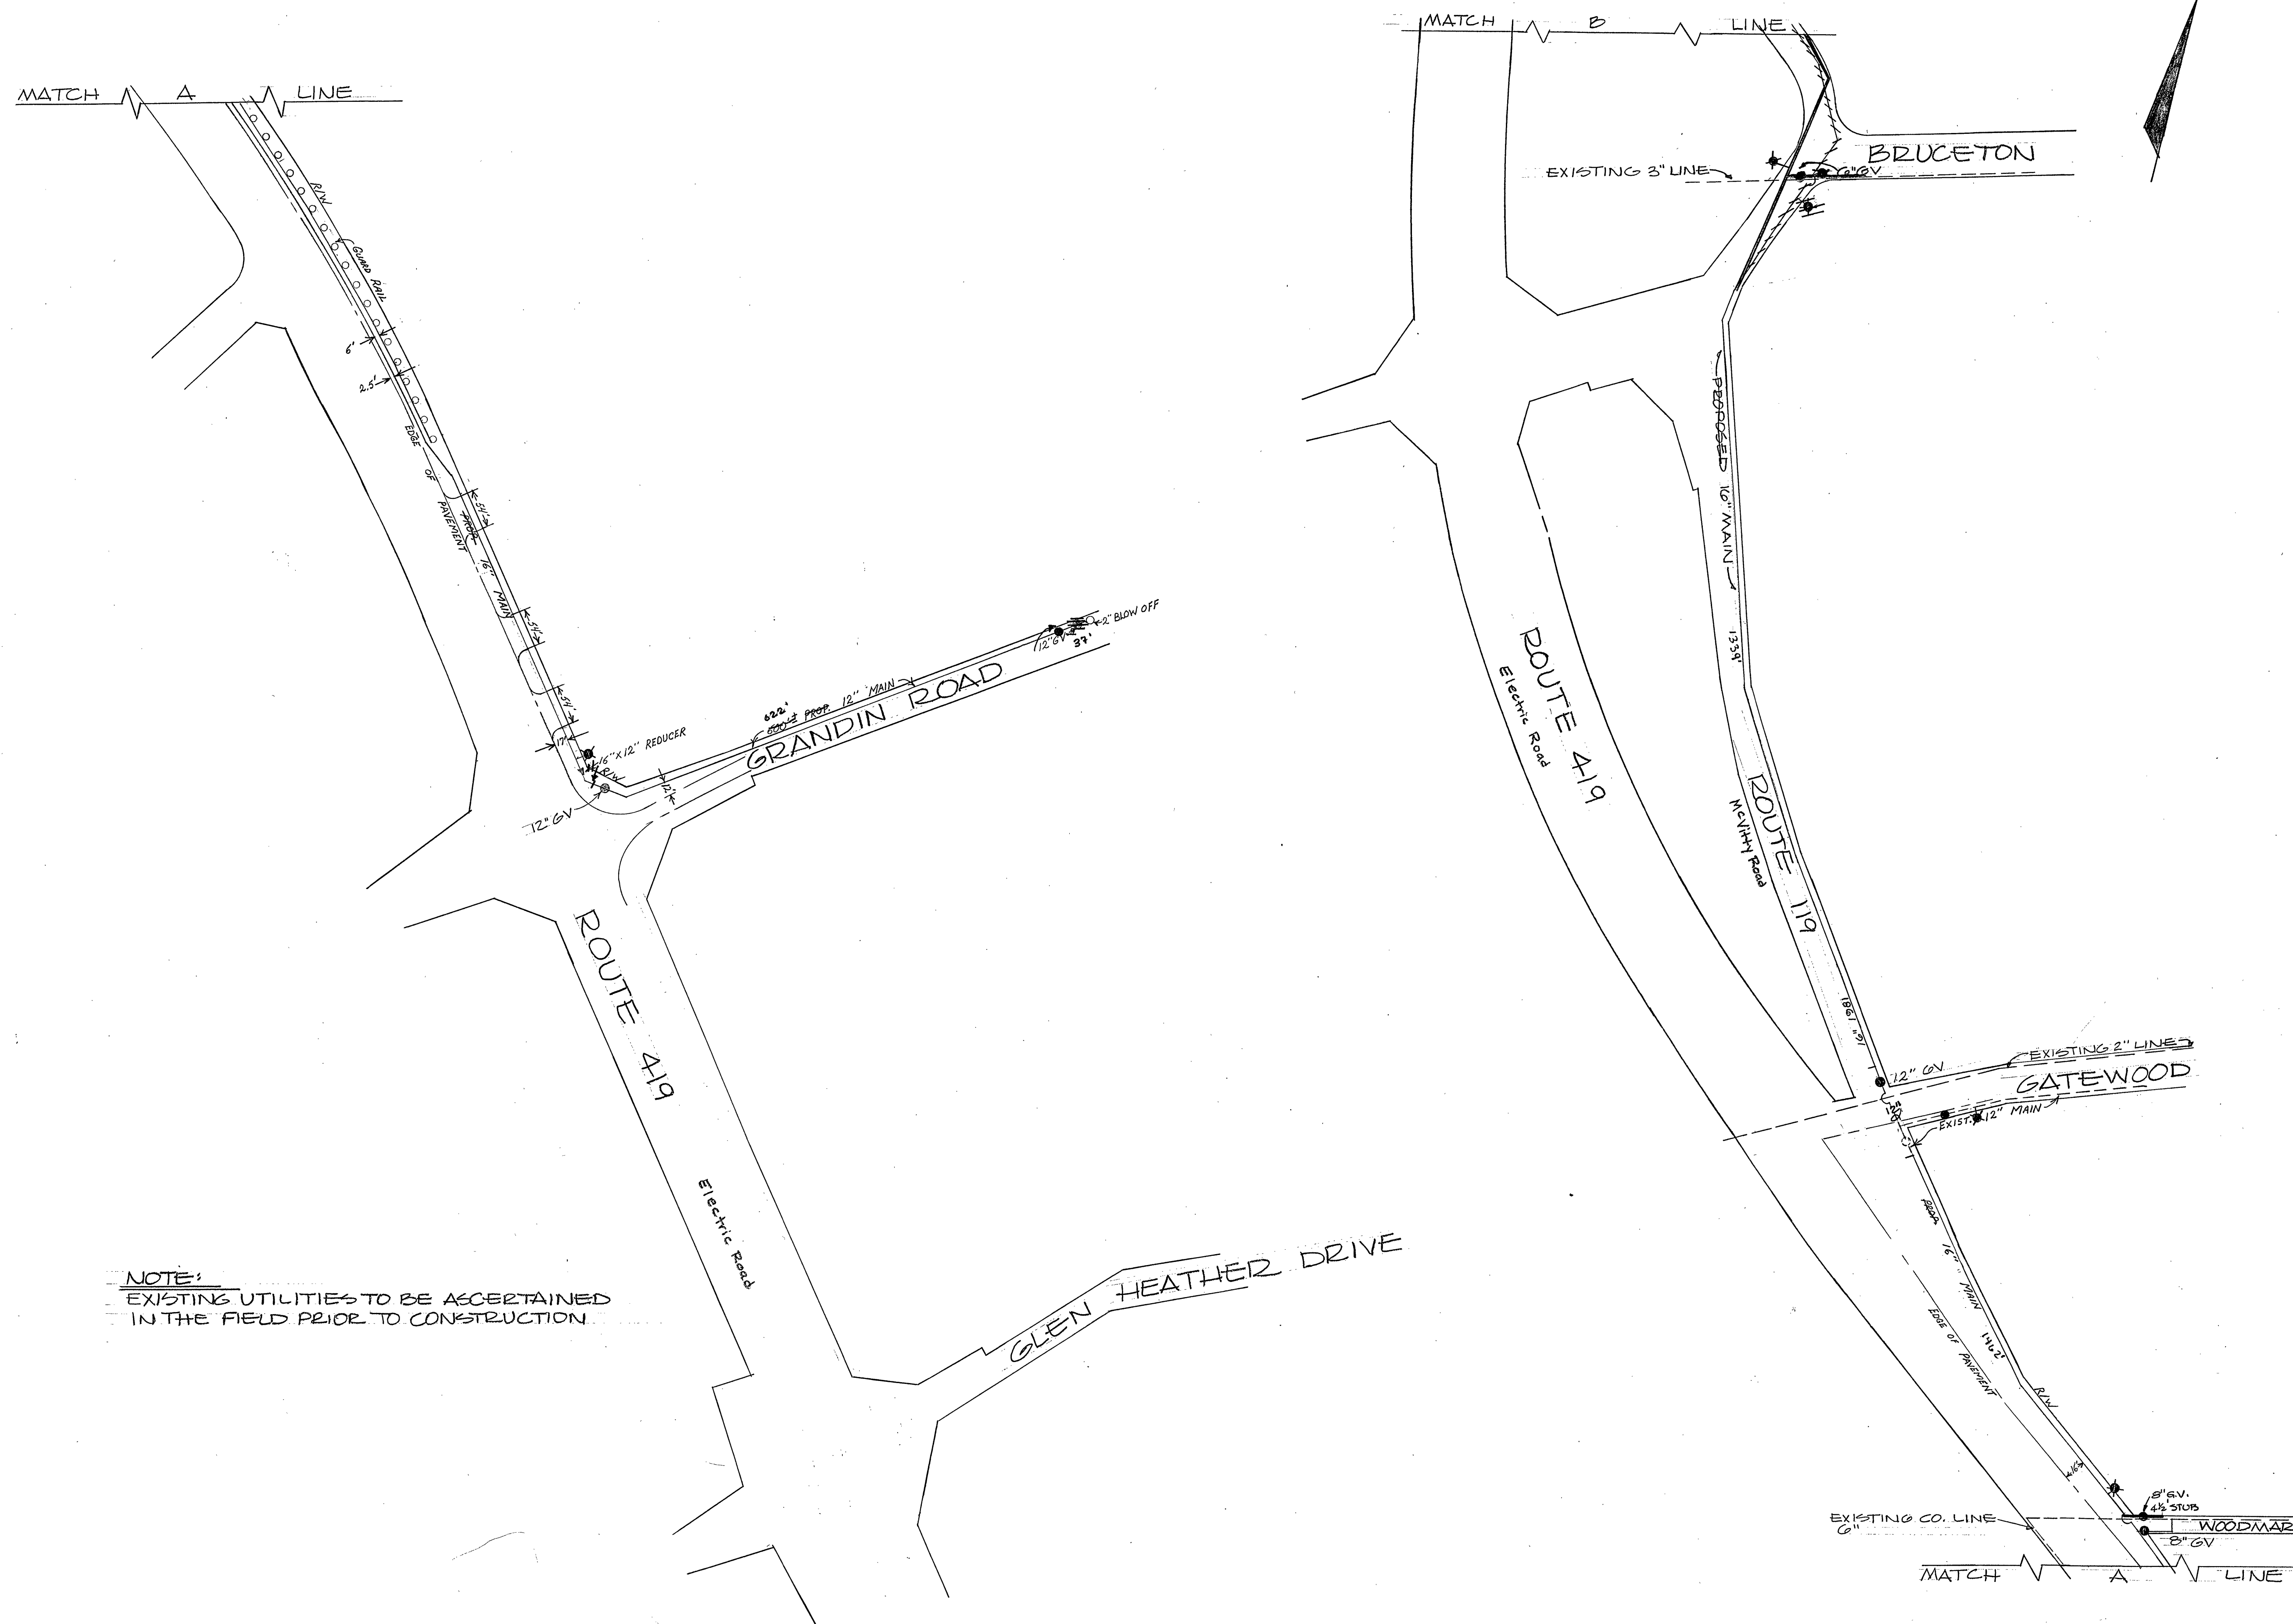

NOTE:
EXISTING UTILITIES TO BE ASCERTAINED
IN THE FIELD PRIOR TO CONSTRUCTION.

DATE STARTED	5-1981
DATE COMPLETED	
PROJECT NO.	
BY	
CHECKED BY	
APPROVED BY	
DATE	
PROJECT NO.	
PROJECT NAME	
CITY	

AS-BUILT

DATE	Rev.	DESCRIPTION
9/7/80	1	AS-BUILT
9/7/80	2	AS-BUILT
9/7/80	3	AS-BUILT
9/7/80	4	AS-BUILT
9/7/80	5	AS-BUILT
9/7/80	6	AS-BUILT
9/7/80	7	AS-BUILT
9/7/80	8	AS-BUILT
9/7/80	9	AS-BUILT
9/7/80	10	AS-BUILT

DATE	Rev.	DESCRIPTION
9/7/80	1	AS-BUILT
9/7/80	2	AS-BUILT
9/7/80	3	AS-BUILT
9/7/80	4	AS-BUILT
9/7/80	5	AS-BUILT
9/7/80	6	AS-BUILT
9/7/80	7	AS-BUILT
9/7/80	8	AS-BUILT
9/7/80	9	AS-BUILT
9/7/80	10	AS-BUILT

WATER MAIN EXTENSION
ROUTE 419 LOOP
ROANOKE, VIRGINIA
CITY OF ROANOKE
OFFICE OF CITY ENGINEER
ROANOKE, VIRGINIA
CONTRACT NO. 1915