


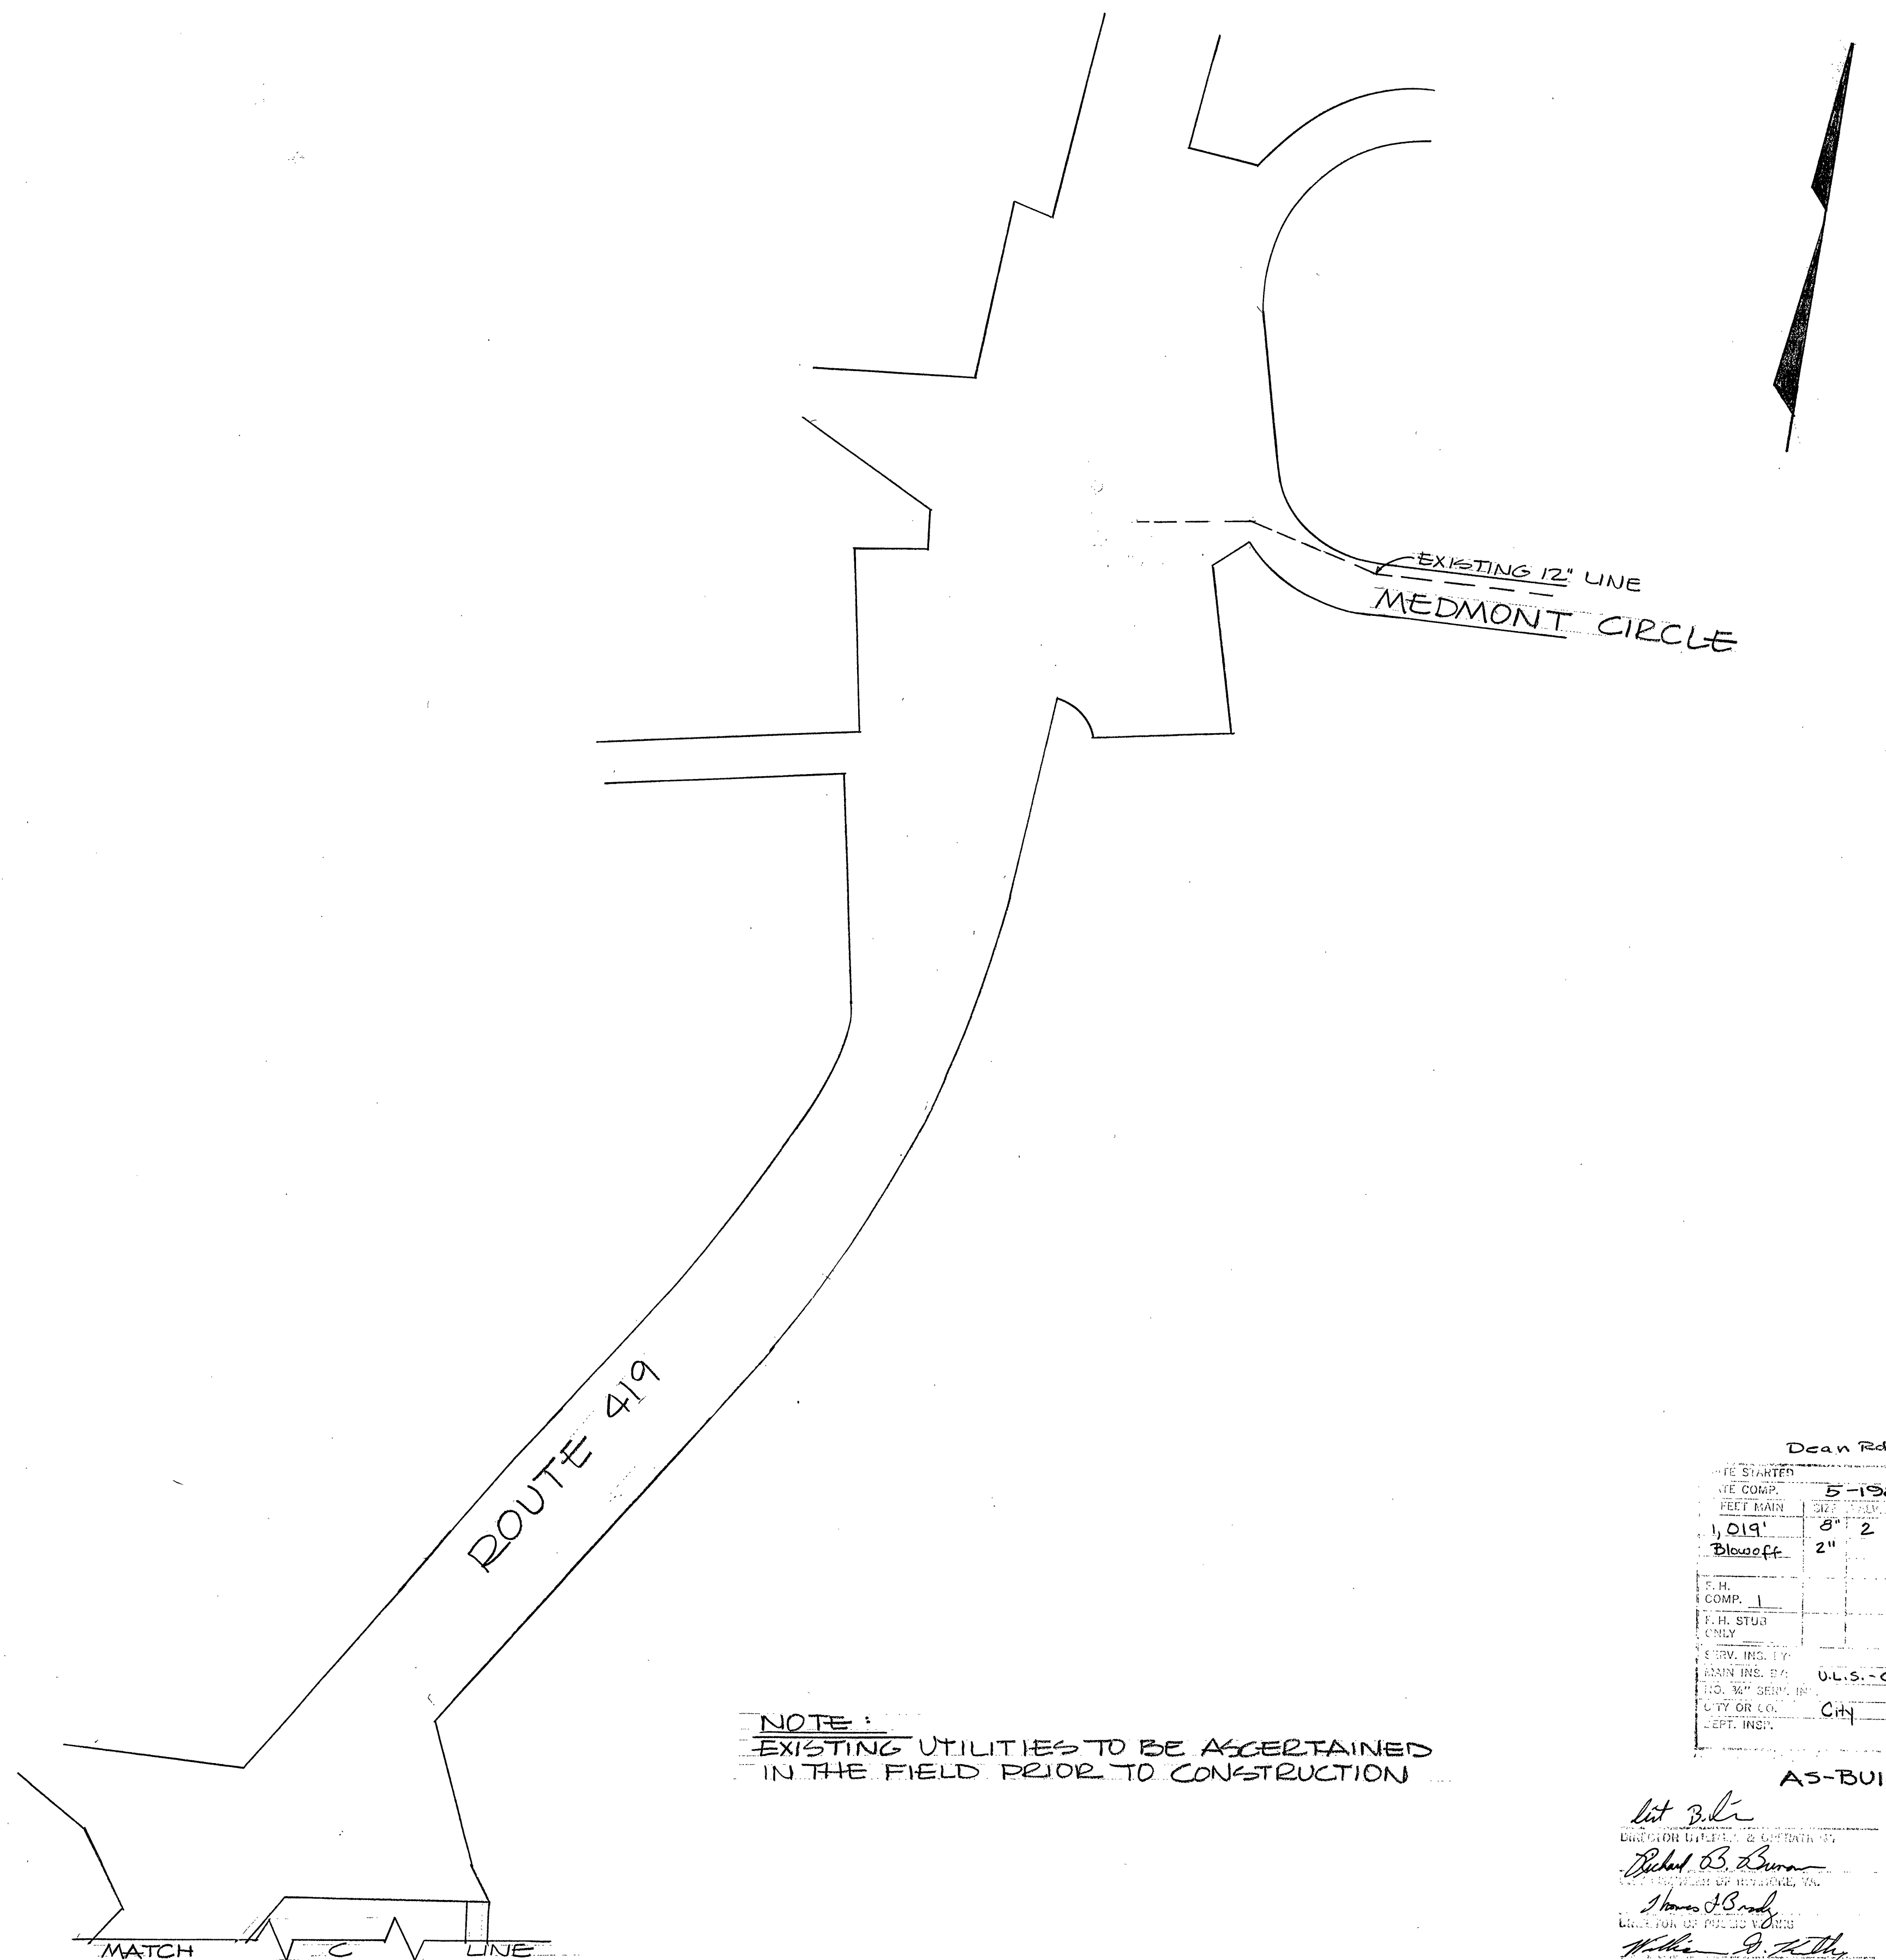

NOTE:
EXISTING UTILITIES TO BE ASCERTAINED
IN THE FIELD PRIOR TO CONSTRUCTION

Dean Rd.	
FIVE STARTER FIVE COMP. FIVE TRAIN 1, 019 Blowoff	5-1981 8" 2 2 2" F.H. COMP. 1 F.H. STUD ONLY 3 SERV. INCL. Y 25 MIN INS. P4 100. 90" BEAM IN CITY OR CO. EPT. INC.
	U.S. - Calvin Dams City

AS-BUILT

List 3 LABORER, 11111 & 11111A ST Richard B. Brown 11111 ST & 11111A ST Thomas B. Brown 11111 ST & 11111A ST William B. Brown 11111 ST & 11111A ST	Sept. 9, 1980 DATE 9 SEP 80 DATE 9-9-80 DATE 9/9/80 DATE
---	---

DATE	REV.	DESCRIPTION	BY
CITY ENGINEER			
WATER MAIN EXTENSION			DRAWN
ROUTE 419 LOOP			CHECKED
ROANOKE, VIRGINIA			DATE
CITY OF ROANOKE, VIRGINIA			9-24-79
FOR NO.			7915
SHEET			2
CONTRACTOR MUST VERIFY ALL DIMENSIONS			