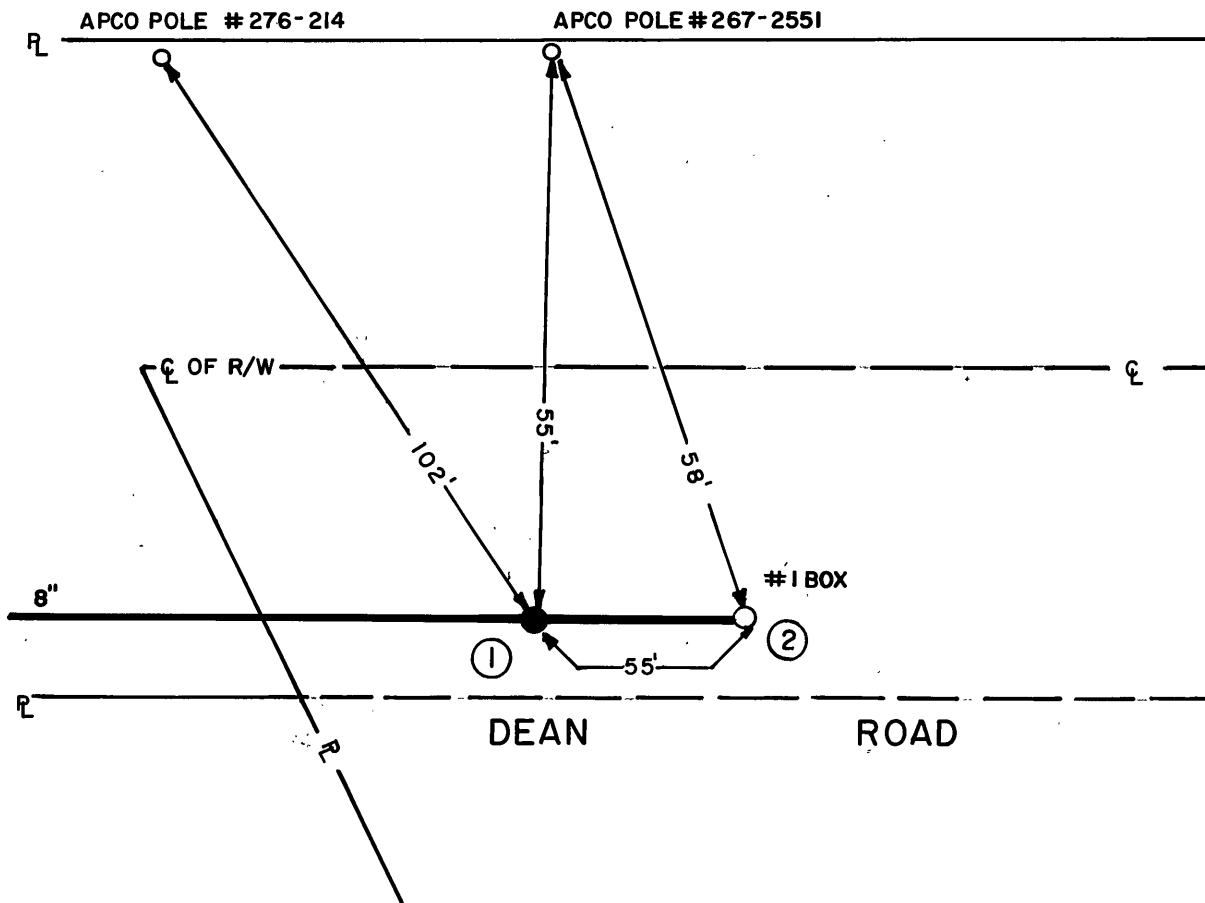
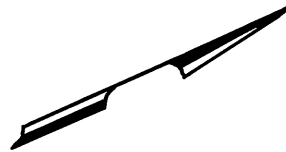


1625

[illegible]

7/93 NP

CITY OF ROANOKE - WATER DEP'T.

VALVE DIAGRAM

1625 DEAN ROAD

SEC. MAP 512

S.W.

DATE:

PAGE NO. .