


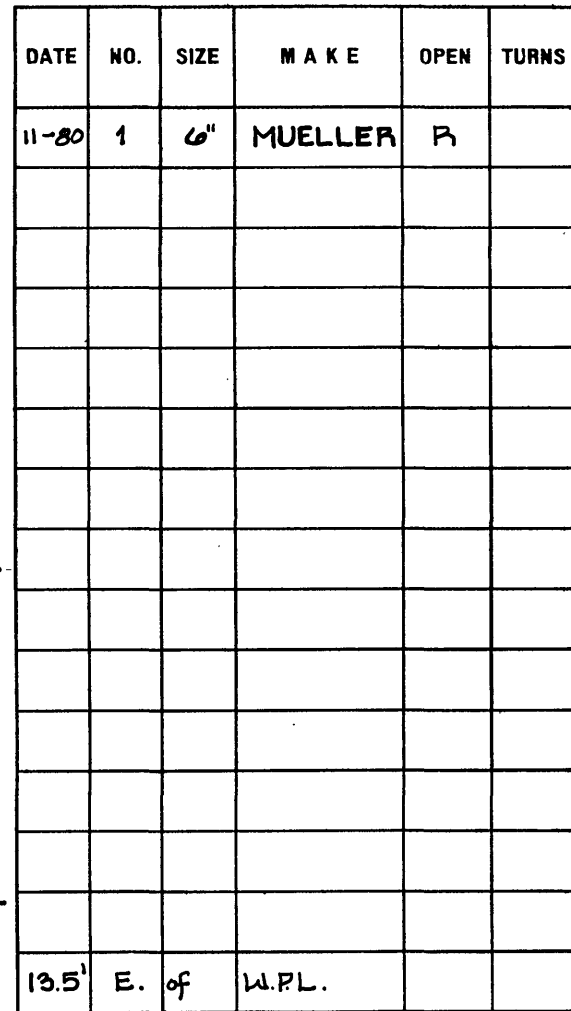

PAGE NO.

PAGE NO.