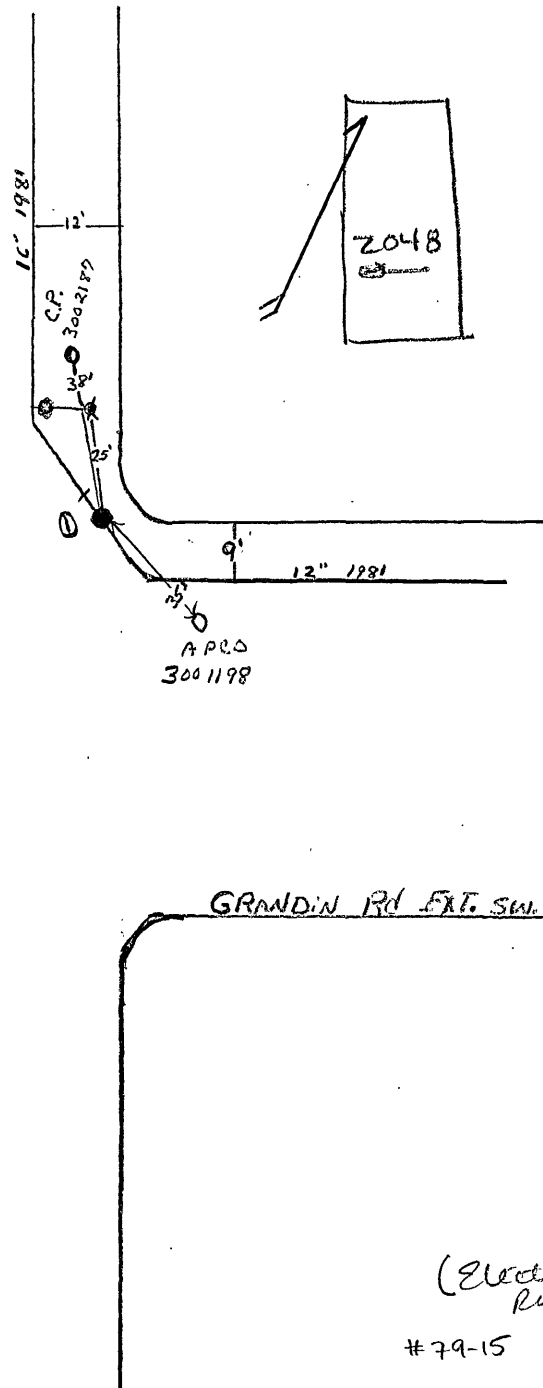


STATE RT. 419 - Electric Rd.

[illegible]

(Electric)
Rel.

79-15

CITY OF ROANOKE—WATER DEPT	
VALVE DIAGRAM	
419 1/2 Grandin Rd EXT.	
SEC. MAP	509 SW
DATE 8-81	PAGE NO.