


# SANITARY SEWER EXTENS

## ALONG U. S. RTE. 460, ROANOKE, VIRGINIA

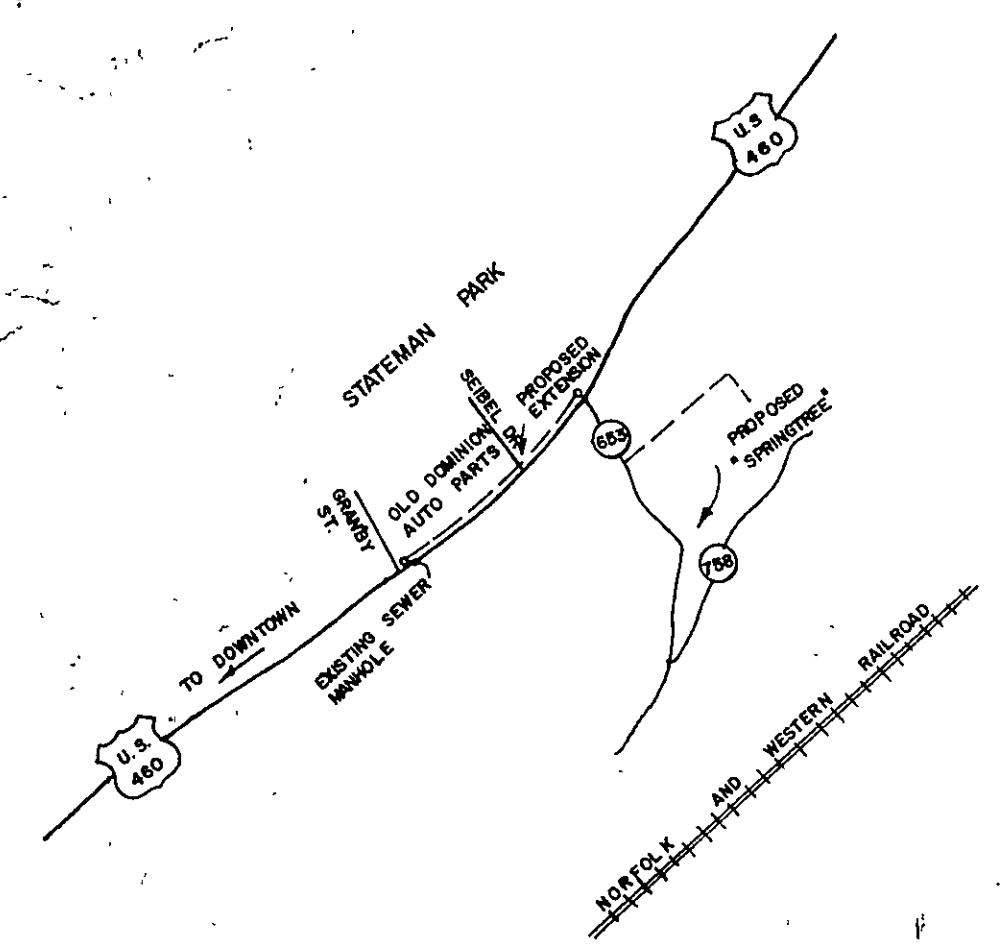

VICINITY PLAT

**NOTE:**  
SEWER LINE CONSTRUCTION TO MEET THE RULES AND REGULATIONS AND CONSTRUCTION SPECIFICATIONS AND STANDARDS OF ROANOKE COUNTY PUBLIC SERVICE AUTHORITY AS AMENDED TO DATE.

CONTRACTOR TO RESHAPE DRAINAGE DITCH ALONG NORTH SIDE OF U.S. RTE. 460, AND RETURN DITCH TO ITS ORIGINAL CONDITION AFTER CONSTRUCTION.

**T. P. PARKER & SON**  
Engineers & Surveyors  
P. O. Box 367, Drawer 473  
SALEM, VIRGINIA 24153

Phone 703 387-1153

**LETTER OF TRANSMITTAL**

DATE: November 26, 1980  
 ATTENTION: George Nevegold  
 TO: Roanoke City Engineering Dept.  
 RE: As-built sanitary sewer along U. S. Rte. 460, Roanoke, Virginia

GENTLEMEN:  
 WE ARE SENDING YOU  Attached  Under separate cover via \_\_\_\_\_ the following items:  
 Shop drawings  Prints  Plans  Samples  Specifications  
 Copy of letter  Change order  \_\_\_\_\_

COPIES	DATE	NO.	DESCRIPTION
2			complete sets Sheets 1 - 6


THESE ARE TRANSMITTED as checked below:  
 For approval  Approved as submitted  Resubmit \_\_\_\_\_ copies for approval  
 For your use  Approved as noted  Submit \_\_\_\_\_ copies for distribution  
 As requested  Returned for corrections  Return \_\_\_\_\_ corrected prints  
 For review and comment  \_\_\_\_\_  
 FOR BIDS DUE \_\_\_\_\_ 19\_\_\_\_  PRINTS RETURNED AFTER LOAN TO US

REMARKS:  
 Dear George:  
 These drawings are presented for your approval for the as-built as requested by Jim Beavers of Fralin & Waldron, Inc.  
 \_\_\_\_\_  
 \_\_\_\_\_  
 COPY TO Jim Beavers - 1 set of plans  
 SIGNED: Ronald J. Boothe

FORM 240-2 Available from GCS&S, Inc., Townsend, Mass 01469 If enclosures are not as noted, kindly notify us at once

"AS-BUILT" REVISIONS MADE PER ROANOKE COUNTY PUBLIC SERVICE AUTHORITY INSPECTION PLANS. NOVEMBER 25, 1980 (AS-BUILT SHOWN IN BLOCKS) W.O. # 3399

**REVISED**  
 NOV 25 1980  
 APPROVED: \_\_\_\_\_  
 ROANOKE COUNTY PUBLIC SERVICE AUTHORITY DATE \_\_\_\_\_  
 CITY ENGINEER, ROANOKE, VA. DATE \_\_\_\_\_  
 OCTOBER 20, 1976

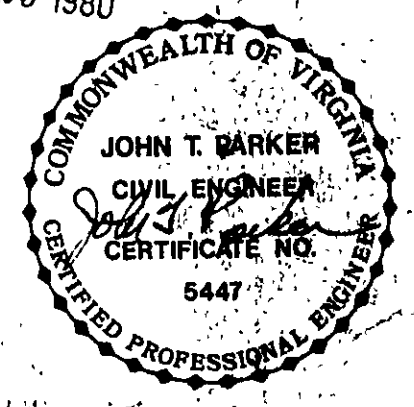

REVISIONS			
DRAWN BY:	DATE	REMARKS	BY
JTP	11/12/76	GENERAL REVISIONS, OMIT SHEET 6 OF 6	RJB
	12/3/76	ADDED SHEET 6 of 6	RJB
	2/10/77	GENERAL REVISIONS	RJB
APPROVED:			
DATE:			

**T. P. PARKER & SON**  
 engineers & surveyors  
 TELEPHONE (703) 387-1153  
 P.O. BOX 367, SALEM, VIRGINIA, 24153