


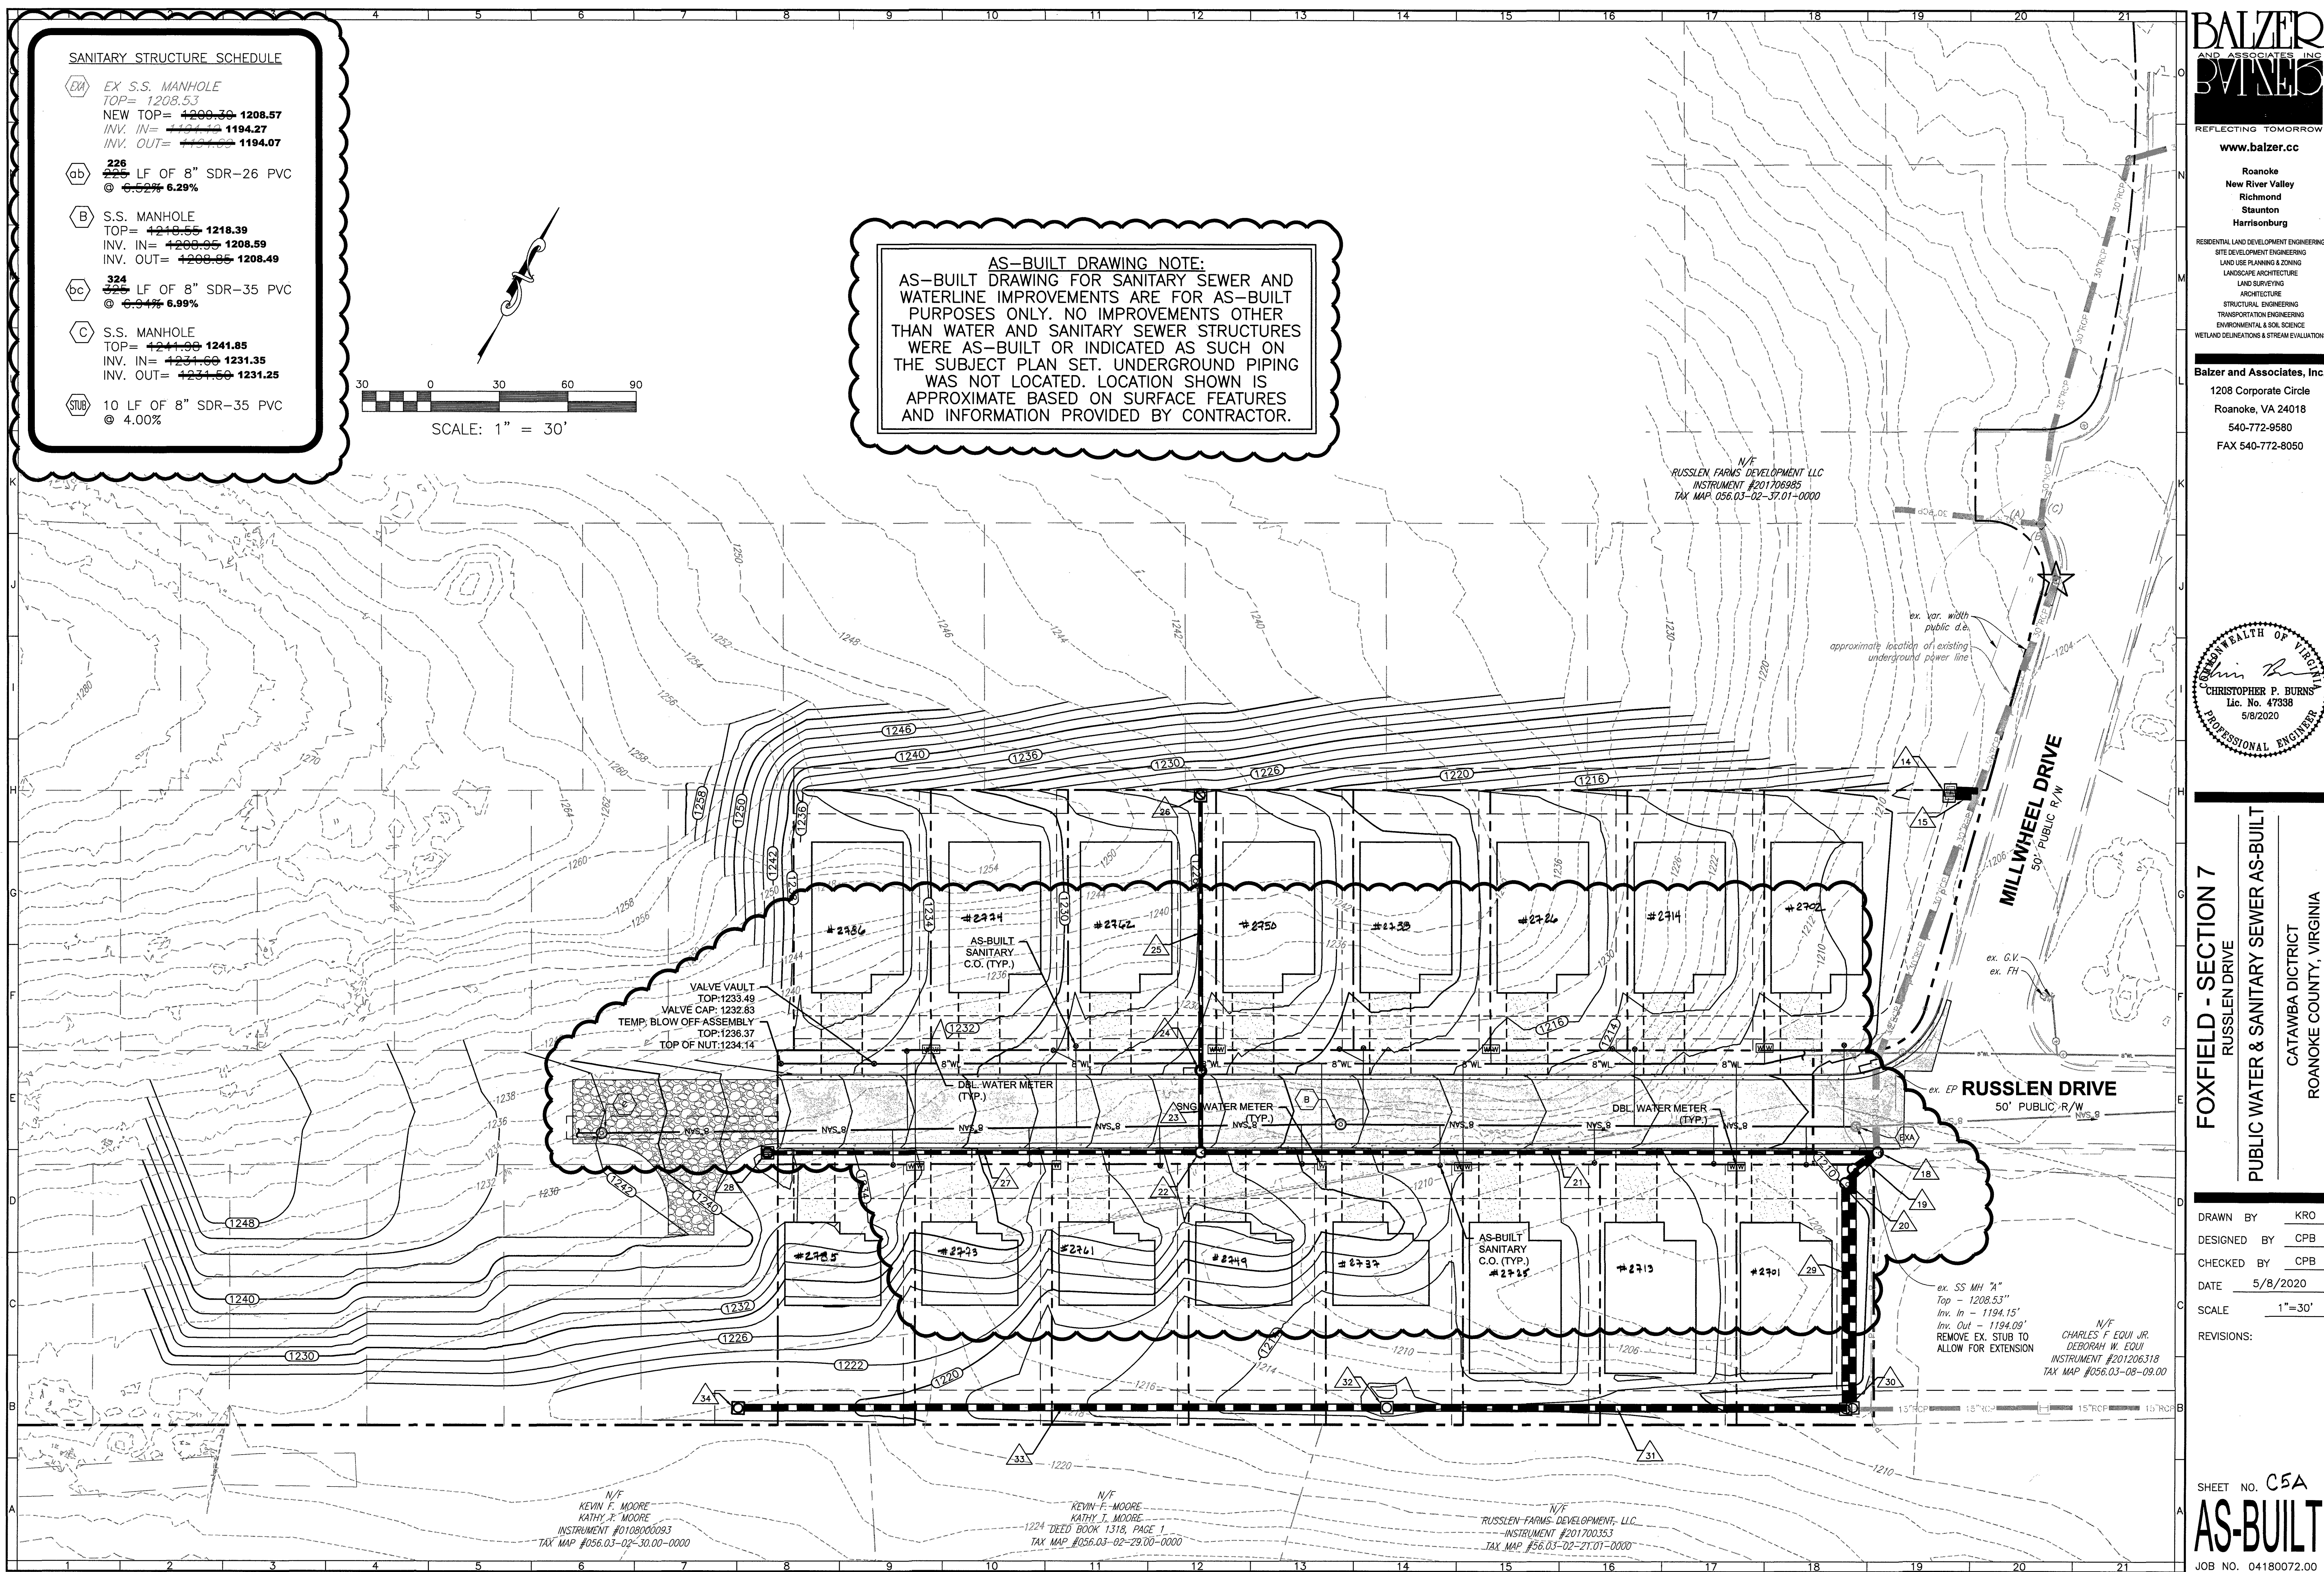

SANITARY STRUCTURE SCHEDULE

EX S.S. MANHOLE
TOP= 1208.53
NEW TOP= ~~1200.35~~ 1208.57
INV. IN= ~~1194.27~~ 1194.27
INV. OUT= ~~1194.07~~ 1194.07

225 LF OF 8" SDR-26 PVC
@ 0.52% 6.29%

S.S. MANHOLE
TOP= ~~1218.55~~ 1218.39
INV. IN= ~~1200.55~~ 1208.59
INV. OUT= ~~1200.55~~ 1208.49

324 LF OF 8" SDR-35 PVC
@ 0.94% 6.99%

S.S. MANHOLE
TOP= ~~1241.50~~ 1241.85
INV. IN= ~~1231.50~~ 1231.35
INV. OUT= ~~1231.50~~ 1231.25

10 LF OF 8" SDR-35 PVC
@ 4.00%

AS-BUILT DRAWING NOTE:
AS-BUILT DRAWING FOR SANITARY SEWER AND
WATERLINE IMPROVEMENTS ARE FOR AS-BUILT
PURPOSES ONLY. NO IMPROVEMENTS OTHER
THAN WATER AND SANITARY SEWER STRUCTURES
WERE AS-BUILT OR INDICATED AS SUCH ON
THE SUBJECT PLAN SET. UNDERGROUND PIPING
WAS NOT LOCATED. LOCATION SHOWN IS
APPROXIMATE BASED ON SURFACE FEATURES
AND INFORMATION PROVIDED BY CONTRACTOR.

BALZER
AND ASSOCIATES, INC.
REFLECTING TOMORROW

www.balzer.cc

Roanoke
New River Valley
Richmond
Staunton
Harrisonburg
RESIDENTIAL LAND DEVELOPMENT ENGINEERING
SITE DEVELOPMENT ENGINEERING
LAND USE PLANNING & ZONING
LANDSCAPE ARCHITECTURE
LAND SURVEYING
ARCHITECTURE
STRUCTURAL ENGINEERING
TRANSPORTATION ENGINEERING
ENVIRONMENTAL & SOIL SCIENCE
WETLAND DELINEATIONS & STREAM EVALUATIONS

Balzer and Associates, Inc.
1208 Corporate Circle
Roanoke, VA 24018
540-772-9580
FAX 540-772-8050

COMMONWEALTH OF VIRGINIA
CHRISTOPHER P. BURNS
Lic. No. 47338
5/8/2020
PROFESSIONAL ENGINEER

FOXFIELD - SECTION 7
RUSSLIN DRIVE
PUBLIC WATER & SANITARY SEWER AS-BUILT
CATAWBA DISTRICT
ROANOKE COUNTY, VIRGINIA

DRAWN BY KRO
DESIGNED BY CPB
CHECKED BY CPB
DATE 5/8/2020
SCALE 1"=30'
REVISIONS:

SHEET NO. C5A
AS-BUILT
JOB NO. 04180072.00