

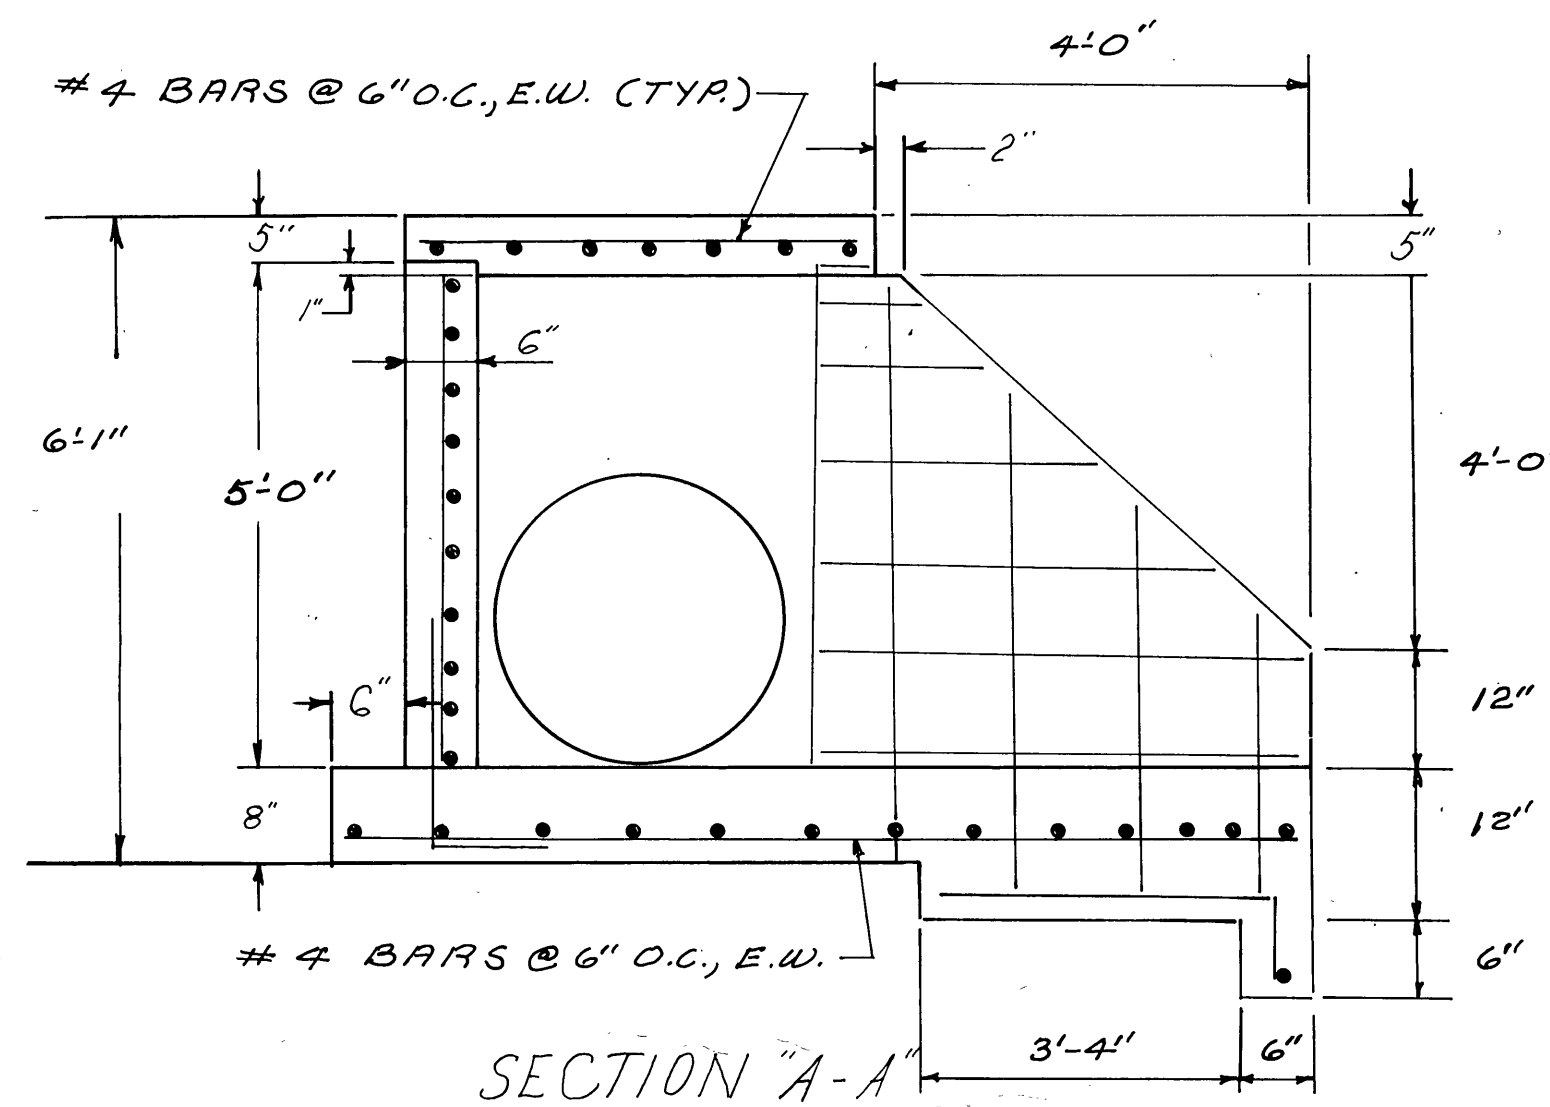
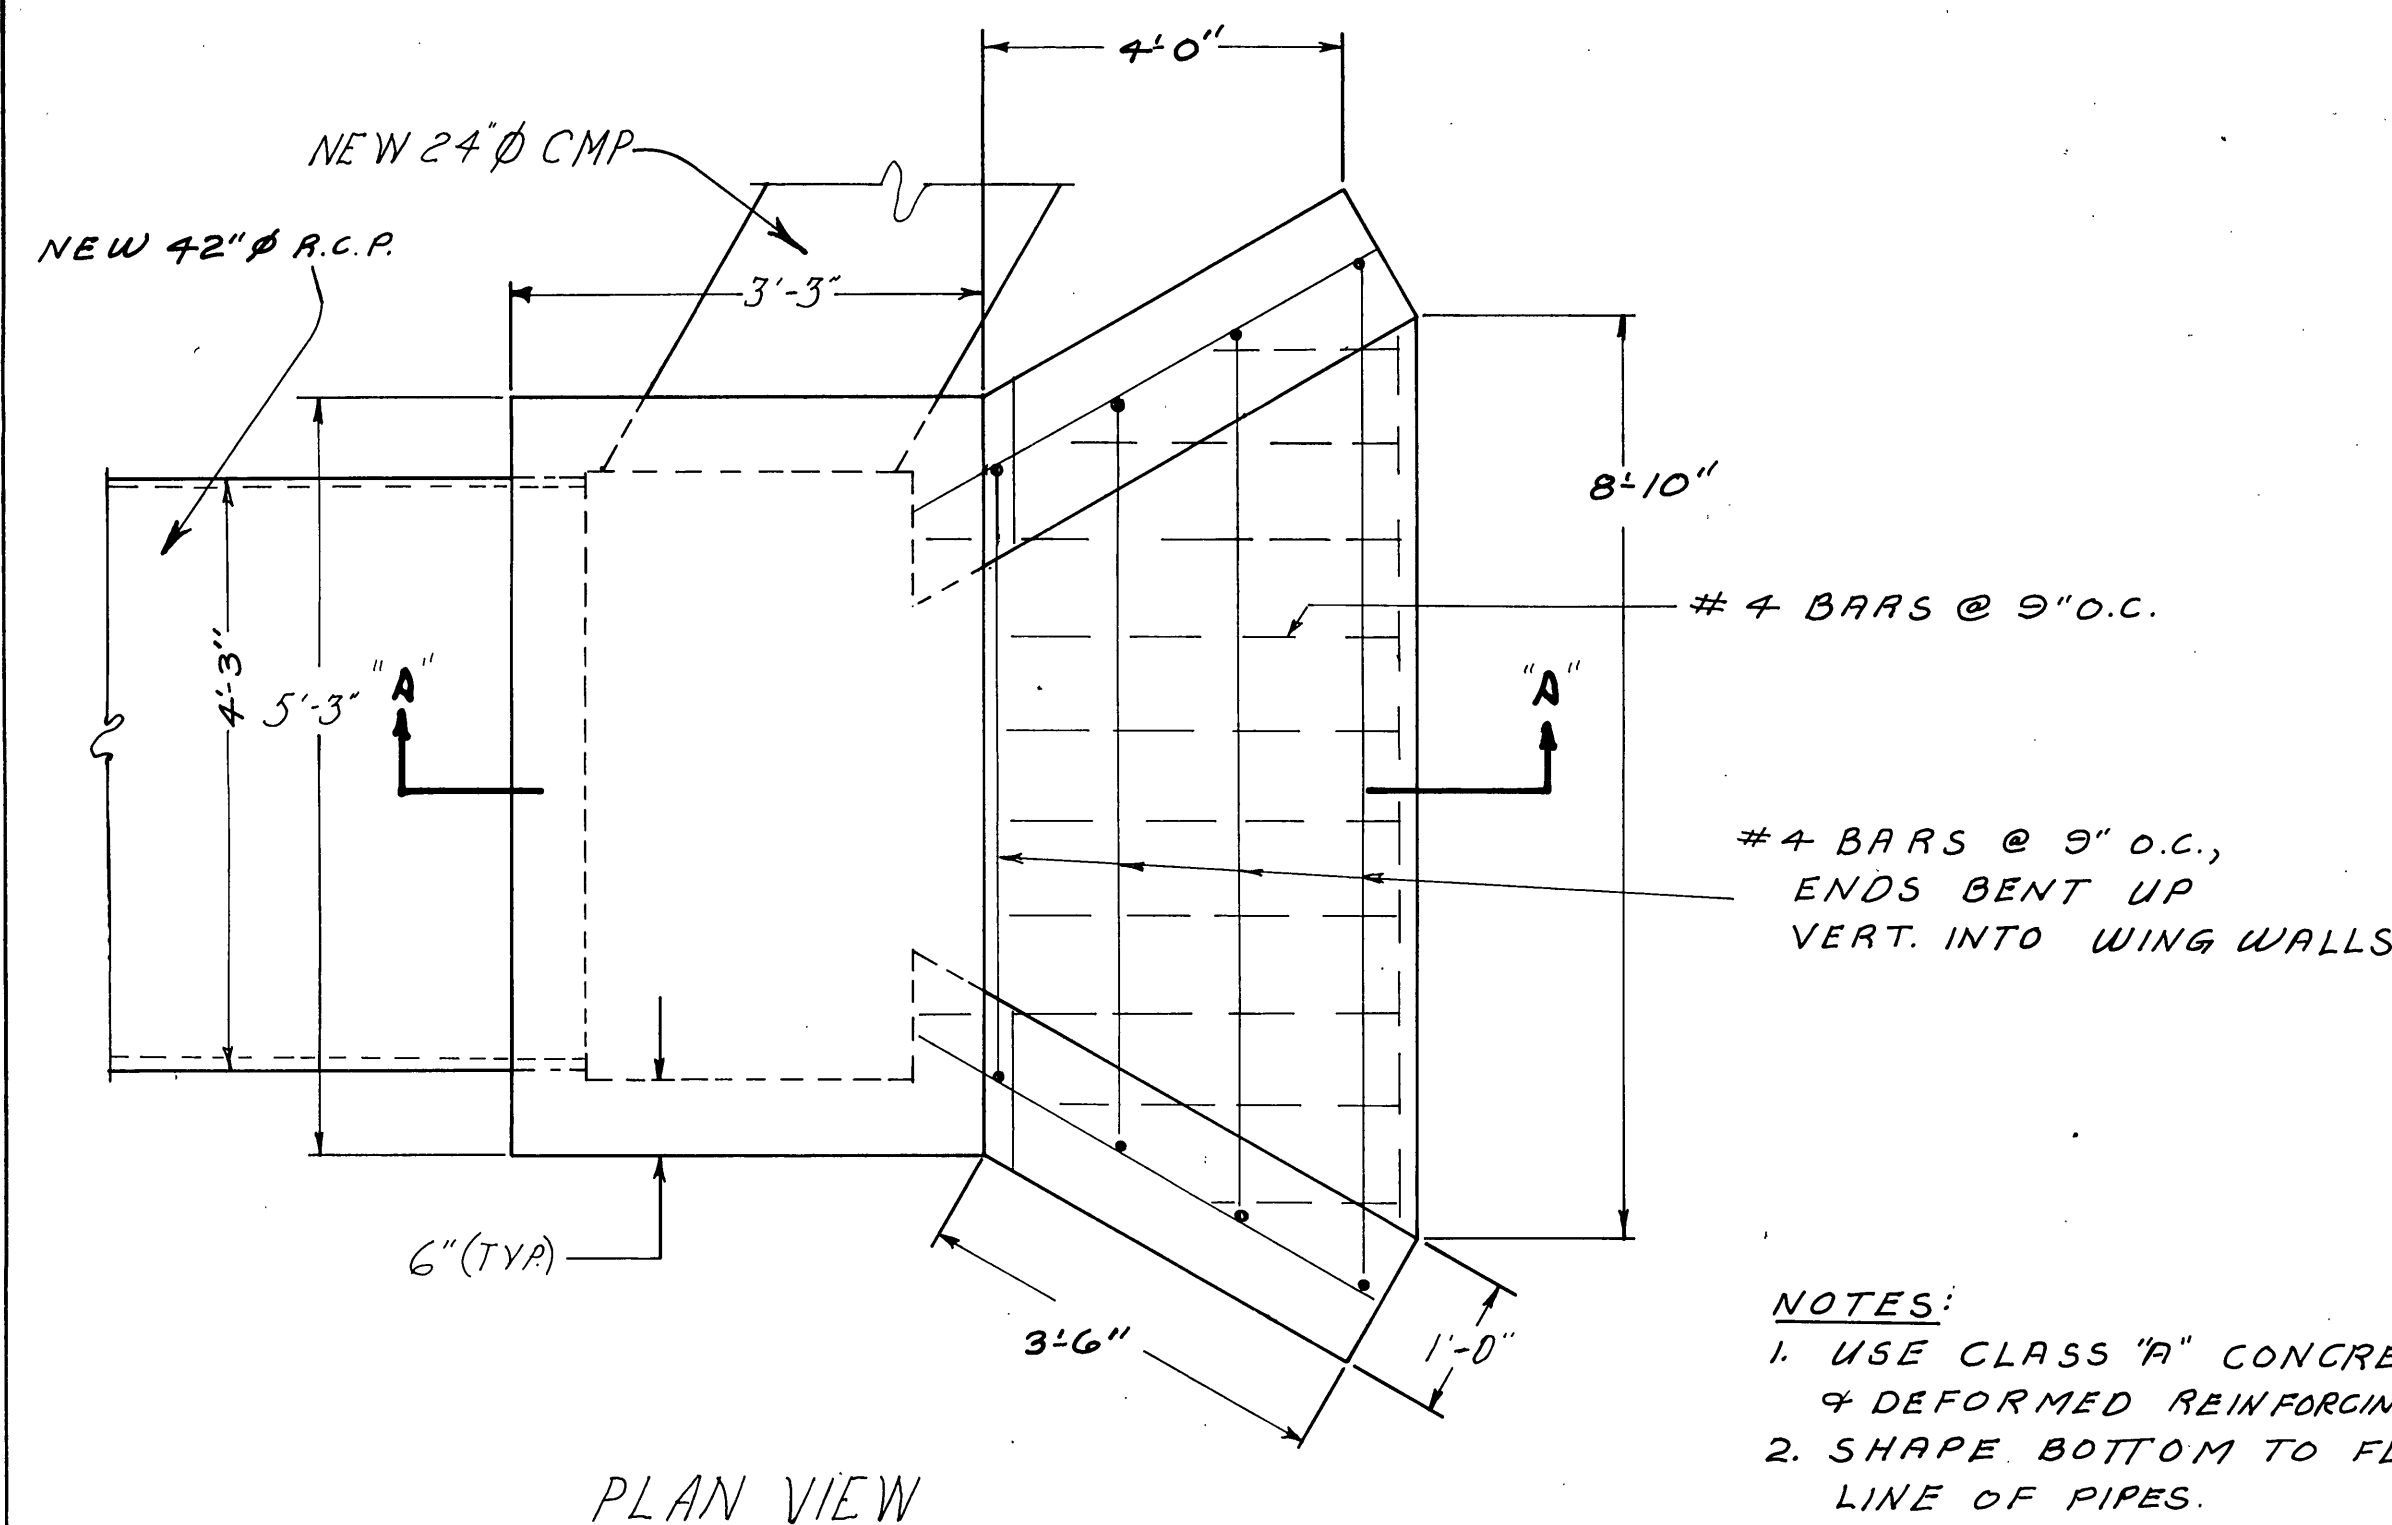


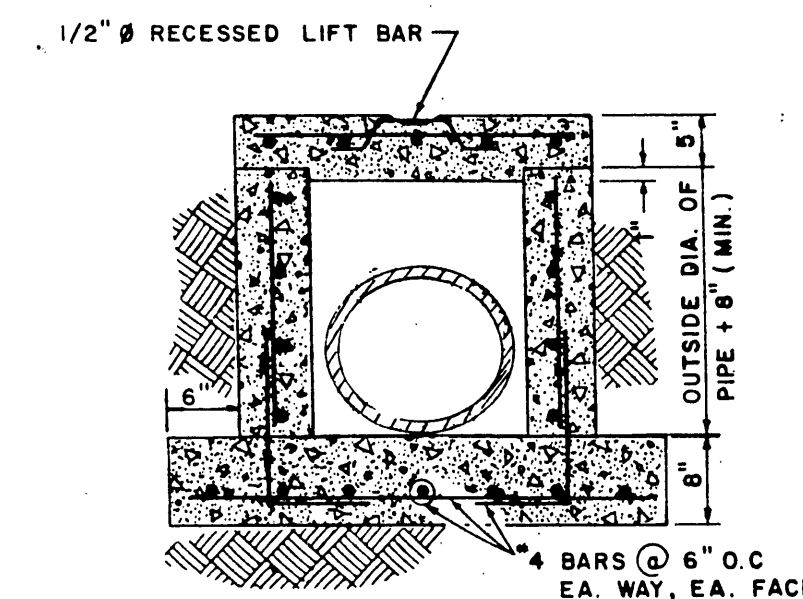

JUNCTION BOX # 2
N.T.S.

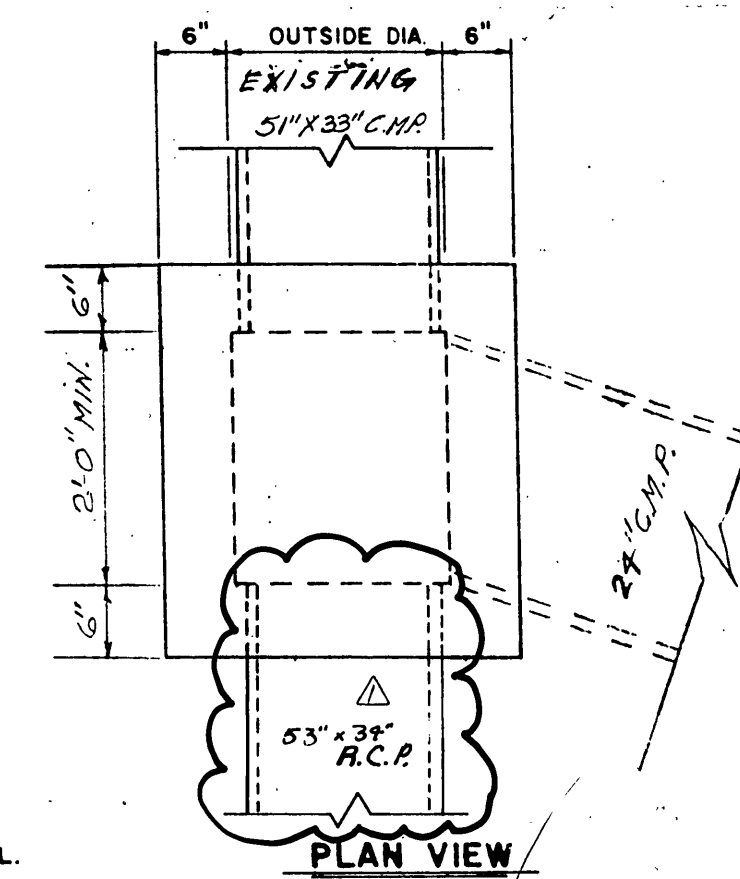

JUNCTION BOX # /
NO SCALE

- NOTES -

1. USE CLASS "A" CONCRETE & DEFORMED REINFORCING STEEL
2. SHAPE BOTTOM TO FLOWLINE OF PIPES.

NOTES:

1. USE CLASS "A" CONCRETE & DEFORMED REINFORCING STEEL
2. SHAPE BOTTOM TO FLOW LINE OF PIPES.

11-12-87 H.T. Bowling, Grading Cont. Started clearing + Grubbing Area (Dean Graham Supr.)
11-17-87 Checked site cutting trees Rain in PM.
11-24-87 Cutting + Grubbing -
11-25-87 Hauling Brush -
11-30-87 Hauling Debris + Brush
12-1-87
12-2-87 Finished Hauling Debris
12-4-87 Grading Site.
12-7-87 Grading Site ~~Debris + Debris~~ Supr.
12

12-14-87 Grading site. ^{Pat Sigler Supt.} Bldg. Lower Retaining Wall.
12-16-87 Grading site. Informal earth. to cut
prev. of fill fence up so no erosion would get
into exist. ditch above stream, etc.
12-21-87 Grading
12-22-87

12-20-87 Set Trap #1 - carrying 58x36 Arch pipe.
2-21-87 Grading Arch pipe across entrance on Show. Ave. (Paved 4' of Footers)
-588 Grading Pan. Bldg. Footers (hit Rock) backfilling around J.B. 1
H-888 Hauling off excess dirt - working on 4' of
21-88 Visited off excess dirt - working on 4' of

22-88 Lay into Block. TRACING from old porous foundation.
22-88 Hauling Block for foundation. installed pipe to pump up. & get more stone
22-88 Hauling excess dirt - installing pipe to pump #2 & both spillways
22-88 Lay in 16" 24" cmp from pond across entre. on old stream bed
22-88 Hauling excessive dirt for fill
22-88 Lay in 16" 24" cmp from pond across entre. on old stream bed

1-88 Laying 10" comp pipe from pond to new DI, 4 slotted
2-88 Hauling excess dirt - improve suggested gain in
3-88 Tied into dirt - improve suggested gain in
4-88 Hauling excess dirt - improve suggested gain in

58 Installing Sewer to new Bldg.
58 Grading for Laying 6" and bringing up fill at pond and
8 Laying 6" water main cut
installing

is installing trench and man + pipe to Pond cutting off
i. is corner of parking lot
out and

6" Stone on Lot
4" walled about Lot
Fire interior Curb - 6" western
Fire service - 1/4" Filled 6" west
Curb - Also started grading & running pipe
on Shenn. Ave.

in copper service. Called Trent will be out tomorrow to test. Found leak on
at vault still not fixed will come back Monday. -
exist. curb for with on old street.

Grading Lot - installing interior curbs
- installing 6" water line

246 on Tordis Lane
+ Fiddle on Old Stearns Rd.
Cone Encl. ?
of 1st

on west side -
top sailing Pond.
trees 4.23.80



no.	revision	date
1	Added note * 25-135 R.C.F.	7-9-87
2	REVISOR: MINOR CORRECTIONS RE: RE-ENTRY	10-5-87
3		
4		
SHOPPING CENTER
SHENANDOAH & WEST SIDE BLVD
ROANOKE, VA

**artech
design
group, inc.**

architecture, planning
interior design, graphics

chattanooga, tennessee
phone - 615-265-4313

COMMONWEALTH OF VERMONT
J. DAVID HUDSON
No. 006103

job no. 87-126
date 8-27-87
drawn B.C.R.
ch'k G.A.H.
sheet:
C-5
of 10