

"AS-BUILT" 8 NOV. 1996
DEVELOPMENT PLAN

FOR

PHASE 1

SOUTH LOOP TRANSMISSION MAIN


SITUATED IN

CAVE SPRING, WINDSOR HILLS &
CATAWBA MAGISTERIAL DISTRICTS
ROANOKE COUNTY, VIRGINIA

DATE: 6 MAY 1994

PREPARED FOR

ROANOKE COUNTY UTILITY DEPARTMENT

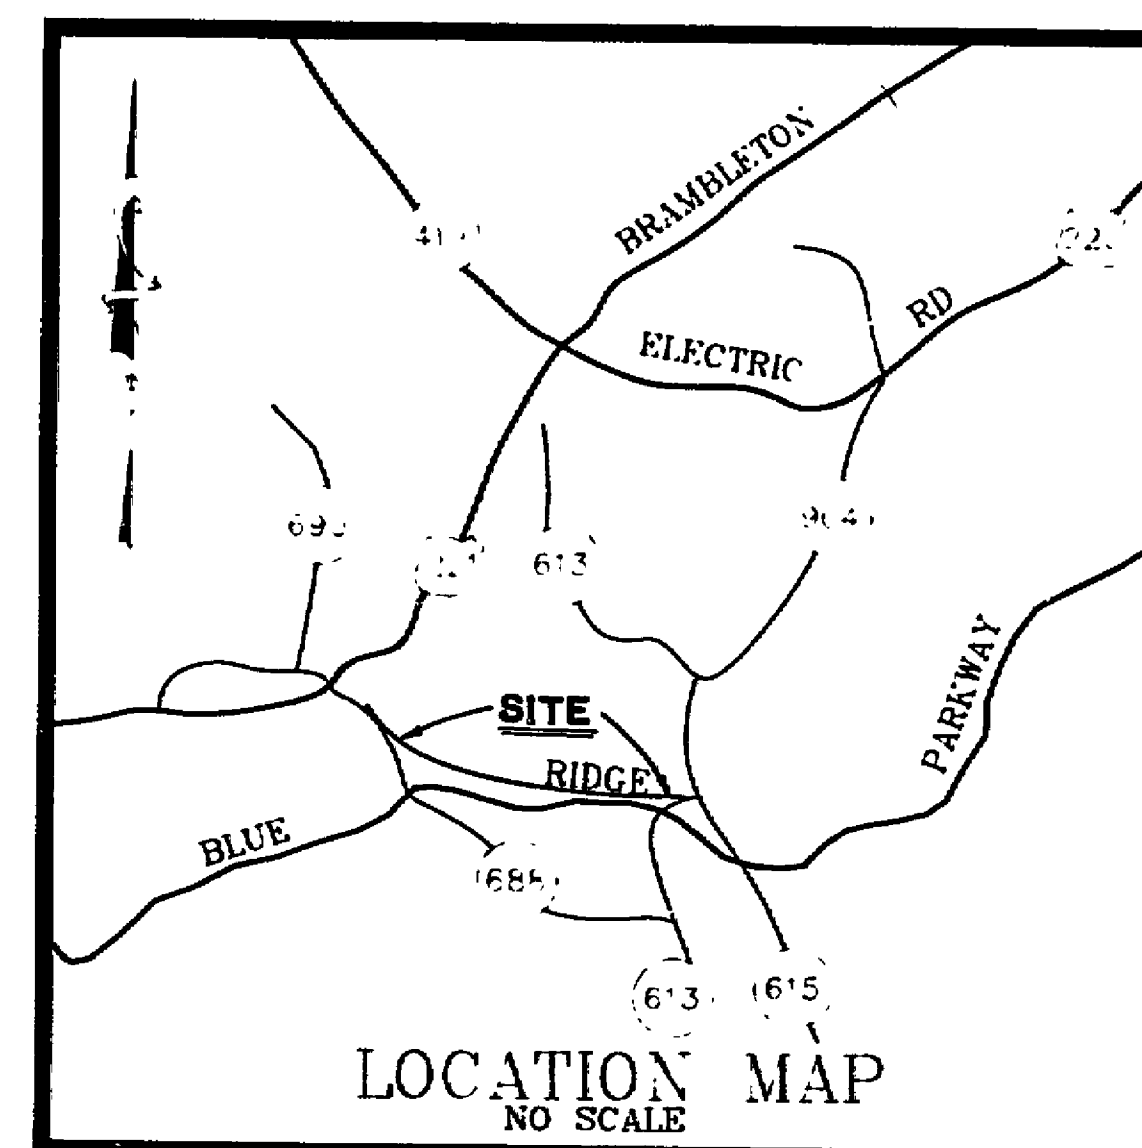


INDEX OF DRAWINGS

SHEET No.	DESCRIPTION
-----------	-------------

- | | |
|-------|---|
| 1. | LUMSDEN ASSOCIATES COVER SHEET |
| 2. | PLAN & PROFILE SHEET LAYOUT |
| 3.-9. | PLAN & PROFILES |
| 10. | WATER DETAILS |
| 11. | ROANOKE CO. STD. SANITARY SEWER DETAIL SHEET |
| 12. | ROANOKE CO. STD. EROSION CONTROL DETAIL SHEET |

LUMSDEN ASSOCIATES, P.C.
ENGINEERS-SURVEYORS-PLANNERS
ROANOKE, VIRGINIA

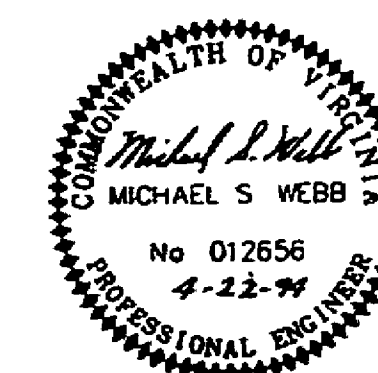

"AS-BUILT"

NOTES:
1) "AS-BUILT" INFORMATION TAKEN FROM
PLANS FURNISHED BY ROANOKE COUNTY.
2) "AS-BUILT" DIMENSIONS SHOWN IN
BRACKETS.

WT-0458

SHEET #1 OF 12