

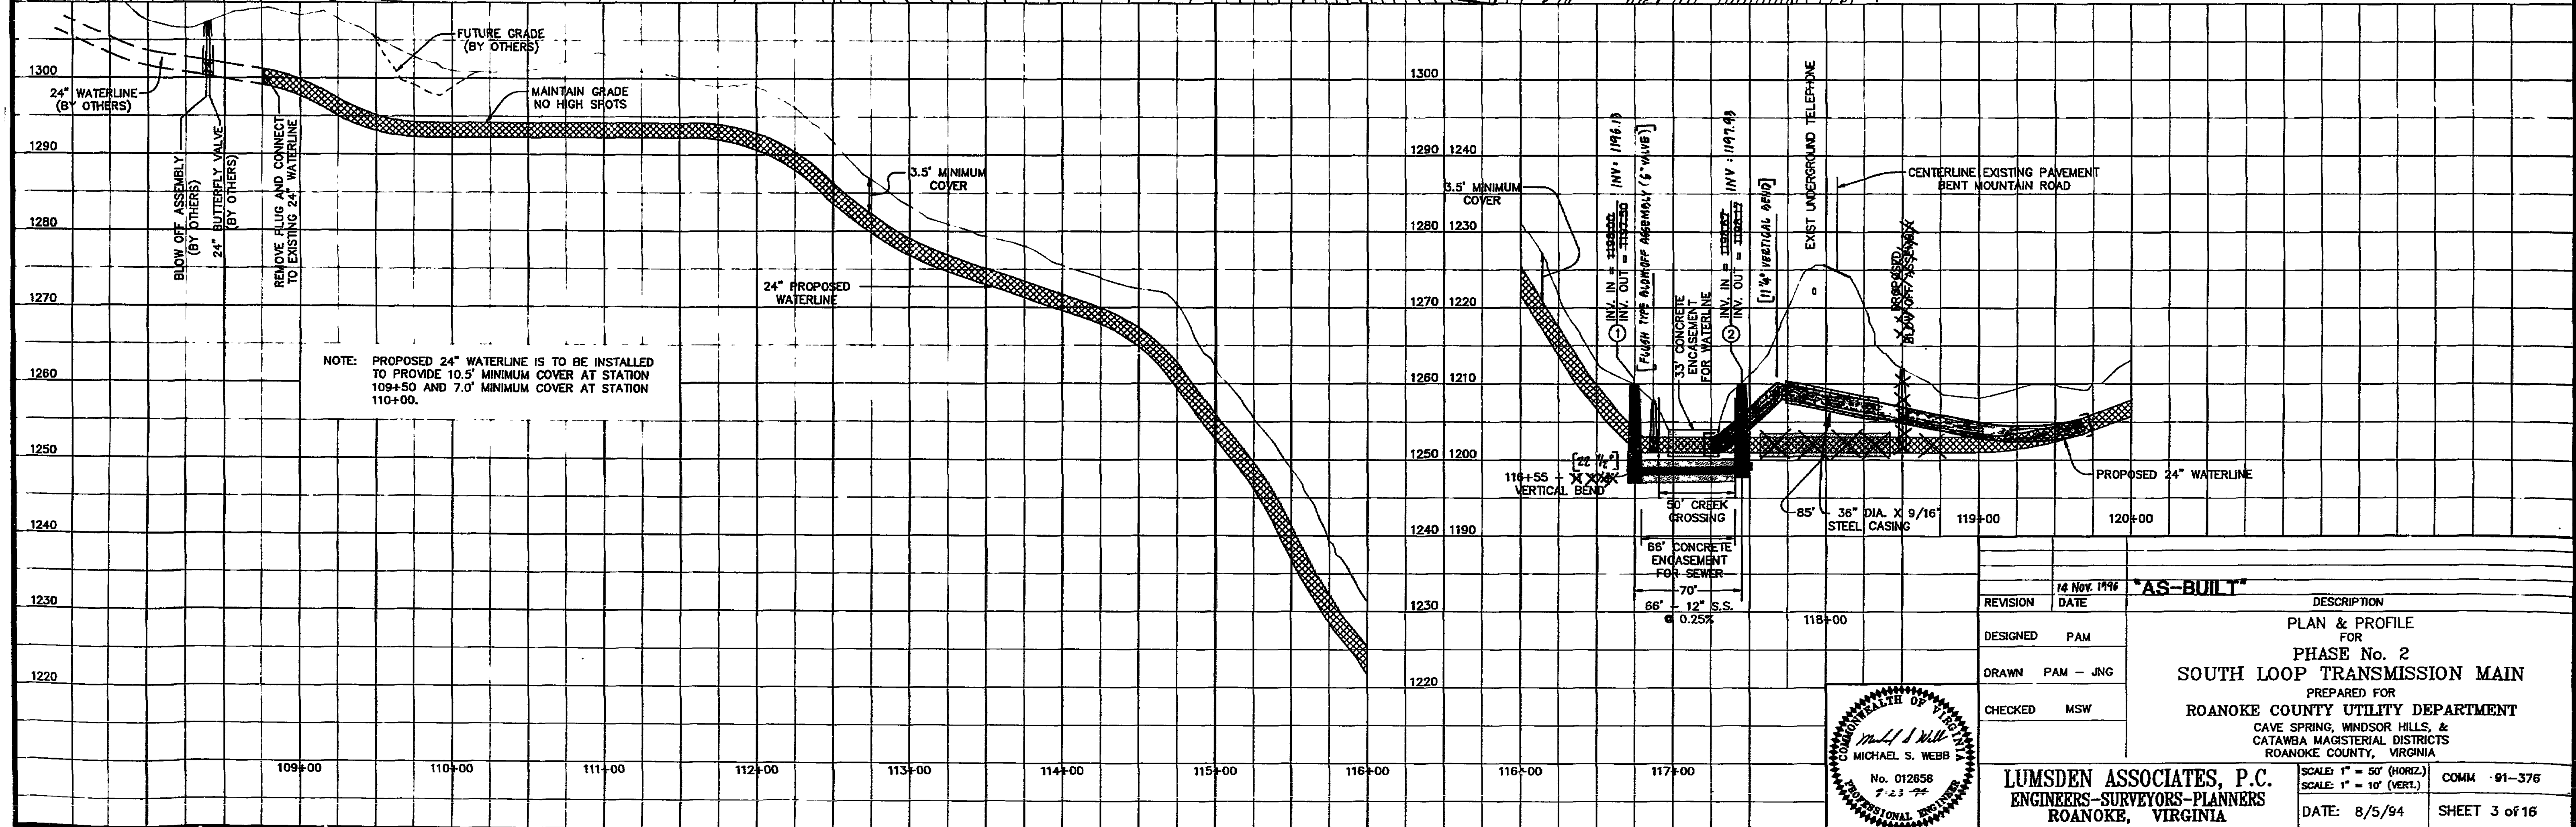


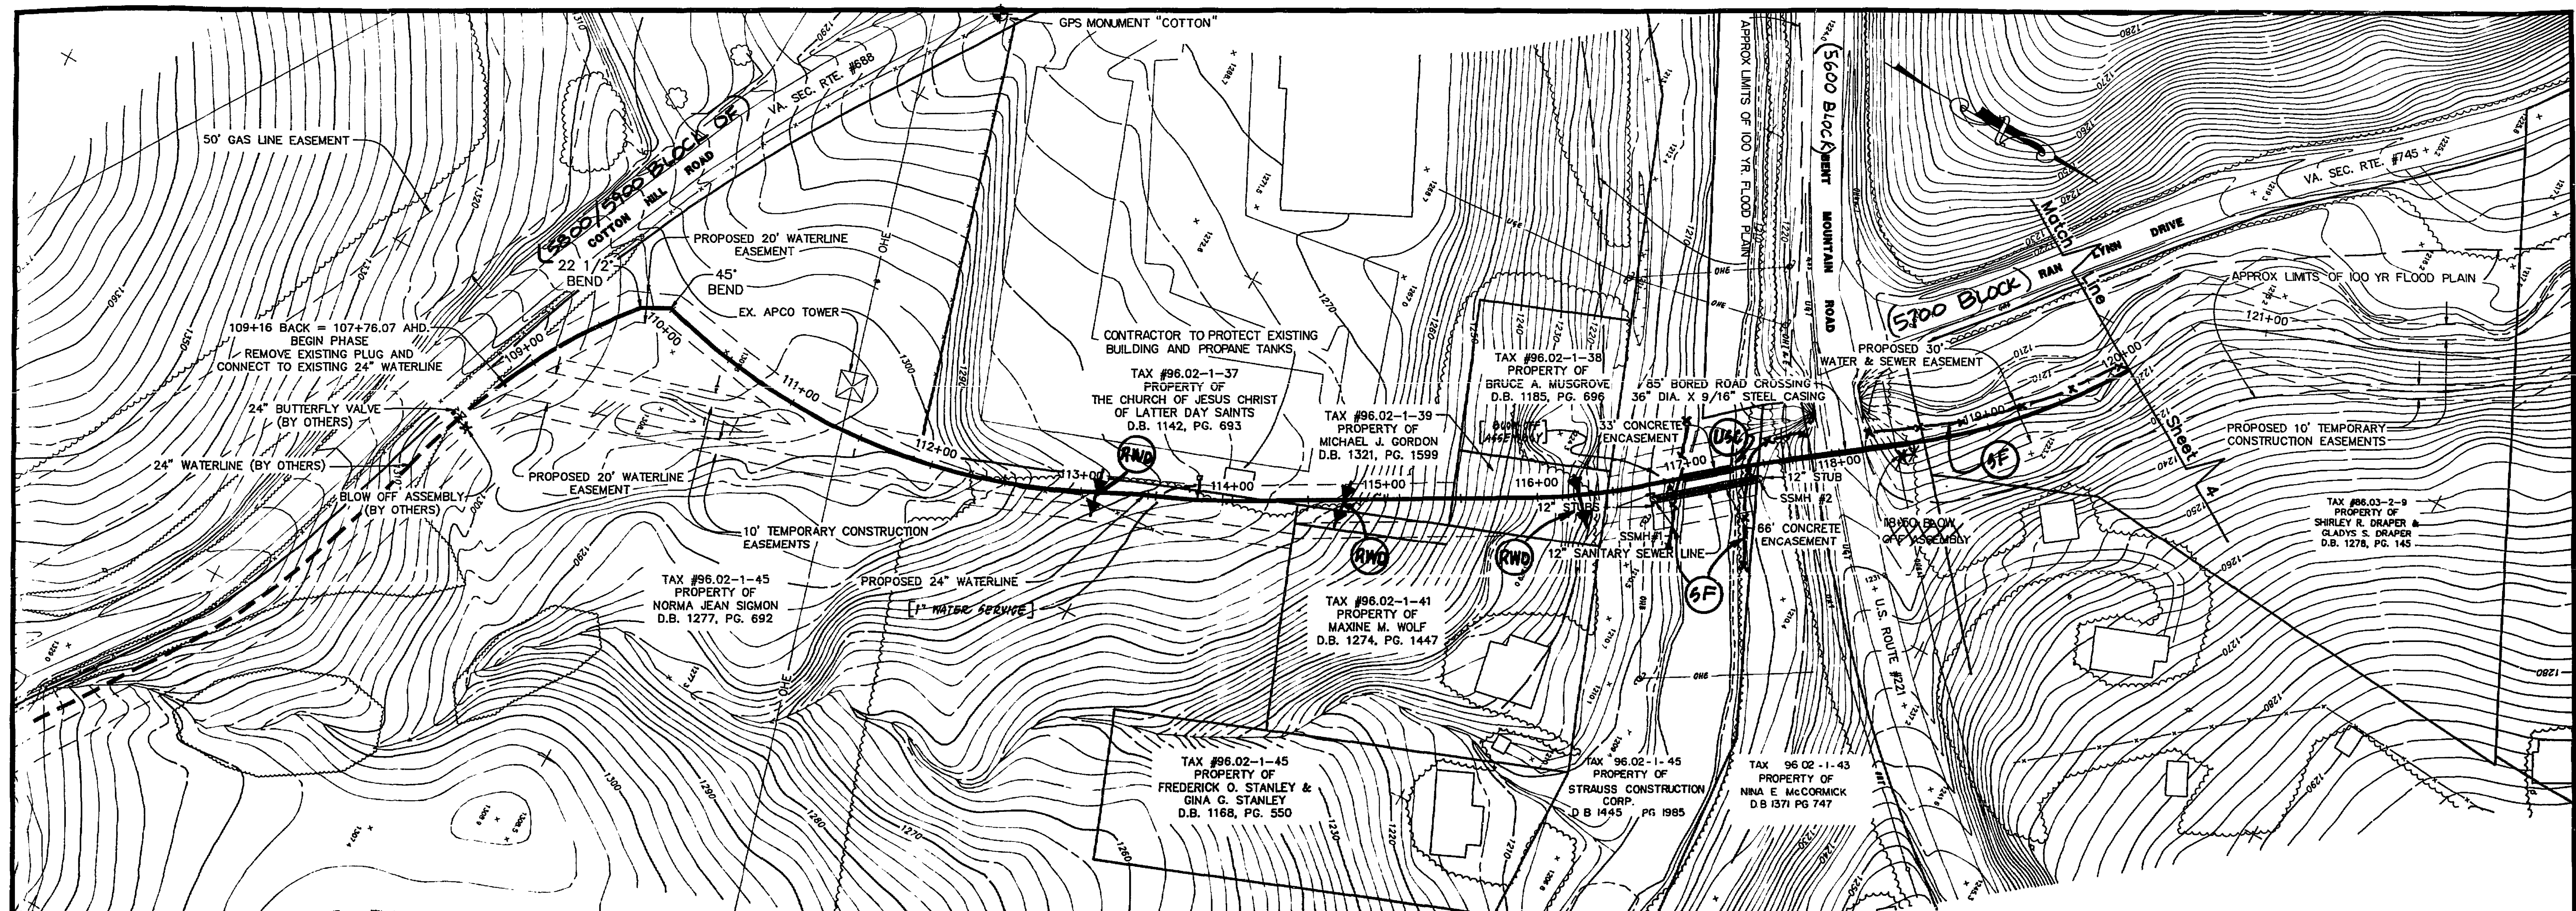

NOTE: PROPOSED 24" WATERLINE IS TO BE INSTALLED TO PROVIDE 10.5' MINIMUM COVER AT STATION 109+50 AND 7.0' MINIMUM COVER AT STATION 110+00.

REVISION	DATE	DESCRIPTION
1	16 Nov. 1996	"AS-BUILT"
DESIGNED	PAM	PLAN & PROFILE FOR
DRAWN	PAM - JNG	PHASE No. 2
CHECKED	MSW	SOUTH LOOP TRANSMISSION MAIN
		PREPARED FOR
		ROANOKE COUNTY UTILITY DEPARTMENT
		CAVE SPRING, WINDSOR HILLS, & CATAWBA MAGISTERIAL DISTRICTS
		ROANOKE COUNTY, VIRGINIA
		SCALE: 1" = 50' (HORIZ.)
		SCALE: 1" = 10' (VERT.)
		DATE: 8/5/94
		SHEET 3 of 16

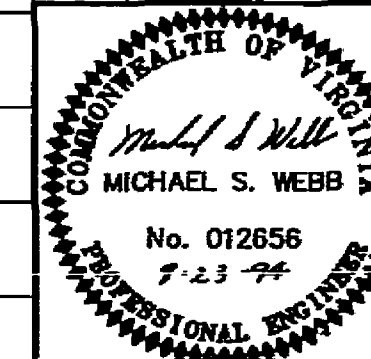

LUMSDEN ASSOCIATES, P.C.
ENGINEERS-SURVEYORS-PLANNERS
ROANOKE, VIRGINIA