
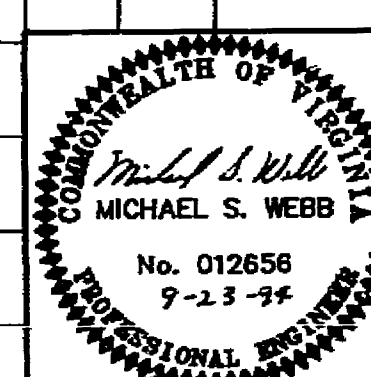
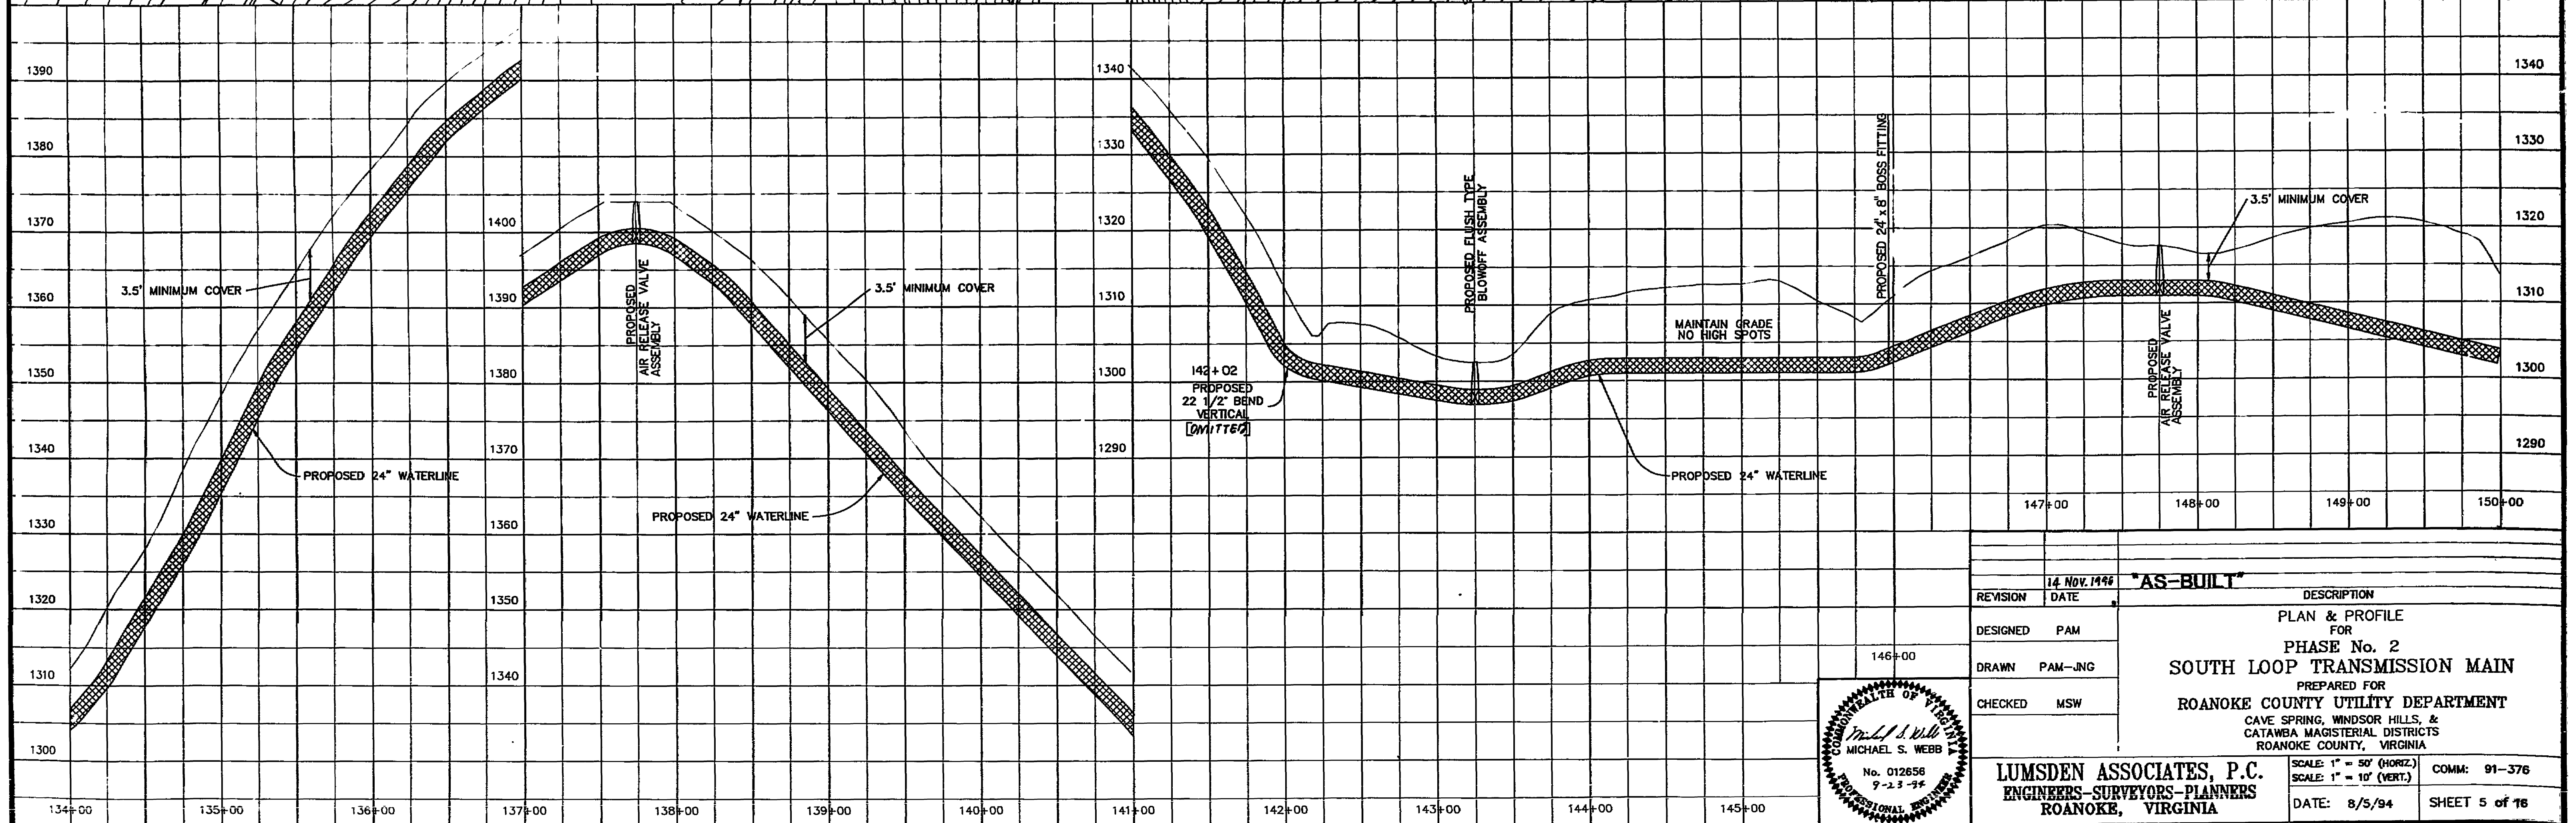


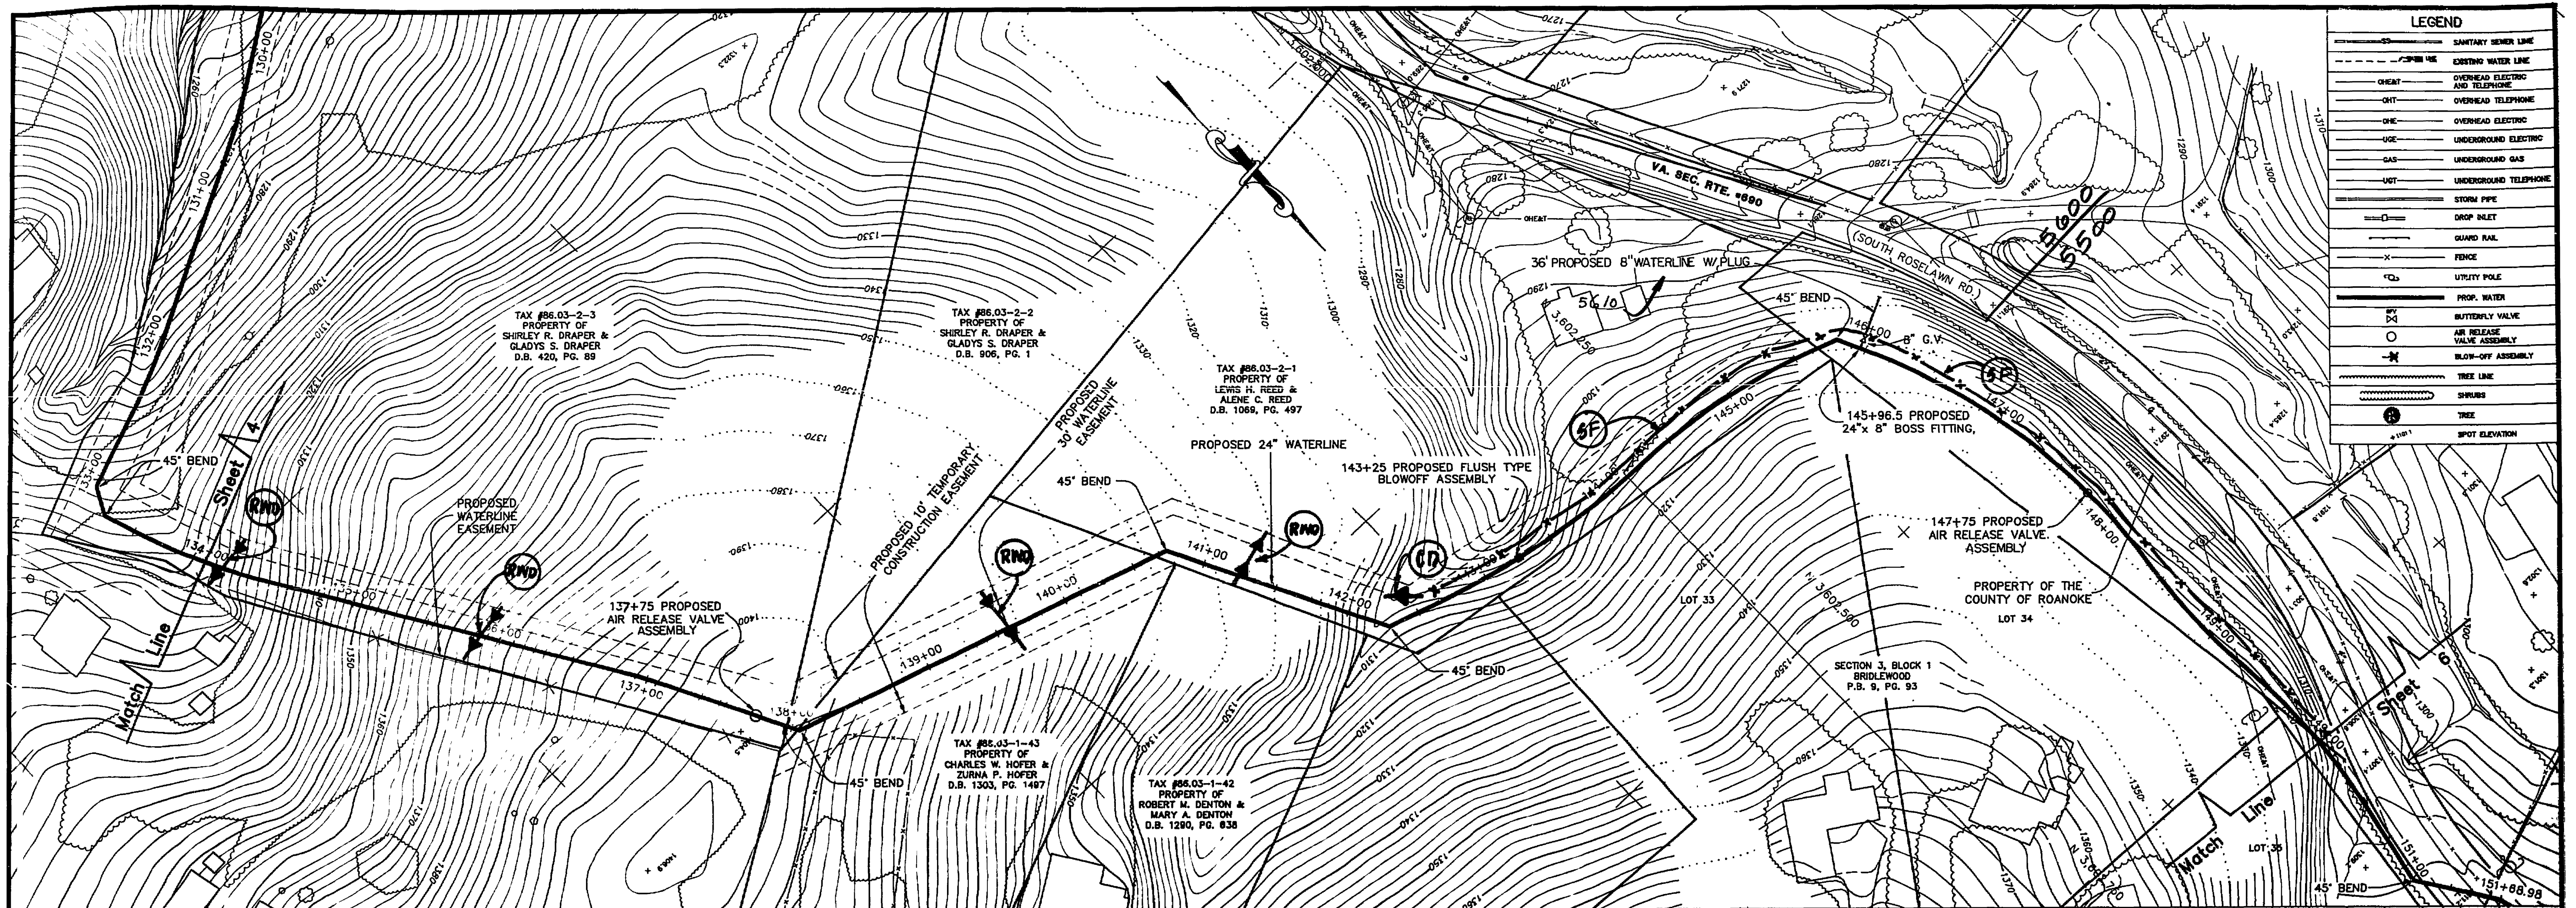

14 Nov. 1998		AS-BUILT
REVISION	DATE	DESCRIPTION
DESIGNED	PAM	PLAN & PROFILE FOR
DRAWN	PAM-JNG	PHASE No. 2
CHECKED	MSW	SOUTH LOOP TRANSMISSION MAIN
		PREPARED FOR
		ROANOKE COUNTY UTILITY DEPARTMENT
		CAVE SPRING, WINDSOR HILLS, & CATAWBA MAGISTERIAL DISTRICTS
		ROANOKE COUNTY, VIRGINIA
LUMSDEN ASSOCIATES, P.C.		SCALE: 1" = 50' (HORIZ.)
ENGINEERS-SURVEYORS-PLANNERS		SCALE: 1" = 10' (VERT.)
ROANOKE, VIRGINIA		DATE: 8/5/94
		COMM: 91-376
		SHEET 5 of 16

WT- 0474