
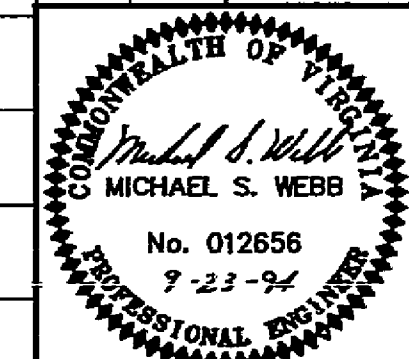
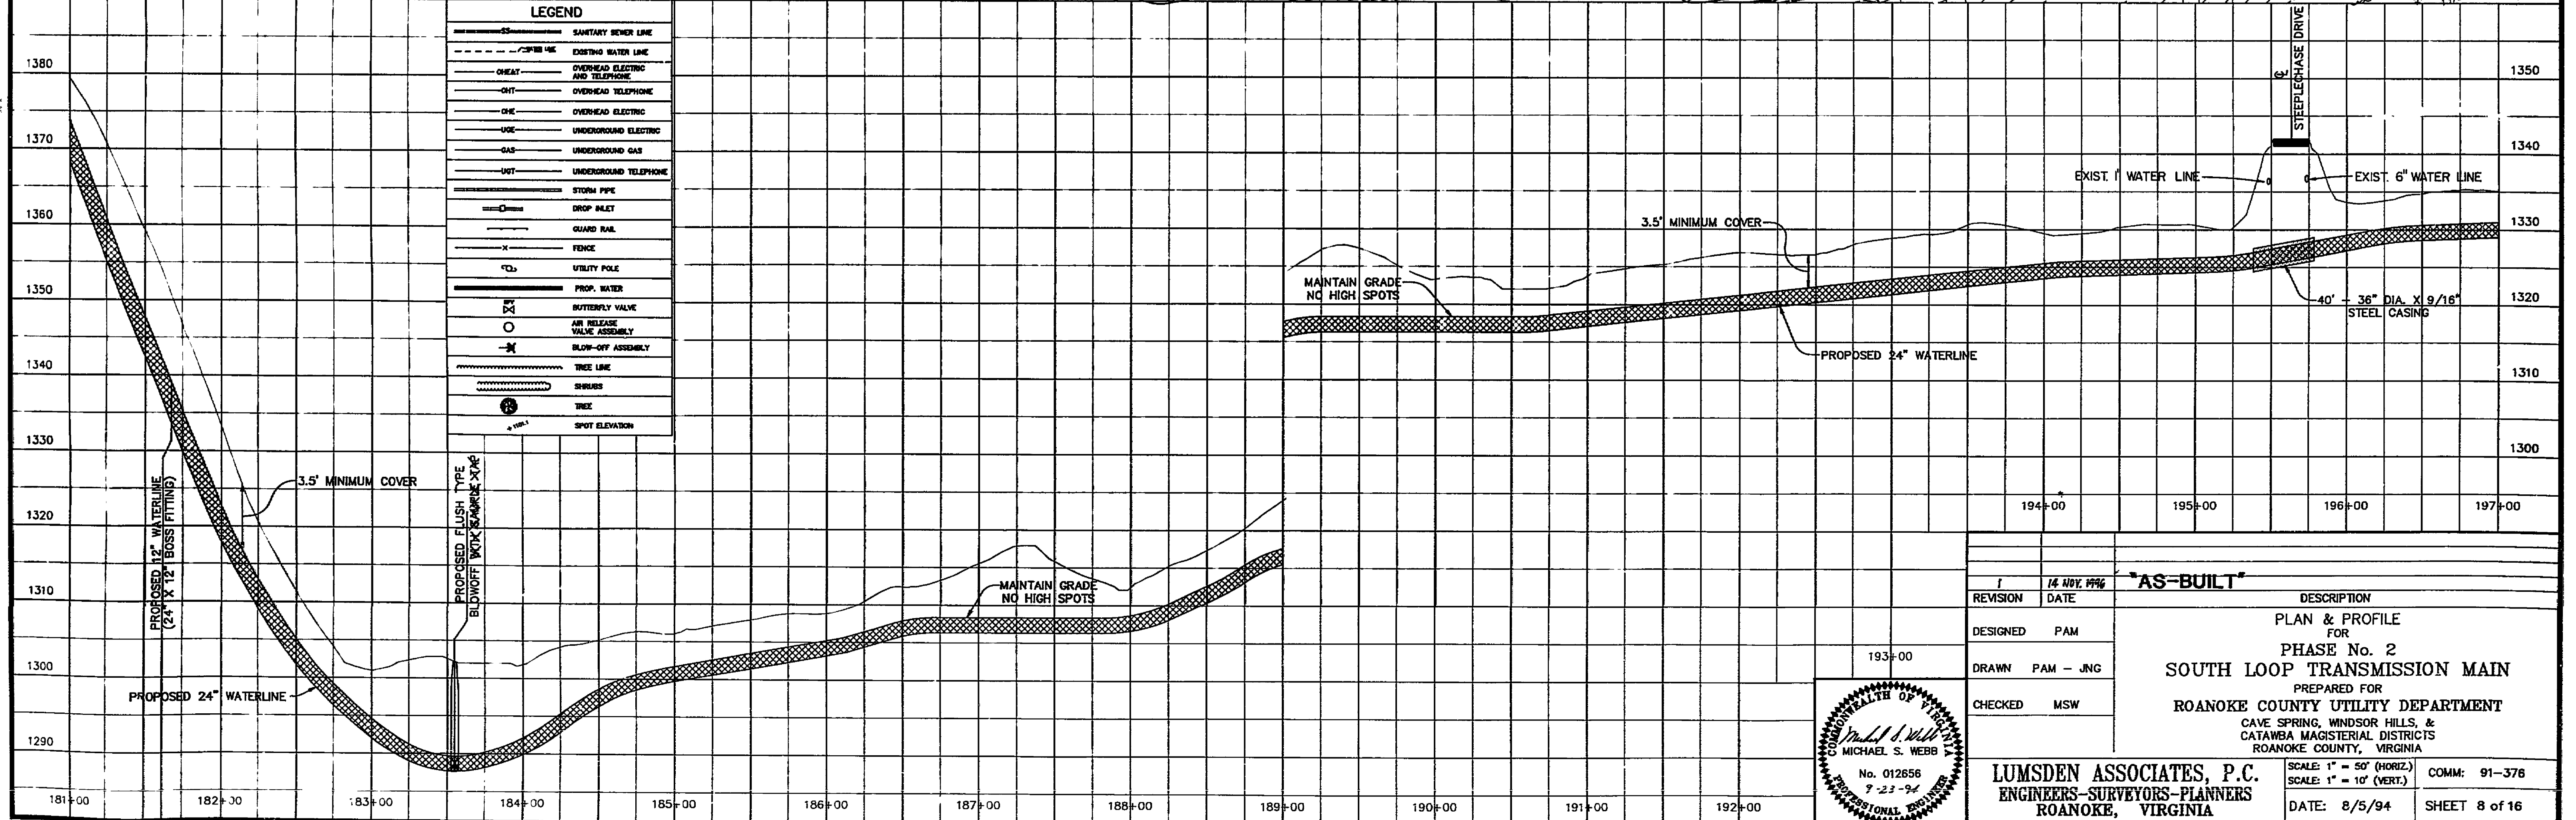


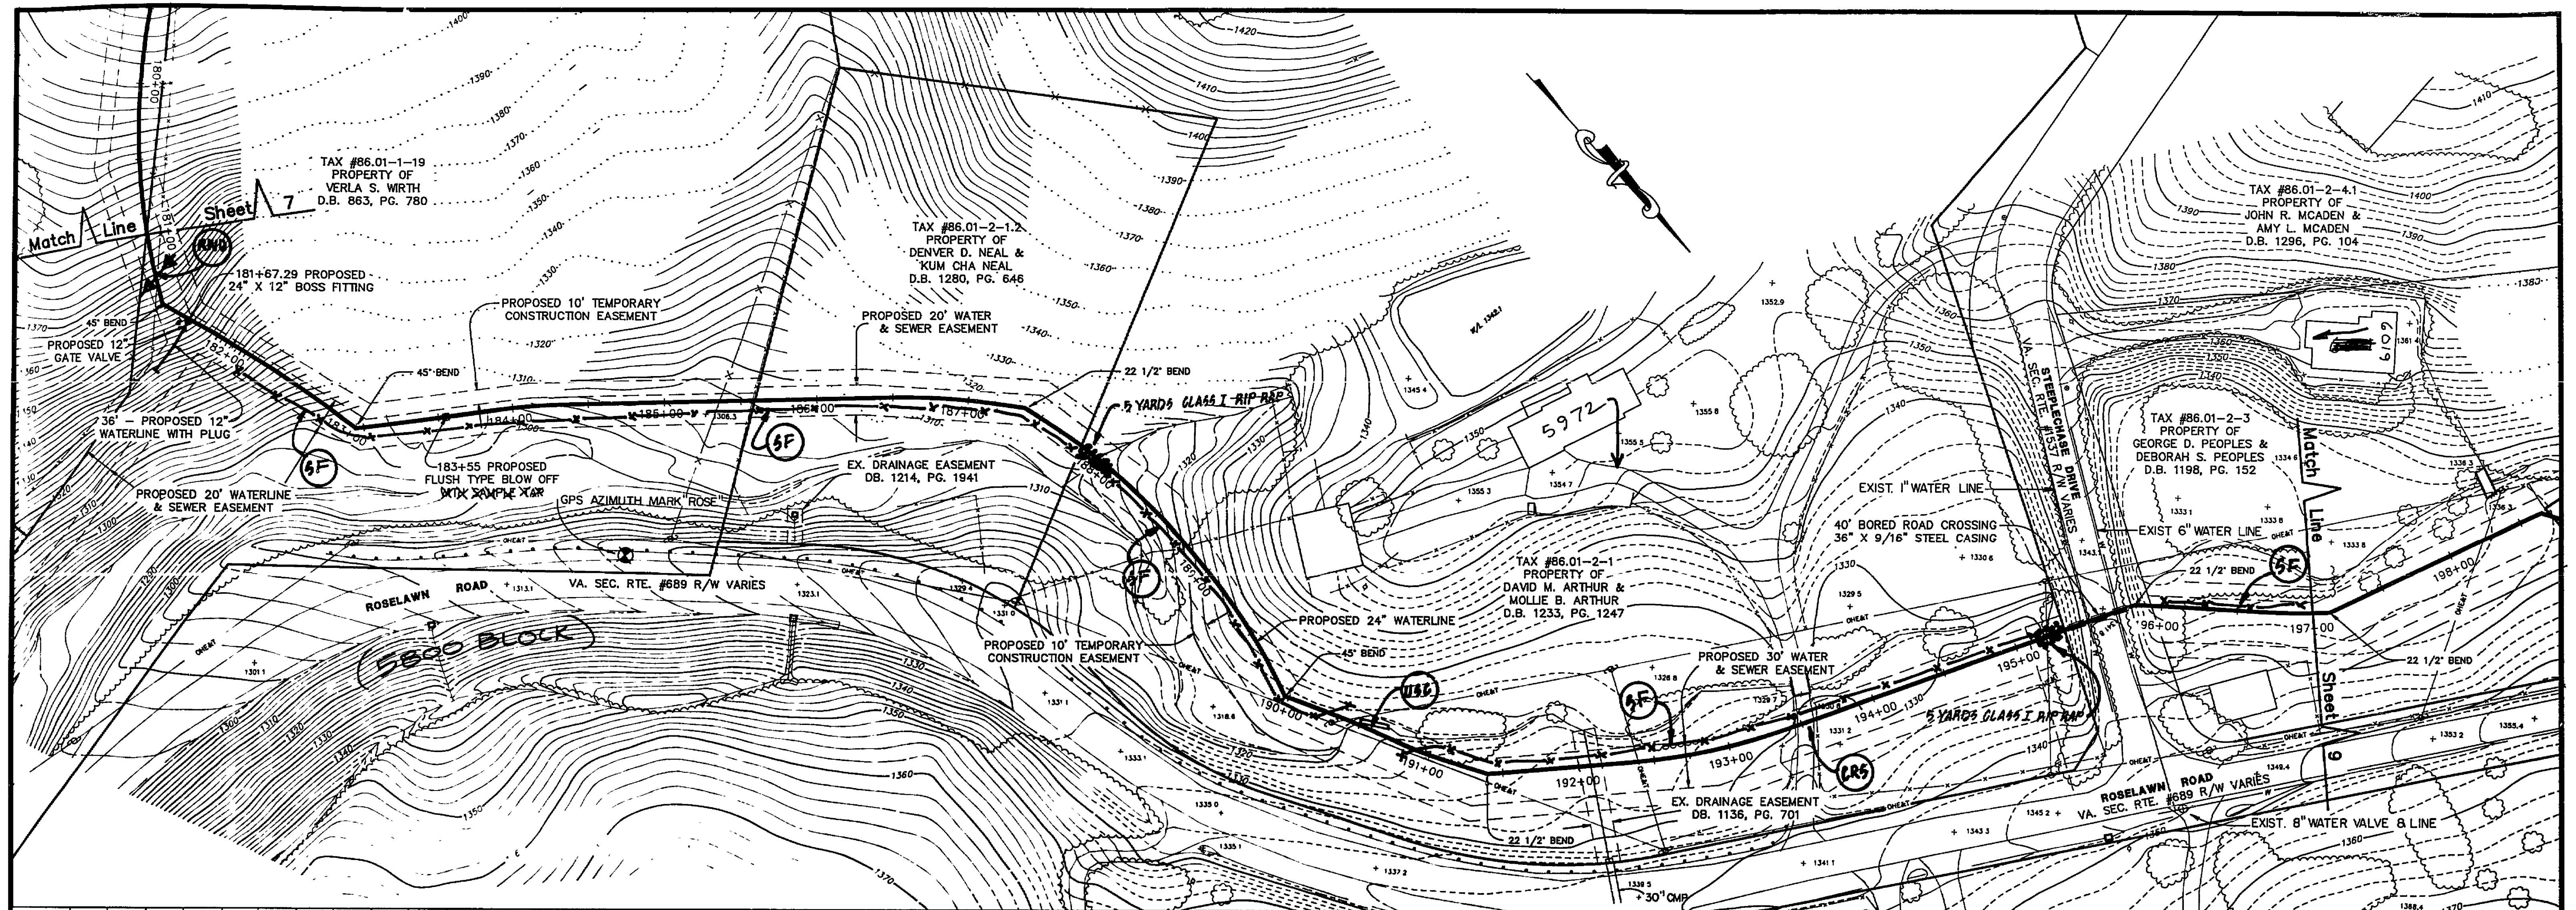

REVISION		DATE	DESCRIPTION
1	AS-BUILT	16 NOV 1996	PLAN & PROFILE FOR PHASE No. 2 SOUTH LOOP TRANSMISSION MAIN
DESIGNED	PAM		PREPARED FOR ROANOKE COUNTY UTILITY DEPARTMENT
DRAWN	PAM - JNG		CAVE SPRING, WINDSOR HILLS, & CATAMBA MAGISTERIAL DISTRICTS
CHECKED	MSW		ROANOKE COUNTY, VIRGINIA

LUMSDEN ASSOCIATES, P.C.		SCALE: 1" = 50' (HORIZ.)	COMM: 91-378
ENGINEERS-SURVEYORS-PLANNERS		SCALE: 1" = 10' (VERT.)	
ROANOKE, VIRGINIA		DATE: 8/5/94	SHEET 8 of 16