



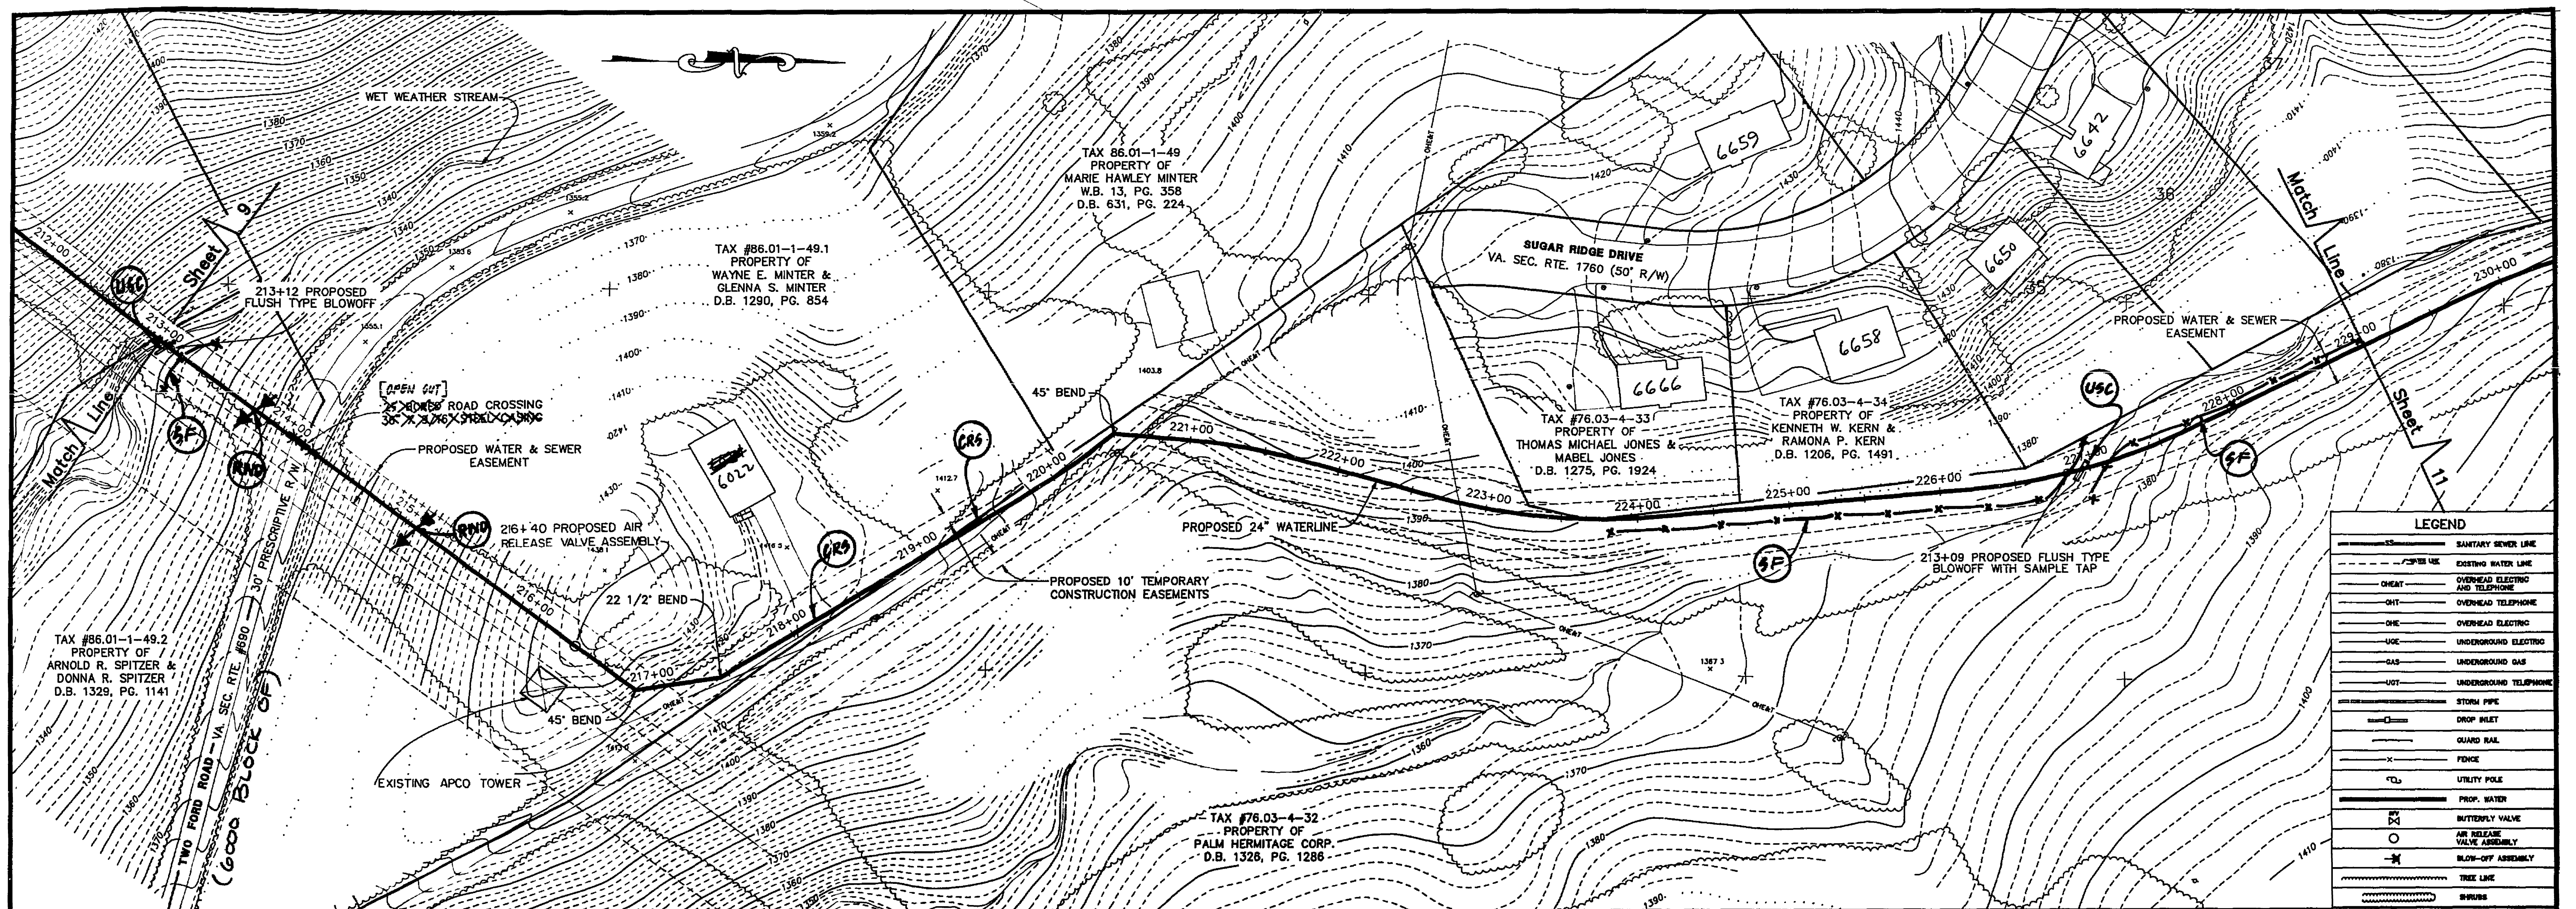

LEGEND	
---	SANITARY SEWER LINE
---	EXISTING WATER LINE
---	OVERHEAD ELECTRIC AND TELEPHONE
---	OVERHEAD ELECTRIC
---	OVERHEAD TELEPHONE
---	UNDERGROUND ELECTRIC
---	UNDERGROUND GAS
---	UNDERGROUND TELEPHONE
---	STORM PIPE
---	DROP INLET
---	GUARD RAIL
---	FENCE
---	UTILITY POLE
---	PROP. WATER
---	BUTTERFLY VALVE
---	AIR RELEASE VALVE ASSEMBLY
---	BLOW-OFF ASSEMBLY
---	TREE LINE
---	SHRUBS
---	TREE
---	SPOT ELEVATION

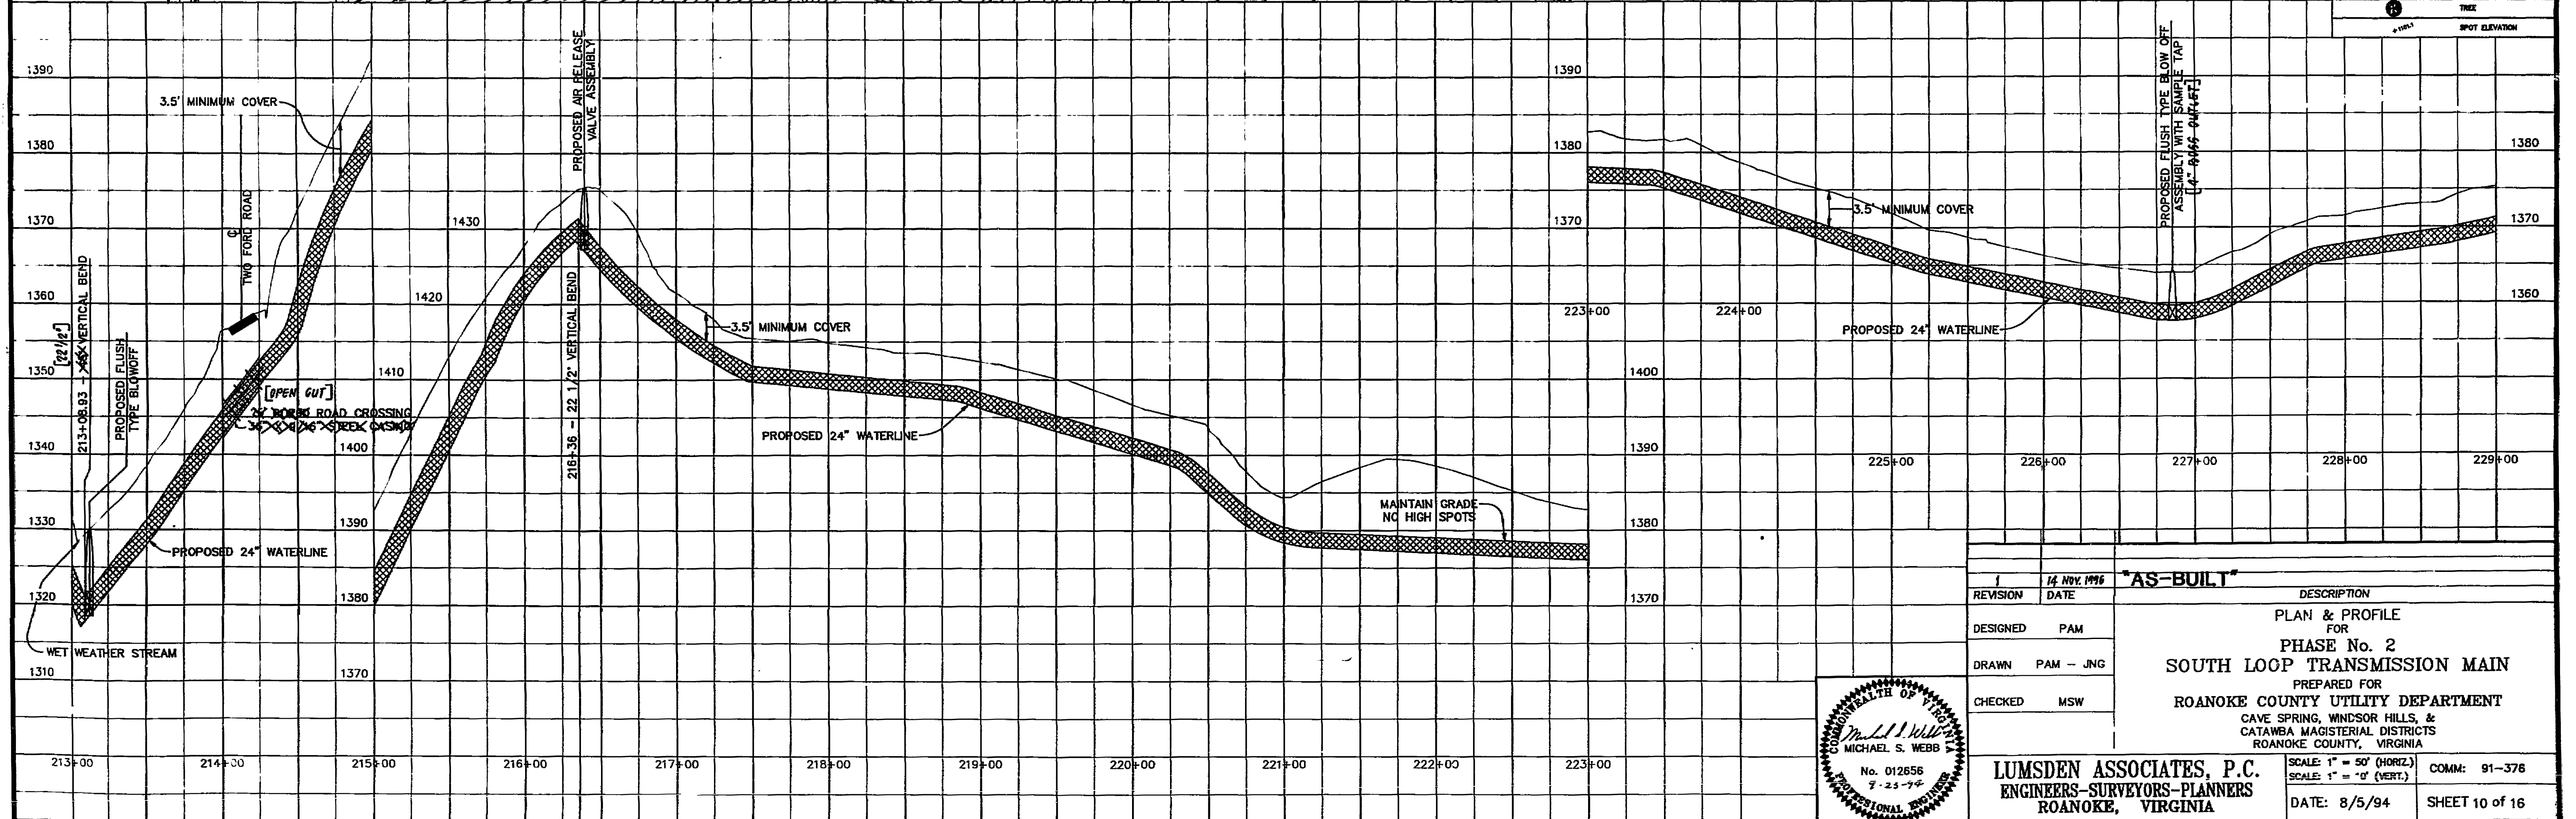

REVISION	14 NOV. 1996	DATE	AS-BUILT
DESIGNED	PAM		
DRAWN	PAM - JNG		
CHECKED	MSW		

DESCRIPTION	
PLAN & PROFILE FOR	
PHASE No. 2	
SOUTH LOOP TRANSMISSION MAIN	
PREPARED FOR	
ROANOKE COUNTY UTILITY DEPARTMENT	
CAVE SPRING, WINDSOR HILLS, & CATAWBA MAGISTERIAL DISTRICTS	
ROANOKE COUNTY, VIRGINIA	

LUMSDEN ASSOCIATES, P.C.	SCALE 1" = 50' (HORIZ.)	COMM: 91-378
ENGINEERS-SURVEYORS-PLANNERS	SCALE 1" = 10' (VERT.)	
ROANOKE, VIRGINIA	DATE: 8/5/94	SHEET 10 of 16