
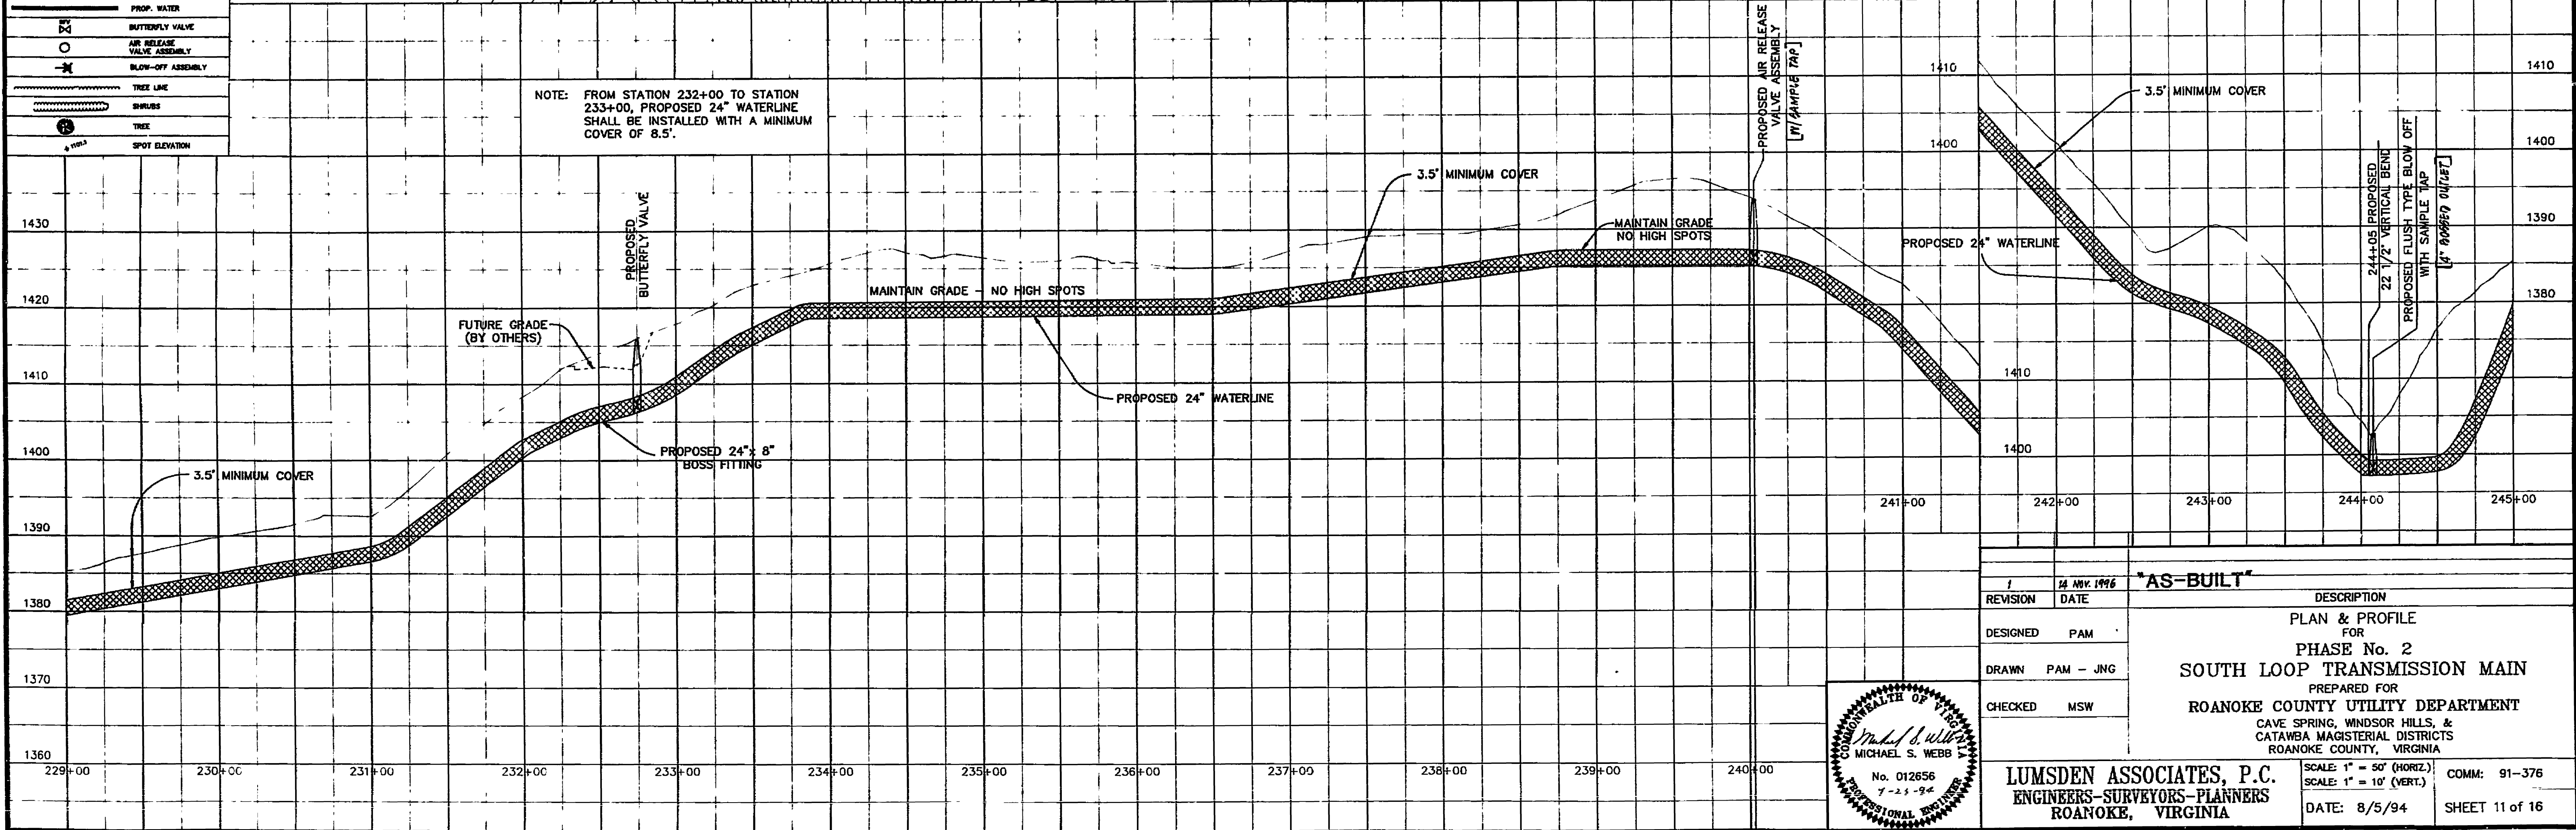


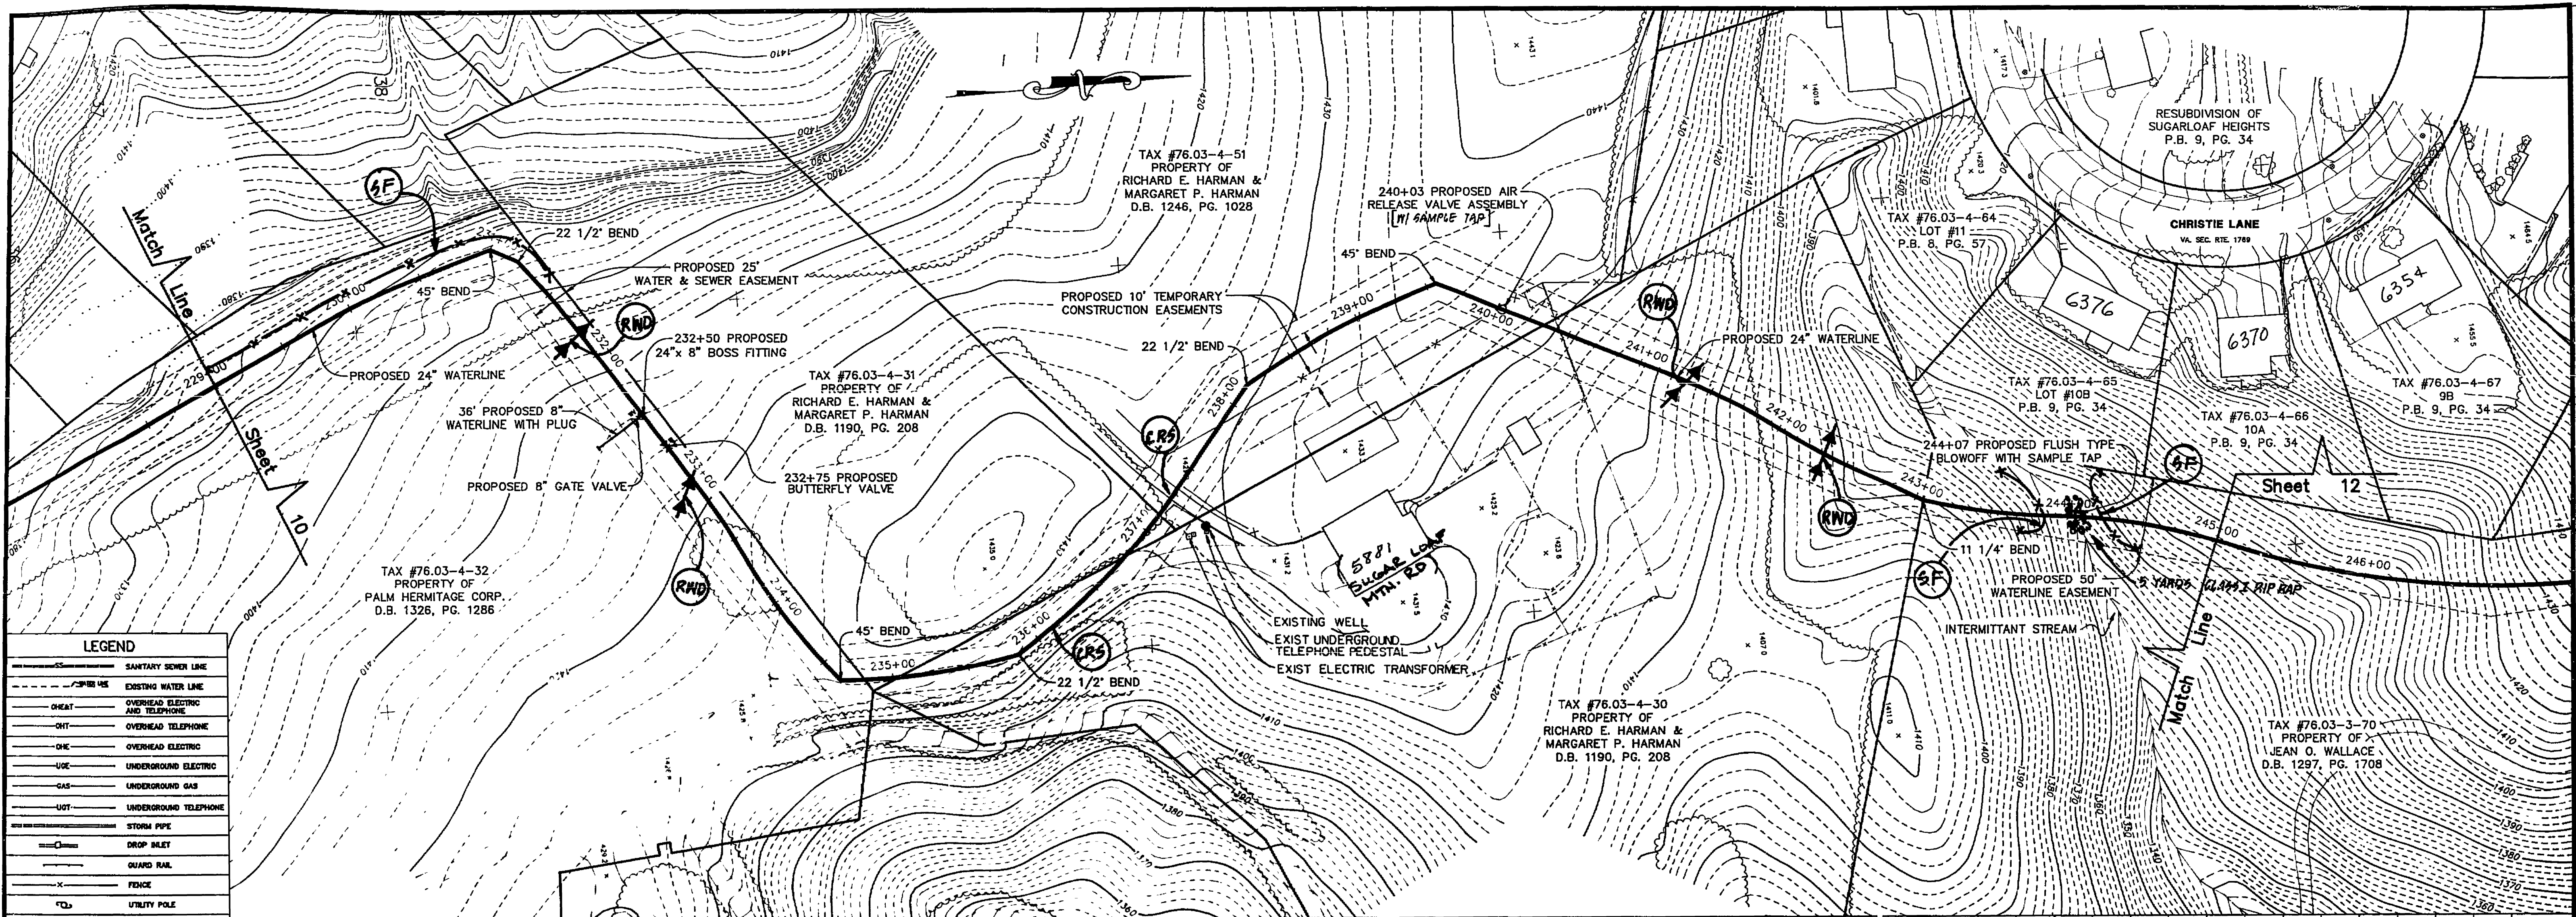

LEGEND

—	SANITARY SEWER LINE
- - -	EXISTING WATER LINE
—	OVERHEAD ELECTRIC AND TELEPHONE
- - -	OVERHEAD TELEPHONE
—	OVERHEAD ELECTRIC
- - -	UNDERGROUND ELECTRIC
- - -	UNDERGROUND GAS
- - -	UNDERGROUND TELEPHONE
- - -	STORM PIPE
- - -	DROP INLET
- - -	GUARD RAIL
- - -	FENCE
- - -	UTILITY POLE
- - -	PROP. WATER
○	BUTTERFLY VALVE
○	AIR RELEASE VALVE ASSEMBLY
○	BLOW-OFF ASSEMBLY
- - -	TREE LINE
- - -	SHRUBS
•	TREE
•	SPOT ELEVATION

NOTE: FROM STATION 232+00 TO STATION 233+00, PROPOSED 24" WATERLINE SHALL BE INSTALLED WITH A MINIMUM COVER OF 8.5'.

1		18 MAY 1996	*AS-BUILT*	
REVISION	DATE		DESCRIPTION	
DESIGNED PAM			PLAN & PROFILE FOR	
DRAWN PAM - JNG			PHASE No. 2	
CHECKED MSW			SOUTH LOOP TRANSMISSION MAIN	
			PREPARED FOR	
			ROANOKE COUNTY UTILITY DEPARTMENT	
			CAVE SPRING, WINDSOR HILLS, & CATAWBA MAGISTERIAL DISTRICTS	
			ROANOKE COUNTY, VIRGINIA	
			LUMSDEN ASSOCIATES, P.C. ENGINEERS-SURVEYORS-PLANNERS ROANOKE, VIRGINIA	
SCALE: 1" = 50' (HORIZ.) SCALE: 1" = 10' (VERT.)			COMM: 91-376 DATE: 8/5/94 SHEET 11 of 16	