
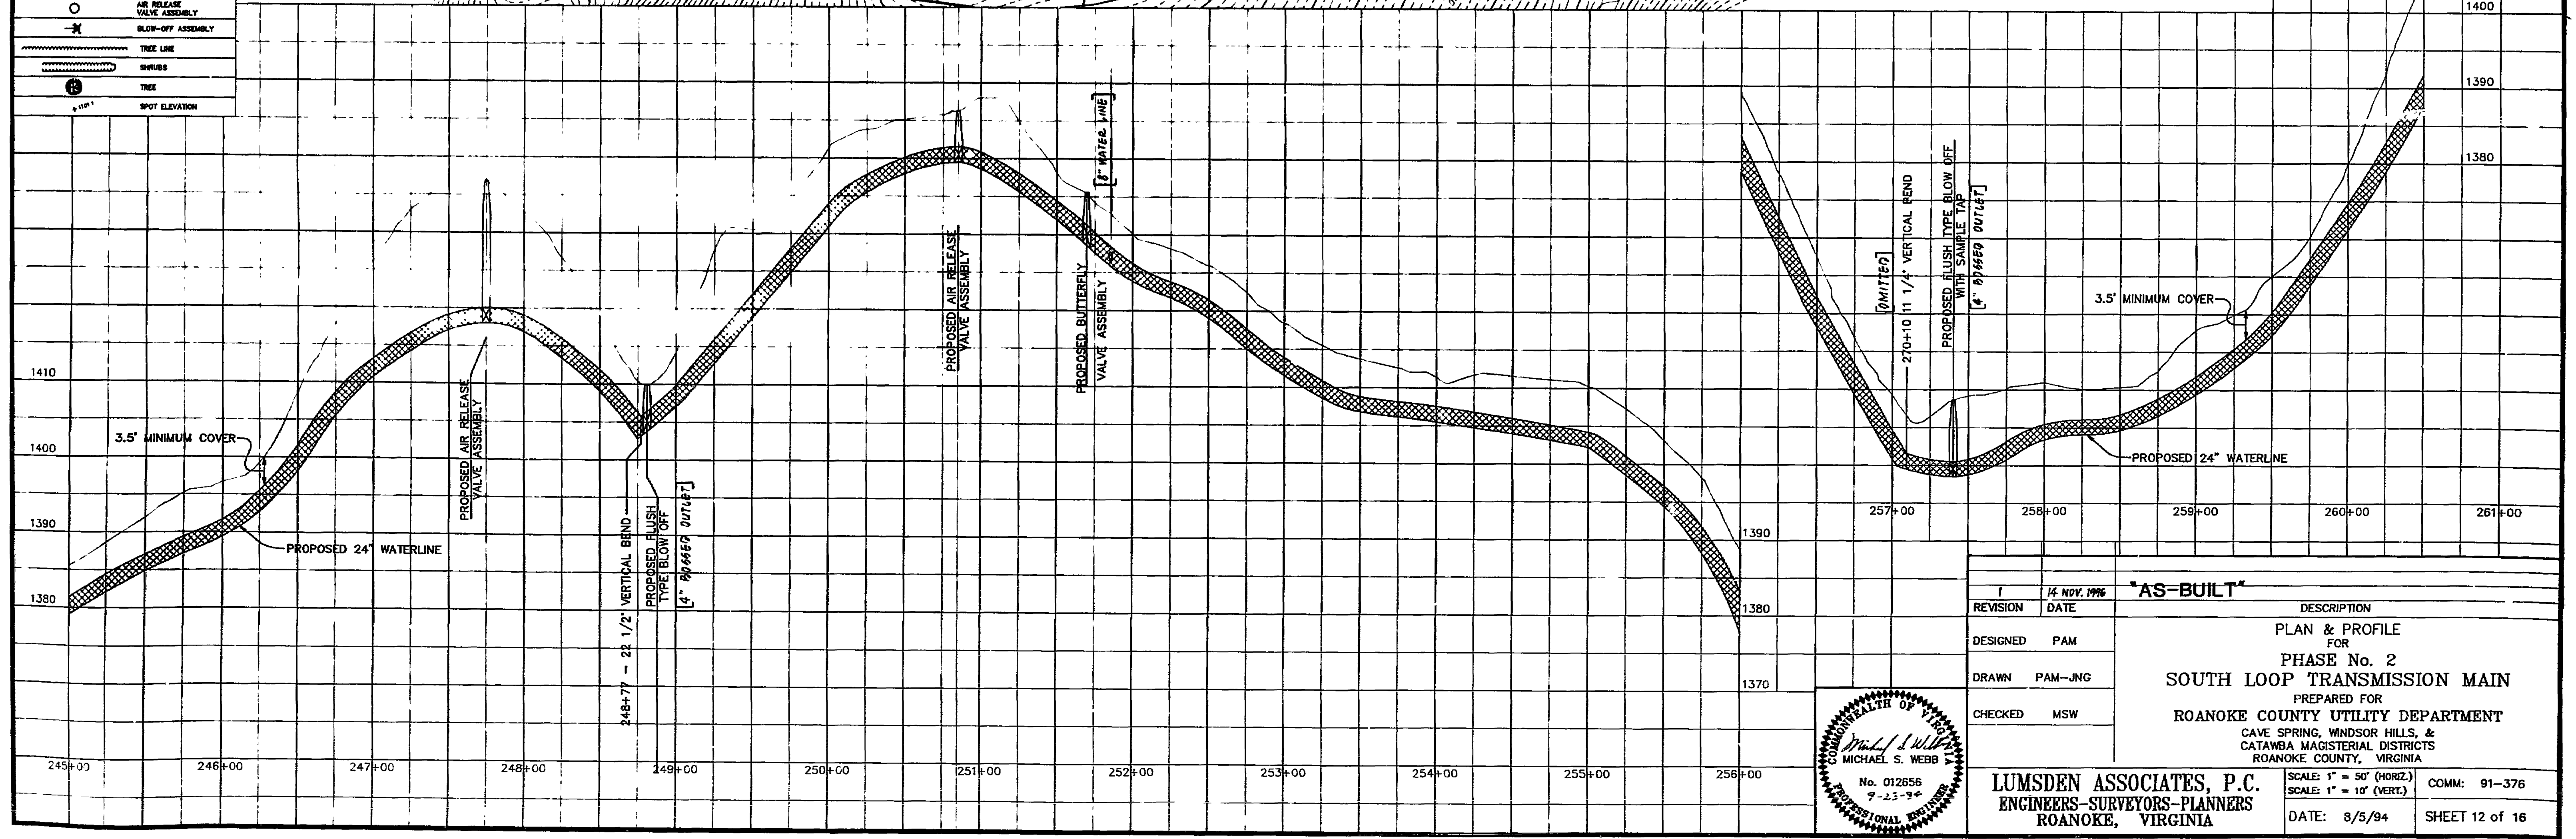


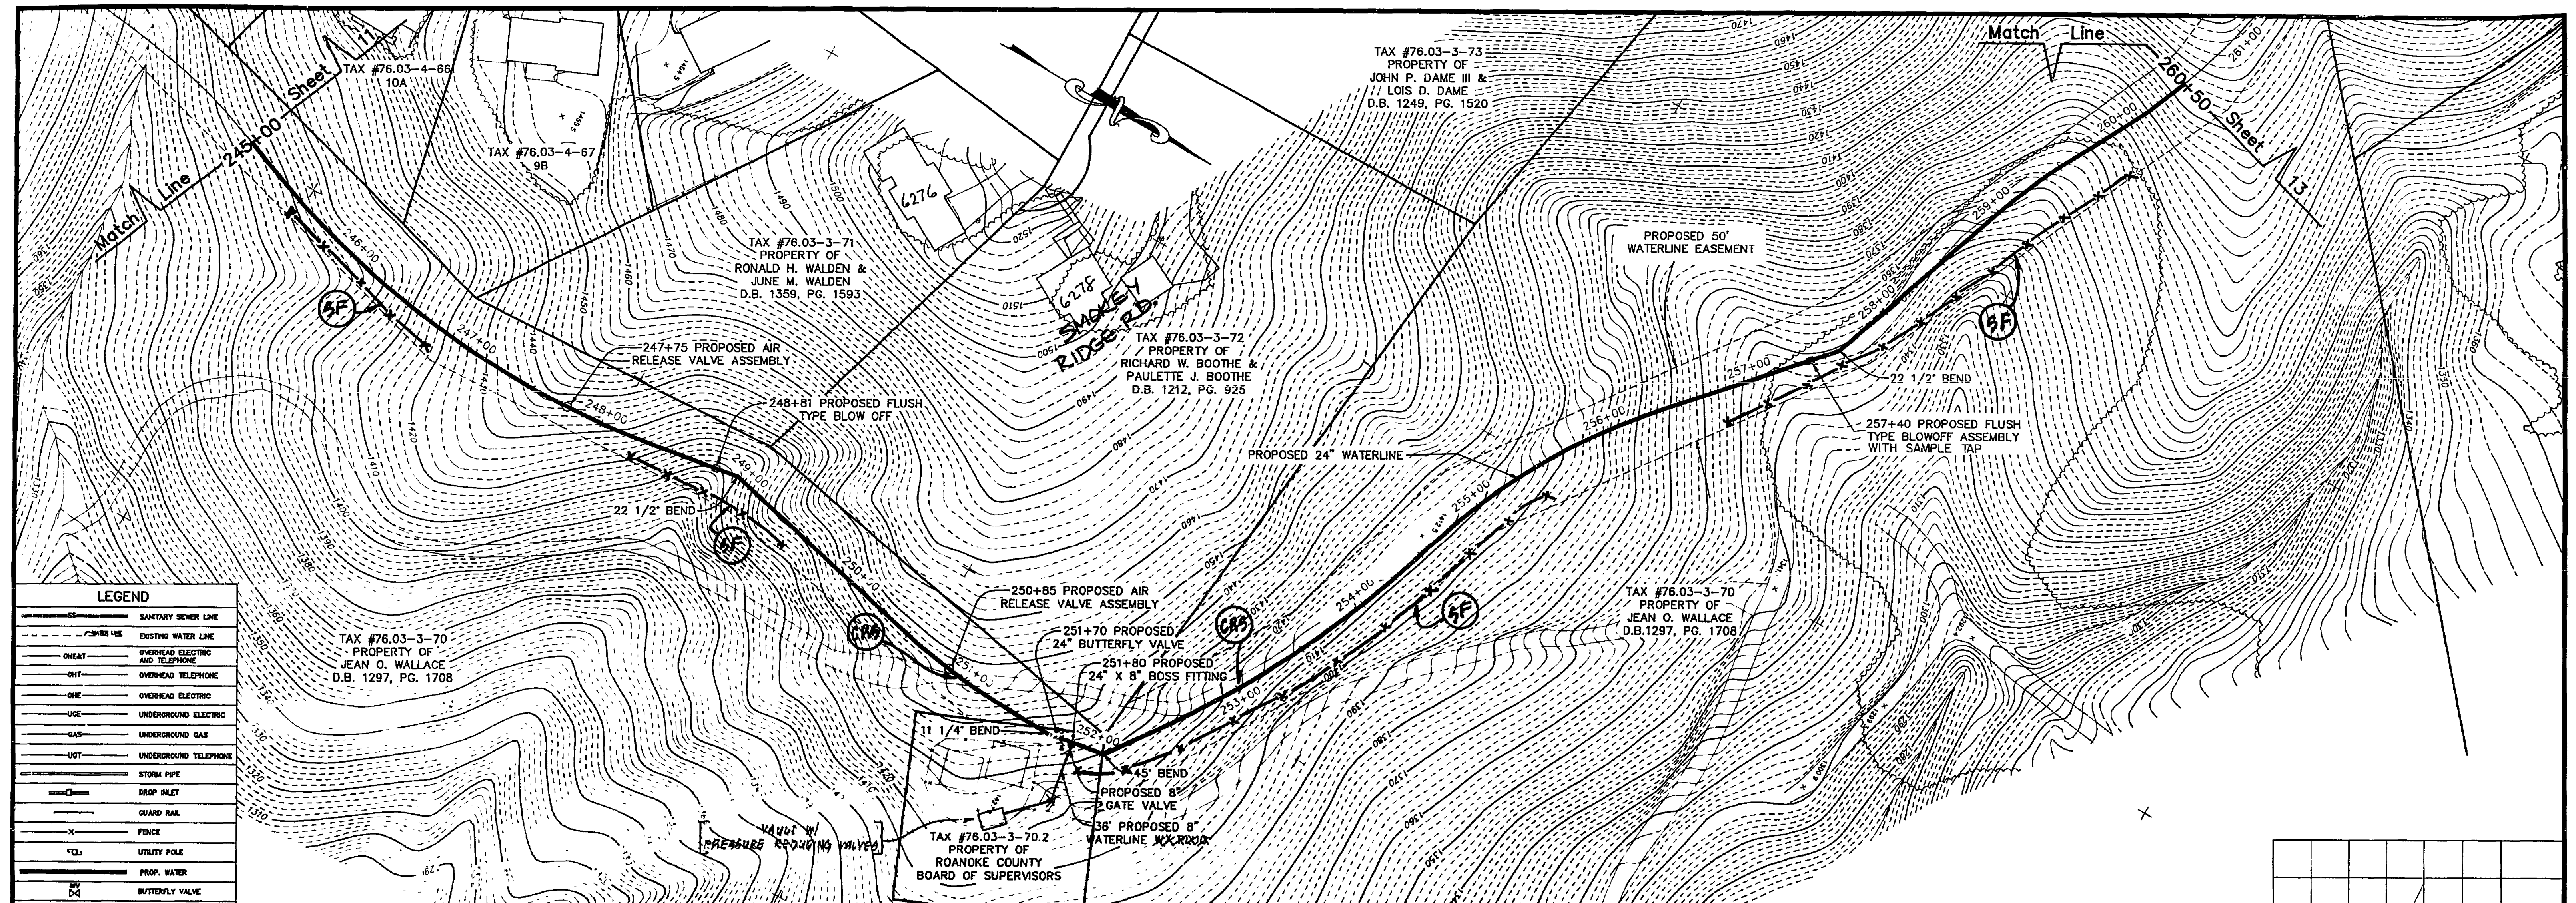

LEGEND	
	SANITARY SEWER LINE
	EXISTING WATER LINE
	OVERHEAD ELECTRIC AND TELEPHONE
	OVERHEAD ELECTRIC
	OVERHEAD TELEPHONE
	UNDERGROUND ELECTRIC
	UNDERGROUND GAS
	UNDERGROUND TELEPHONE
	STORM PIPE
	DROP INLET
	GUARD RAIL
	FENCE
	UTILITY POLE
	PROP. WATER
	BUTTERFLY VALVE
	AIR RELEASE VALVE ASSEMBLY
	BLOW-OFF ASSEMBLY
	TREE LINE
	SHRUB
	TREE
	SPOT ELEVATION

1		14 NOV. 1996	"AS-BUILT"	
REVISION	DATE		DESCRIPTION	
DESIGNED	PAM		PLAN & PROFILE FOR	
			PHASE No. 2	
			SOUTH LOOP TRANSMISSION MAIN	
			PREPARED FOR	
			ROANOKE COUNTY UTILITY DEPARTMENT	
			CAVE SPRING, WINDSOR HILLS, &	
			CATAWBA MAGISTERIAL DISTRICTS	
			ROANOKE COUNTY, VIRGINIA	
LUMSDEN ASSOCIATES, P.C.		SCALE: 1" = 50' (HORIZ.)	COMM: 91-376	
ENGINEERS-SURVEYORS-PLANNERS		SCALE: 1" = 10' (VERT.)		
ROANOKE, VIRGINIA		DATE: 8/5/94	SHEET 12 of 16	

Michael S. Webb
No. 012656
7-23-94
PROFESSIONAL ENGINEER