


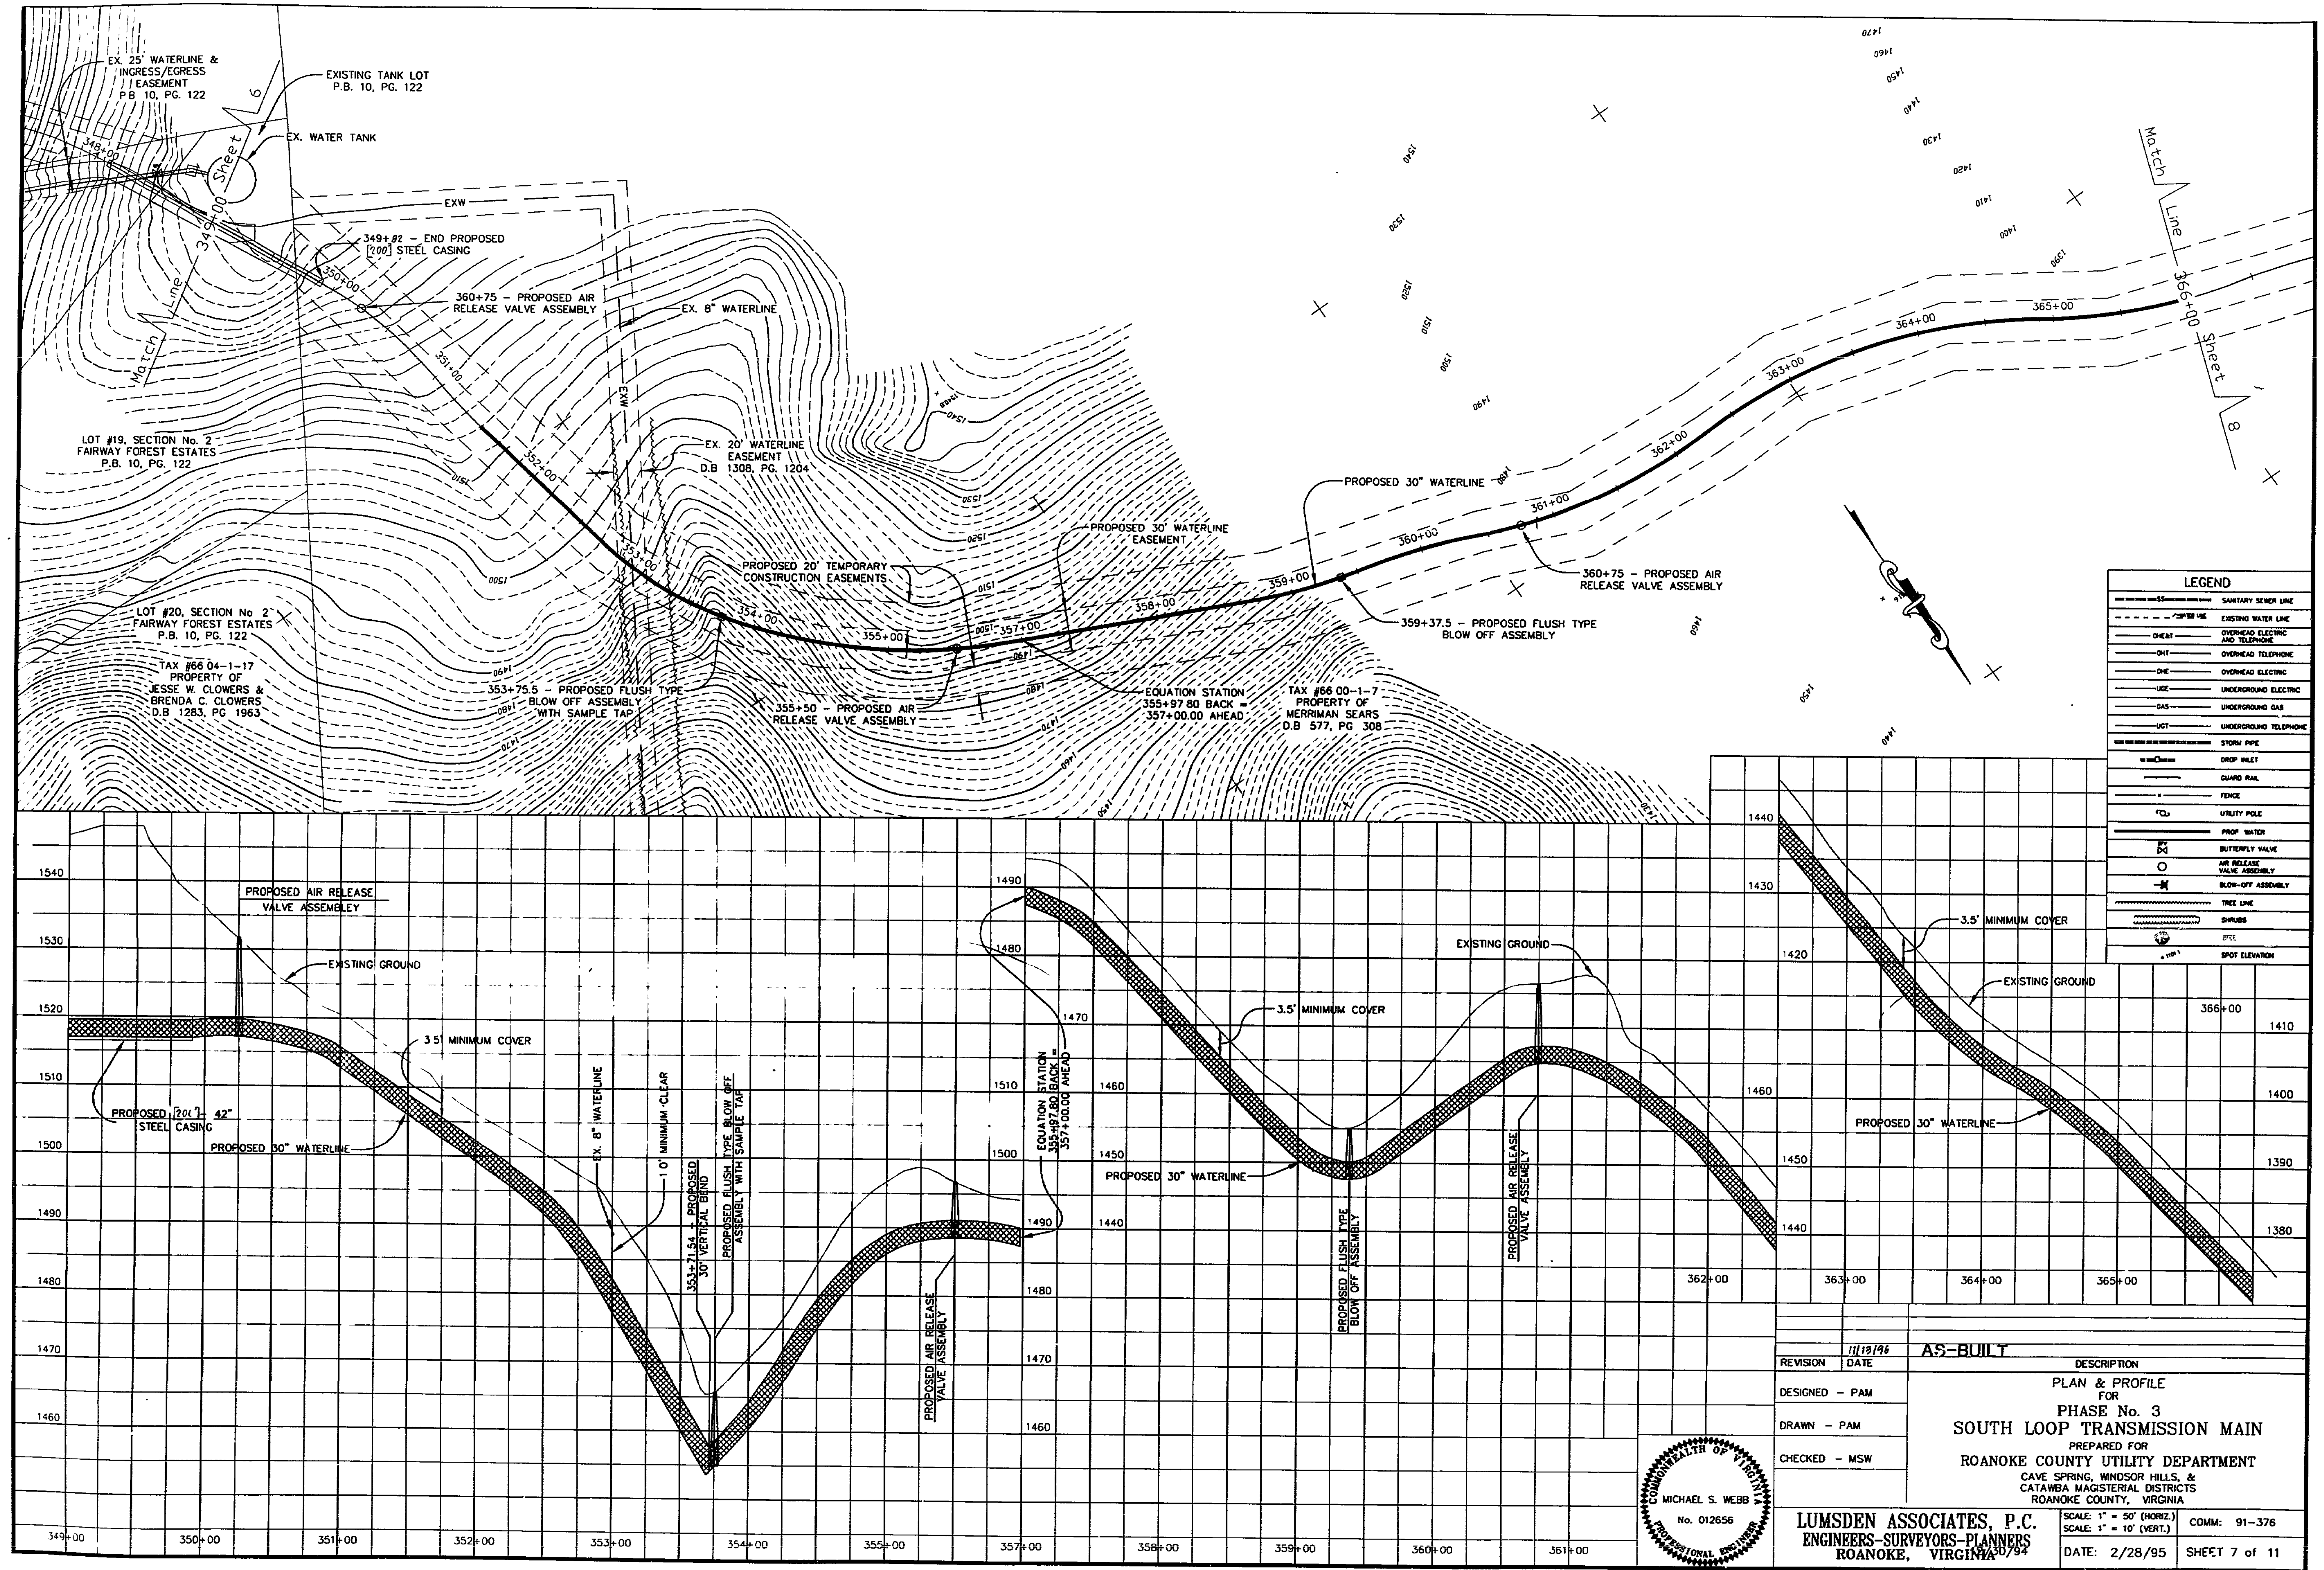

LEGEND	
---	SANITARY SEWER LINE
---	EXISTING WATER LINE
---	OVERHEAD ELECTRIC AND TELEPHONE
---	OVERHEAD ELECTRIC
---	UNDERGROUND ELECTRIC
---	UNDERGROUND GAS
---	UNDERGROUND TELEPHONE
---	STORM PIPE
---	DROP INLET
---	GUARD RAIL
---	FENCE
---	UTILITY POLE
---	PROP. WATER
---	BUTTERFLY VALVE
---	AIR RELEASE VALVE ASSEMBLY
---	BLOW-OFF ASSEMBLY
---	TREE LINE
---	SHRUBS
---	SPOT ELEVATION

REVISION	DATE	DESCRIPTION
DESIGNED - PAM	11/13/96	AS-BUILT
DRAWN - PAM		
CHECKED - MSW		

PLAN & PROFILE FOR
PHASE No. 3
SOUTH LOOP TRANSMISSION MAIN
PREPARED FOR
ROANOKE COUNTY UTILITY DEPARTMENT
CAVE SPRING, WINDSOR HILLS, &
CATAWBA MAGISTERIAL DISTRICTS
ROANOKE COUNTY, VIRGINIA

LUMSDEN ASSOCIATES, P.C.
ENGINEERS-SURVEYORS-PLANNERS
ROANOKE, VIRGINIA

SCALE: 1" = 50' (HORIZ.)
SCALE: 1" = 10' (VERT.)
DATE: 2/28/95
SHEET 7 of 11

COMM. OF VIRGINIA
MICHAEL S. WEBB
No. 012656
Professional Seal