




Mar 23, 2023 8:34am Z:\2022\20221865\Engineering\CAD\20221865_Design_Sheets.dwg

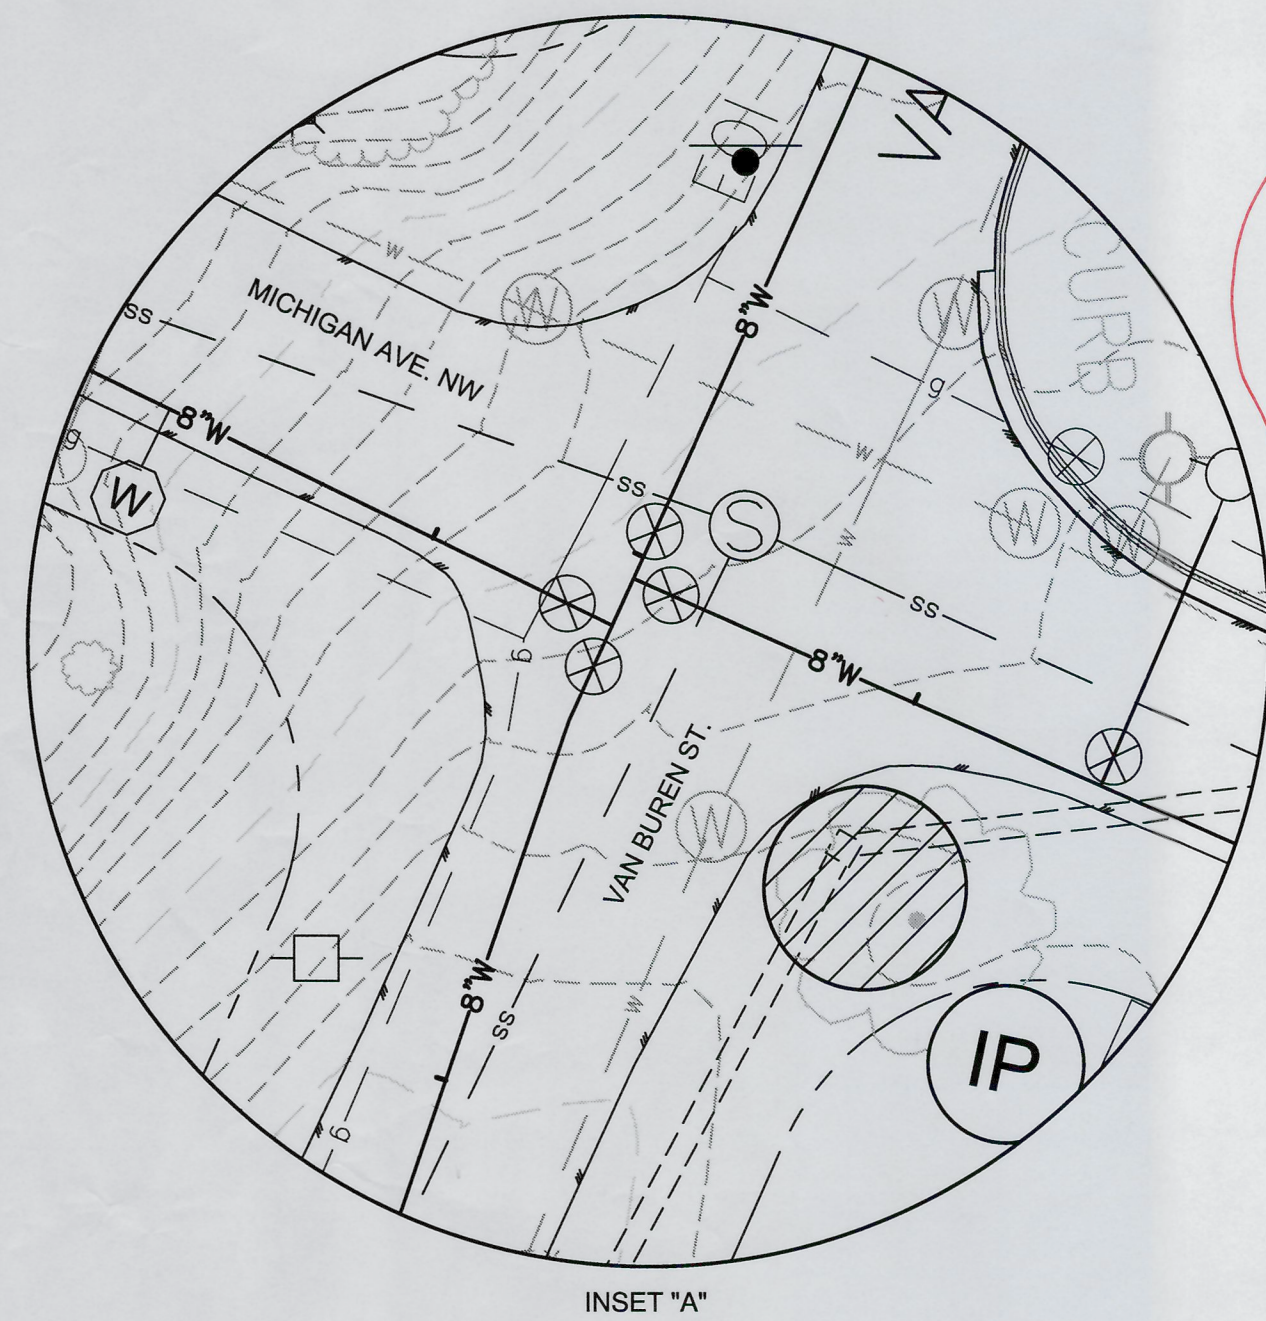

INSET "A"

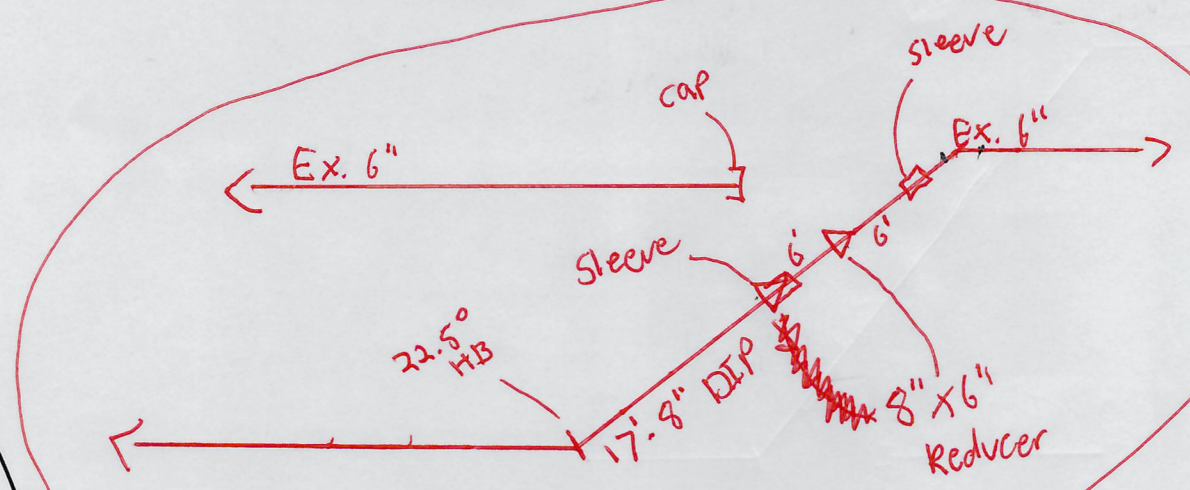

POLK-MICHIGAN ST WATER.

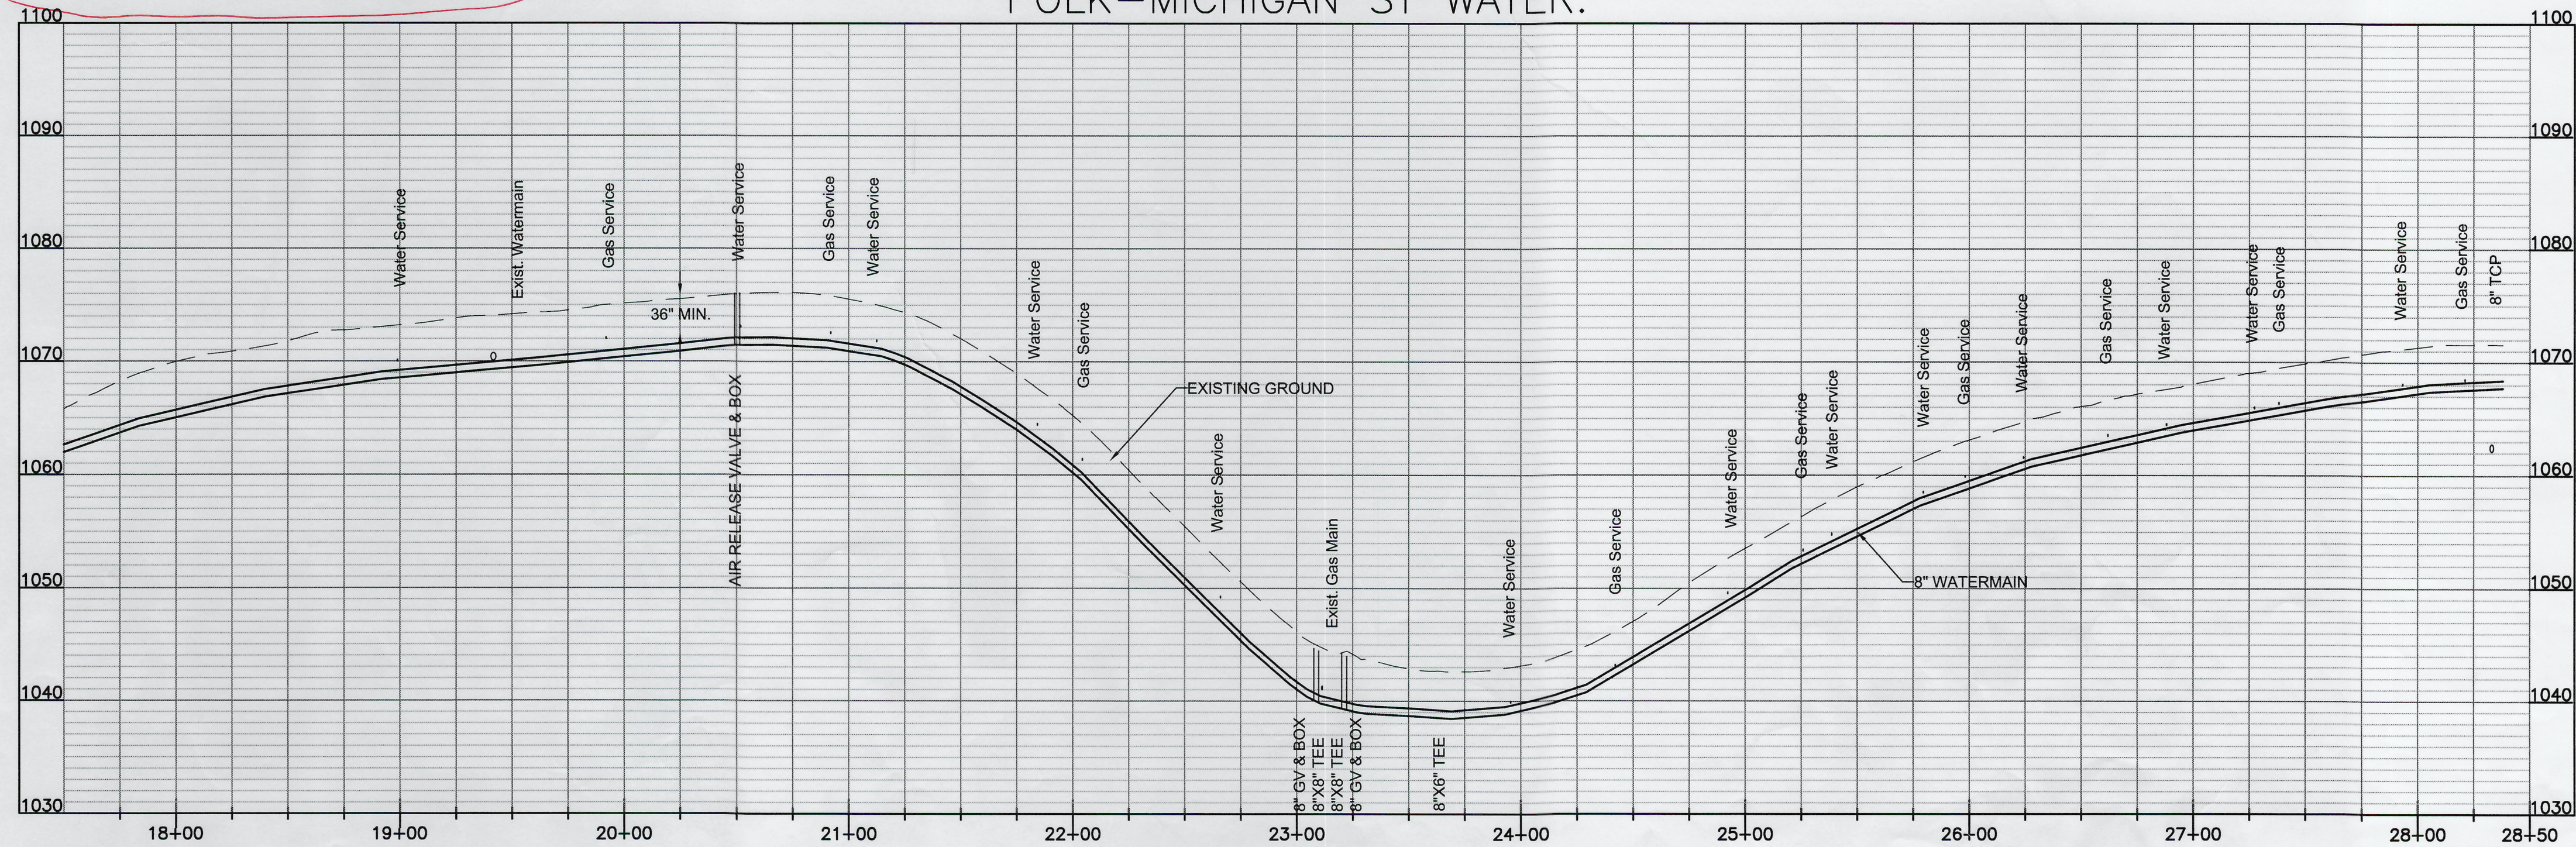


- Replace Existing Water Meter
- Replace Existing Water Meter (not found)
- Air Release or Blow Off Valve
- Gate Valve
- Fire Hydrant
- Pavement Restoration - Patch Private Entrance, per Specifications

- NOTES:
- CONTRACTOR SHALL CONFIRM EXISTING SERVICES MARKED FOR DEMOLITION ARE INACTIVE PRIOR TO DEMOLITION. OWNER WILL ASSIST CONTRACTOR WITH VERIFICATION.
 - CONTRACTOR SHALL PERFORM EXPLORATORY EXCAVATIONS AT UTILITY CROSSINGS TO VERIFY DEPTH PRIOR TO CONSTRUCTION AS DIRECTED BY PROJECT MANUAL.
 - CONTRACTOR SHALL COORDINATE SHUTDOWNS WITH OWNER TO MAINTAIN LOOPED FLOW TO EACH STREET DURING CONSTRUCTION.
 - ALL DENUDE AREAS DISTURBED BY THE WORK SHALL BE RESTORED USING TEMPORARY SEEDING, PERMANENT SEEDING, AND MULCHING.

PLAN & PROFILE
SOUTH WASHINGTON HEIGHTS
WATER SYSTEM IMPROVEMENTS
ROANOKE, VA.

PROJECT NO. 20221865
LAT. 36.911436
LONG. -80.318494
DATE: 20 MAR 23
DRAWN BY: CBD
CHECKED BY: DAA

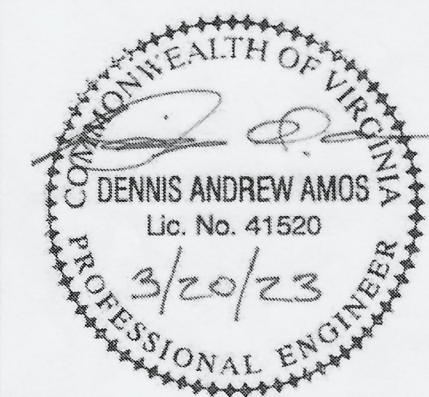

PLAN &
PROFILE

HURT & PROFFITT

SHEET NO. C102
REV.

HURT & PROFFITT
INSPIRED / RESPONSIVE / TRUSTED



540.552.5592
1861 PRATT DR, STE 1100
BLACKSBURG, VA 24060
HANDP.COM
ENGINEERING • LAND DEVELOPMENT • ENVIRONMENTAL
GEOTECHNICAL • CONSTRUCTION TESTING & INSPECTION • CULTURAL RESOURCES