

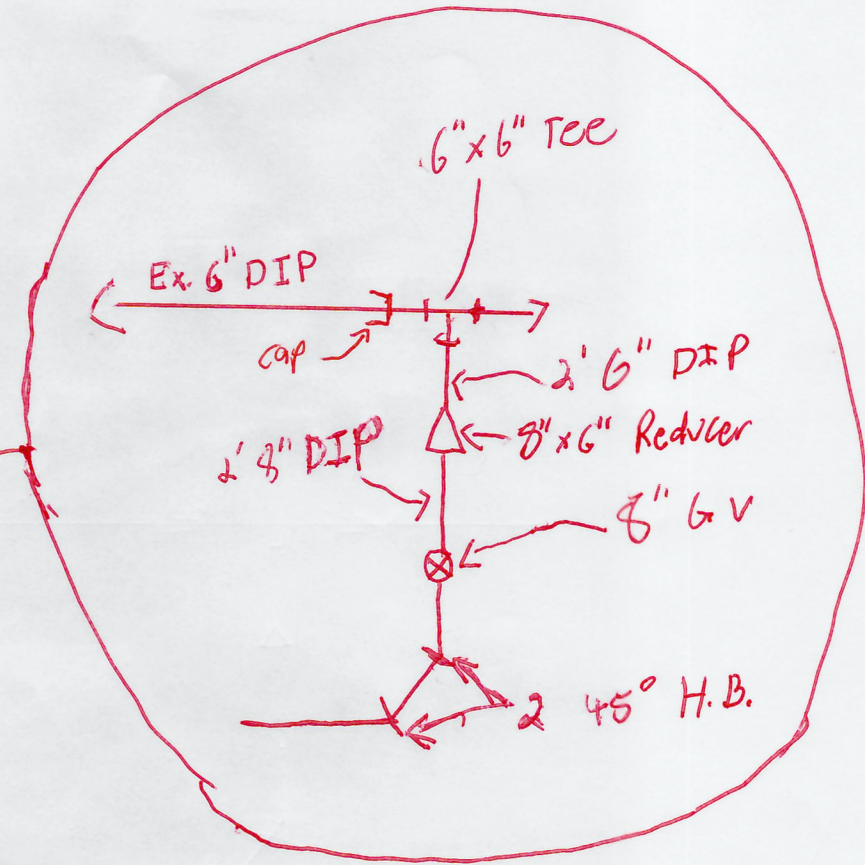


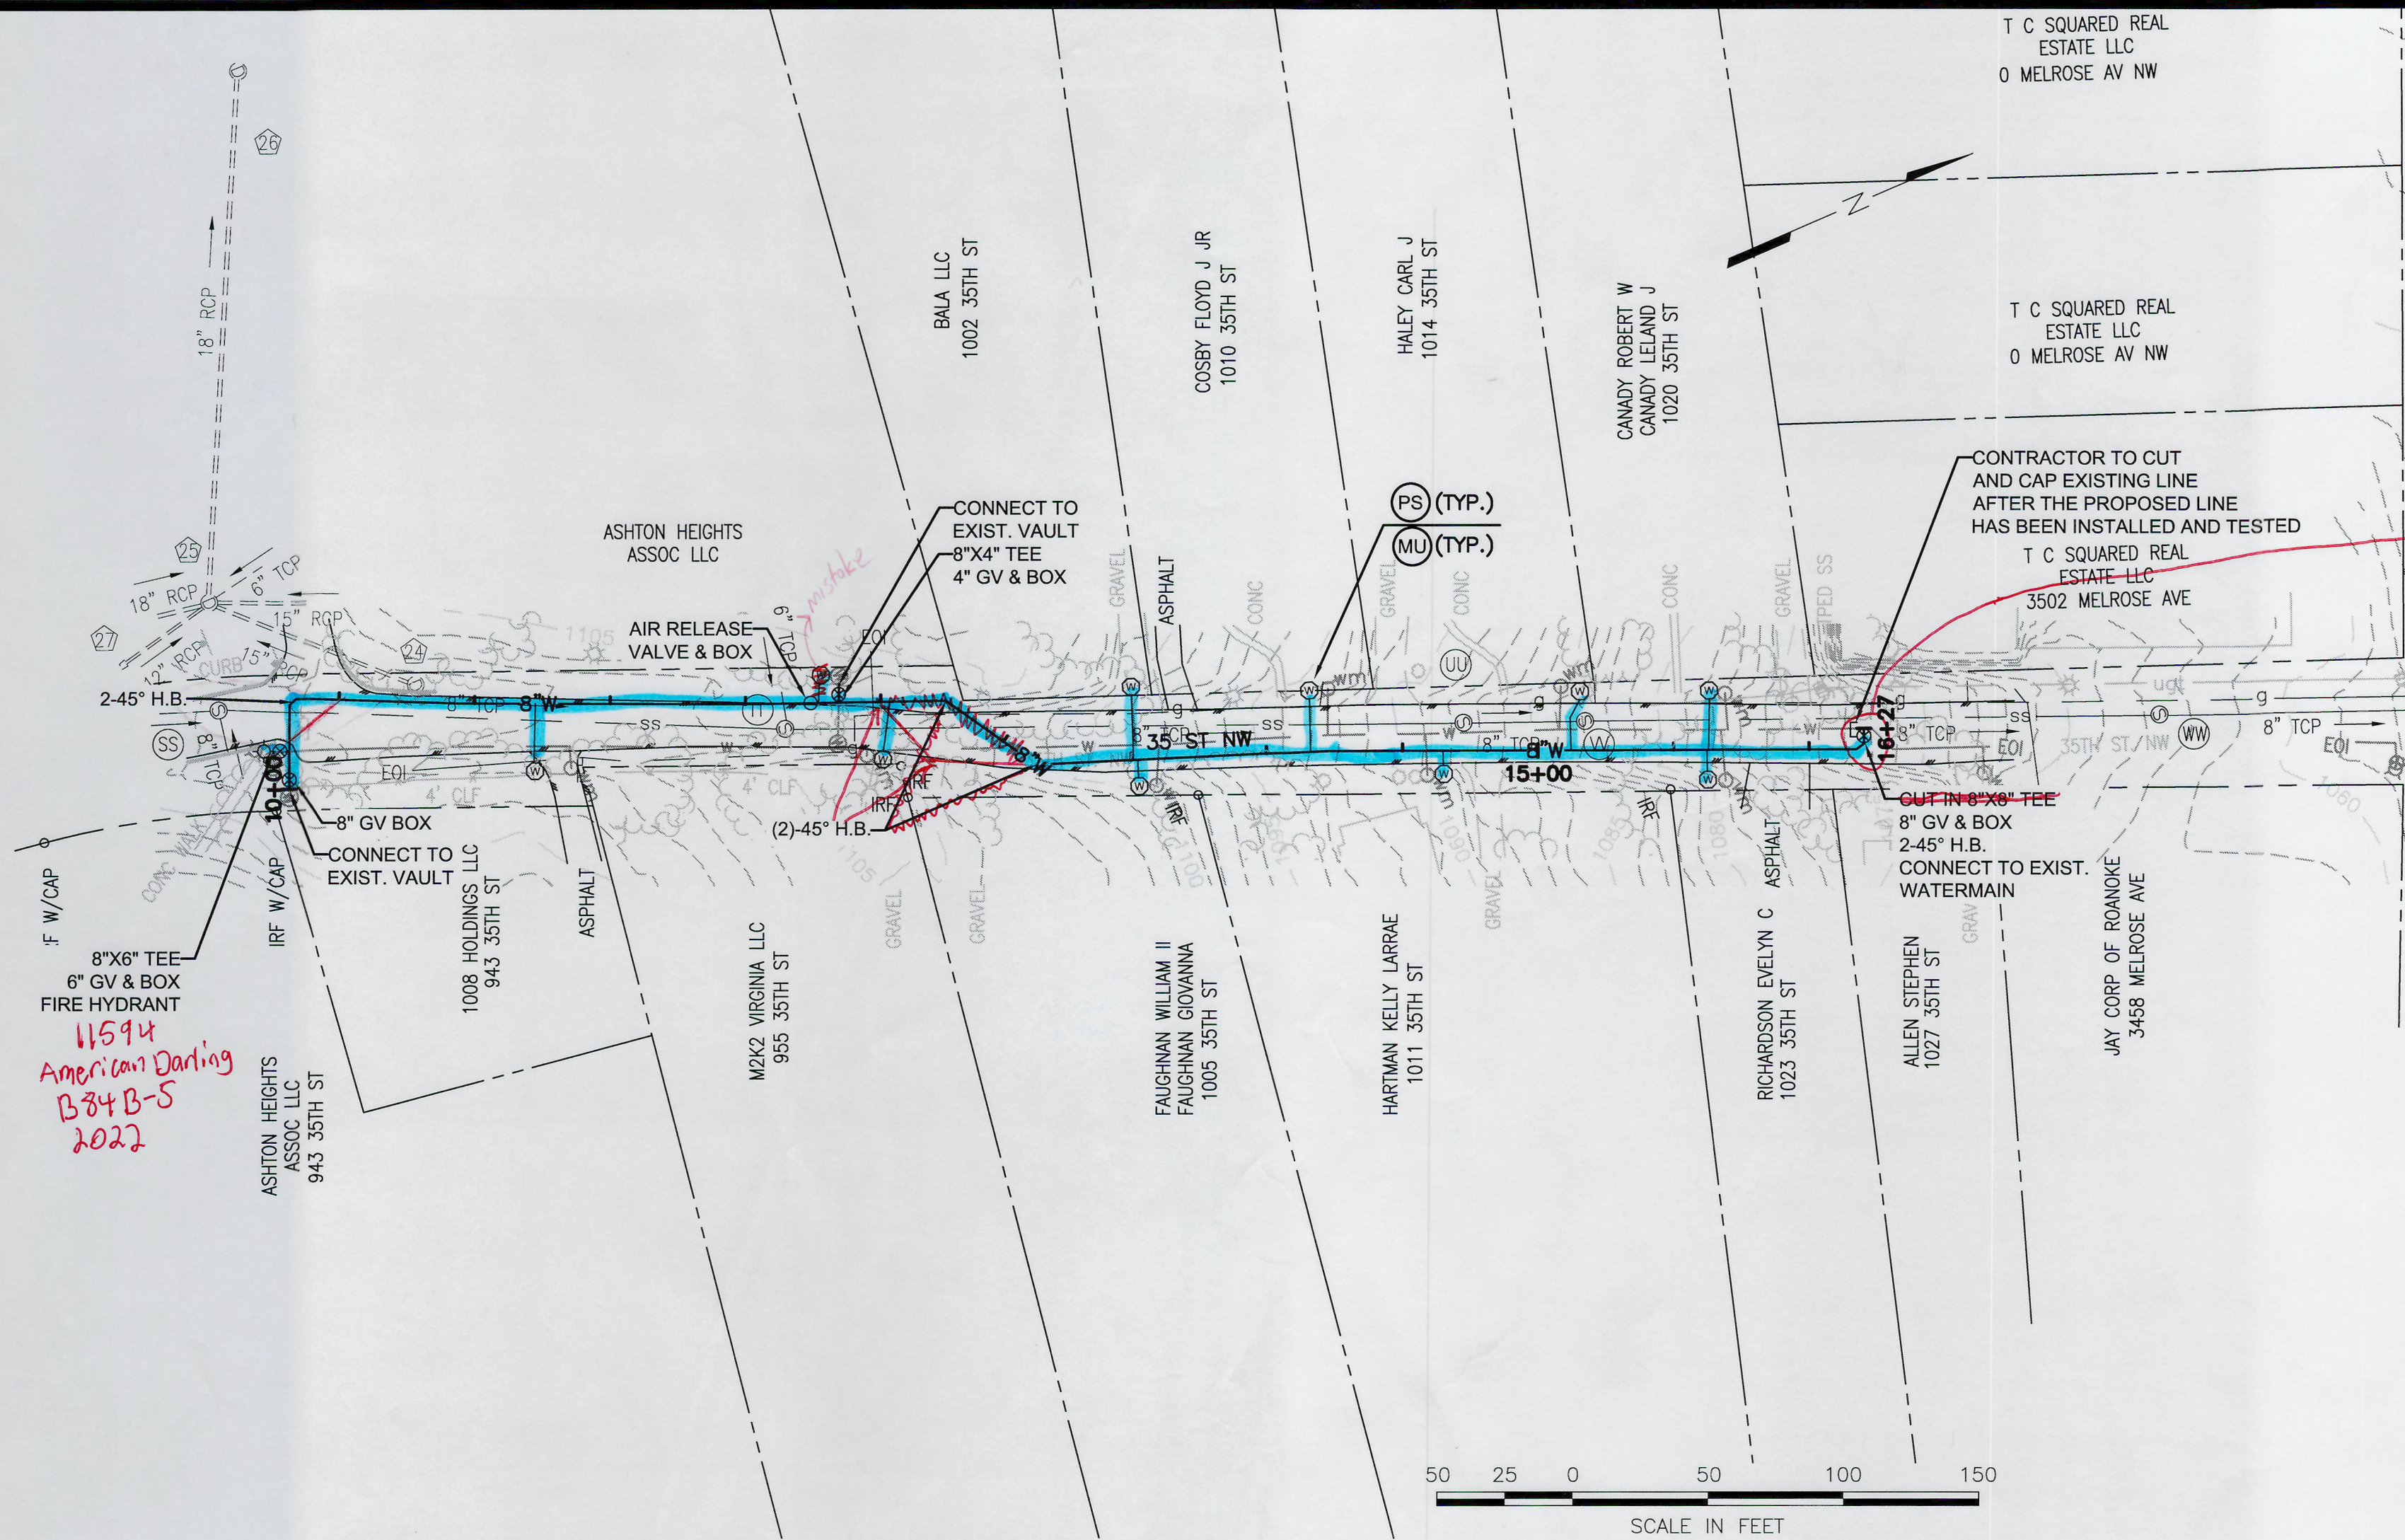

- NOTES:
1. CONTRACTOR SHALL CONFIRM EXISTING SERVICES MARKED FOR DEMOLITION ARE INACTIVE PRIOR TO DEMOLITION. OWNER WILL ASSIST CONTRACTOR WITH VERIFICATION.
 2. CONTRACTOR SHALL PERFORM EXPLORATORY EXCAVATIONS AT UTILITY CROSSINGS TO VERIFY DEPTH PRIOR TO CONSTRUCTION AS DIRECTED BY PROJECT MANUAL.
 3. CONTRACTOR SHALL COORDINATE SHUTDOWNS WITH OWNER TO MAINTAIN LOOPED FLOW TO EACH STREET DURING CONSTRUCTION.
 4. ALL DENUDED AREAS DISTURBED BY THE WORK SHALL BE RESTORED USING TEMPORARY SEEDING, PERMANENT SEEDING, AND MULCHING.

- ⊗ Replace Existing Water Meter
- ⊙ Replace Existing Water Meter (not found)
- Air Release or Blow Off Valve
- ⊕ Gate Valve
- ⊛ Fire Hydrant
- ▨ Pavement Restoration - Patch Private Entrance, per Specifications

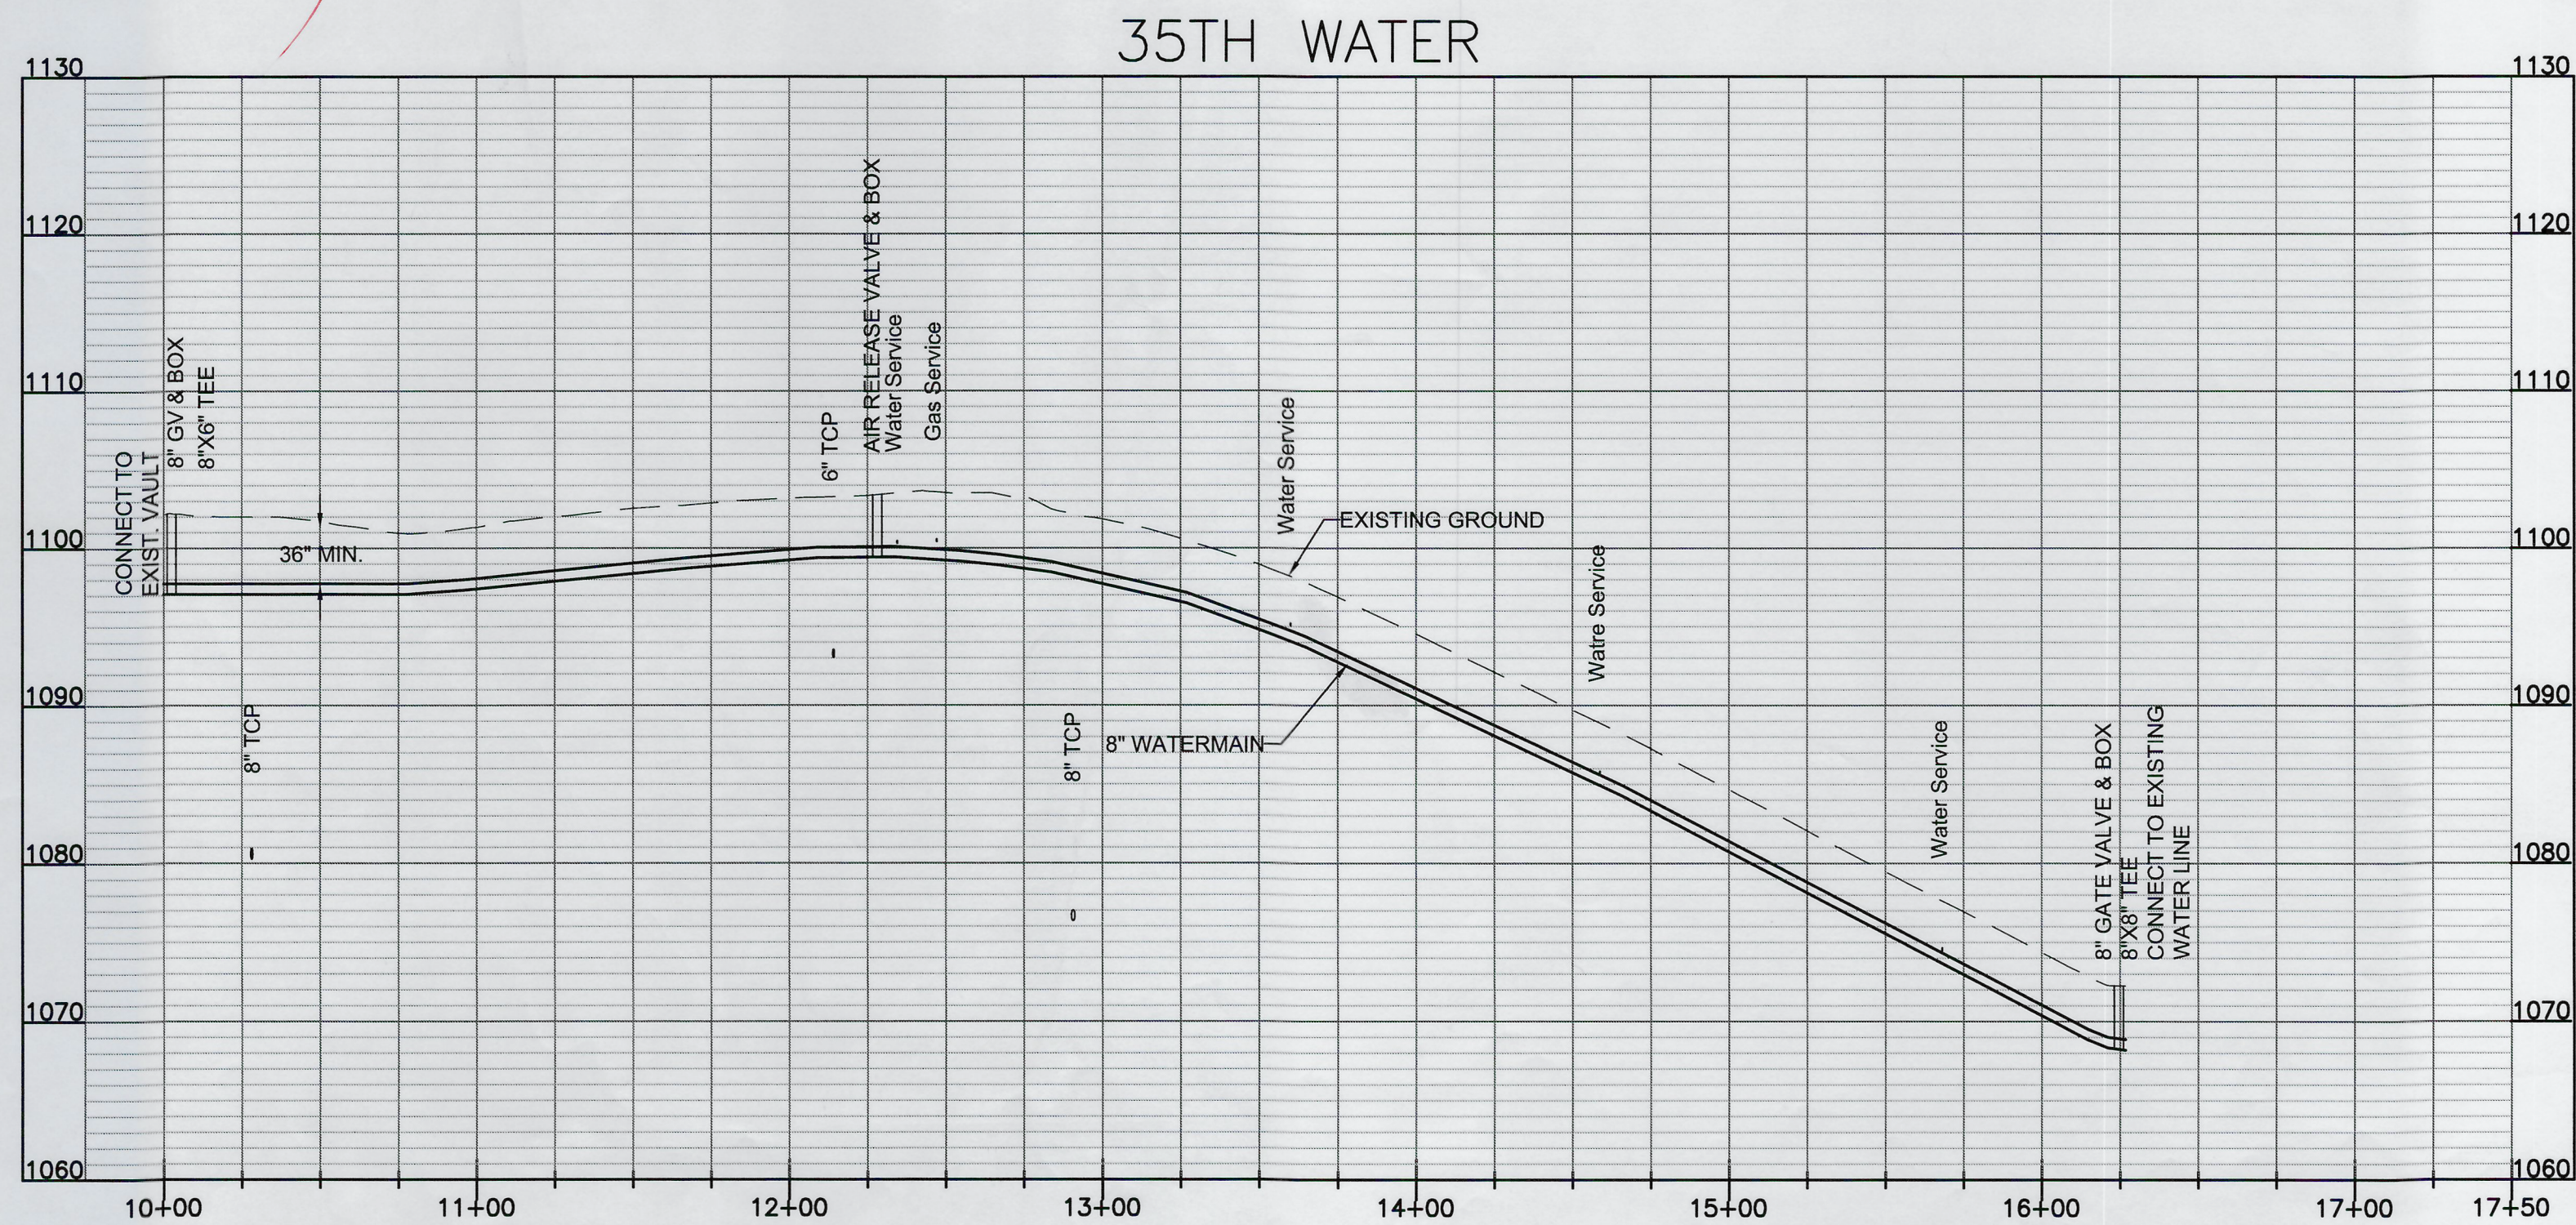


HURT & PROFFITT
INSPIRED / RESPONSIVE / TRUSTED



HANDP.COM
BLACKSBURG, VA 24060
1861 PRATT DR, STE 1100
ENGINEERS • SURVEYORS • LAND DEVELOPMENT • ENVIRONMENTAL
GEOLOGICAL • CONSTRUCTION TESTING & INSPECTION • CULTURAL RESOURCES

PLAN & PROFILE
SOUTH WASHINGTON HEIGHTS
WATER SYSTEM IMPROVEMENTS
ROANOKE, VA.

PROJECT NO. 20221865
LAT. 36.911436
LONG. -80.318494
DATE: 20 MAR 23
DRAWN BY: CBD
CHECKED BY: DAA

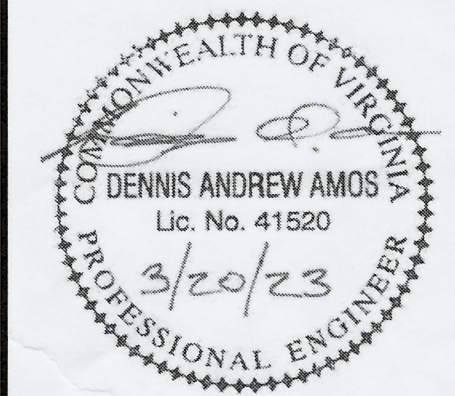

**PLAN &
PROFILE**

HURT & PROFFITT
SHEET NO. C105
REV.