


Mar 23, 2023 - 8:34am Z:\2022\20221865\Engineering\CAD\20221865_Design_Sheets.dwg


- ⊙ Replace Existing Water Meter
- ⊙ Replace Existing Water Meter (not found)
- ⊙ Air Release or Blow Off Valve
- ⊙ Gate Valve
- ⊙ Fire Hydrant
- ▨ Pavement Restoration - Patch Private Entrance, per Specifications

8" GV & BOX
8"x6" REDUCER
FIRE HYDRANT
American Darling
B84B-5
2022
10215

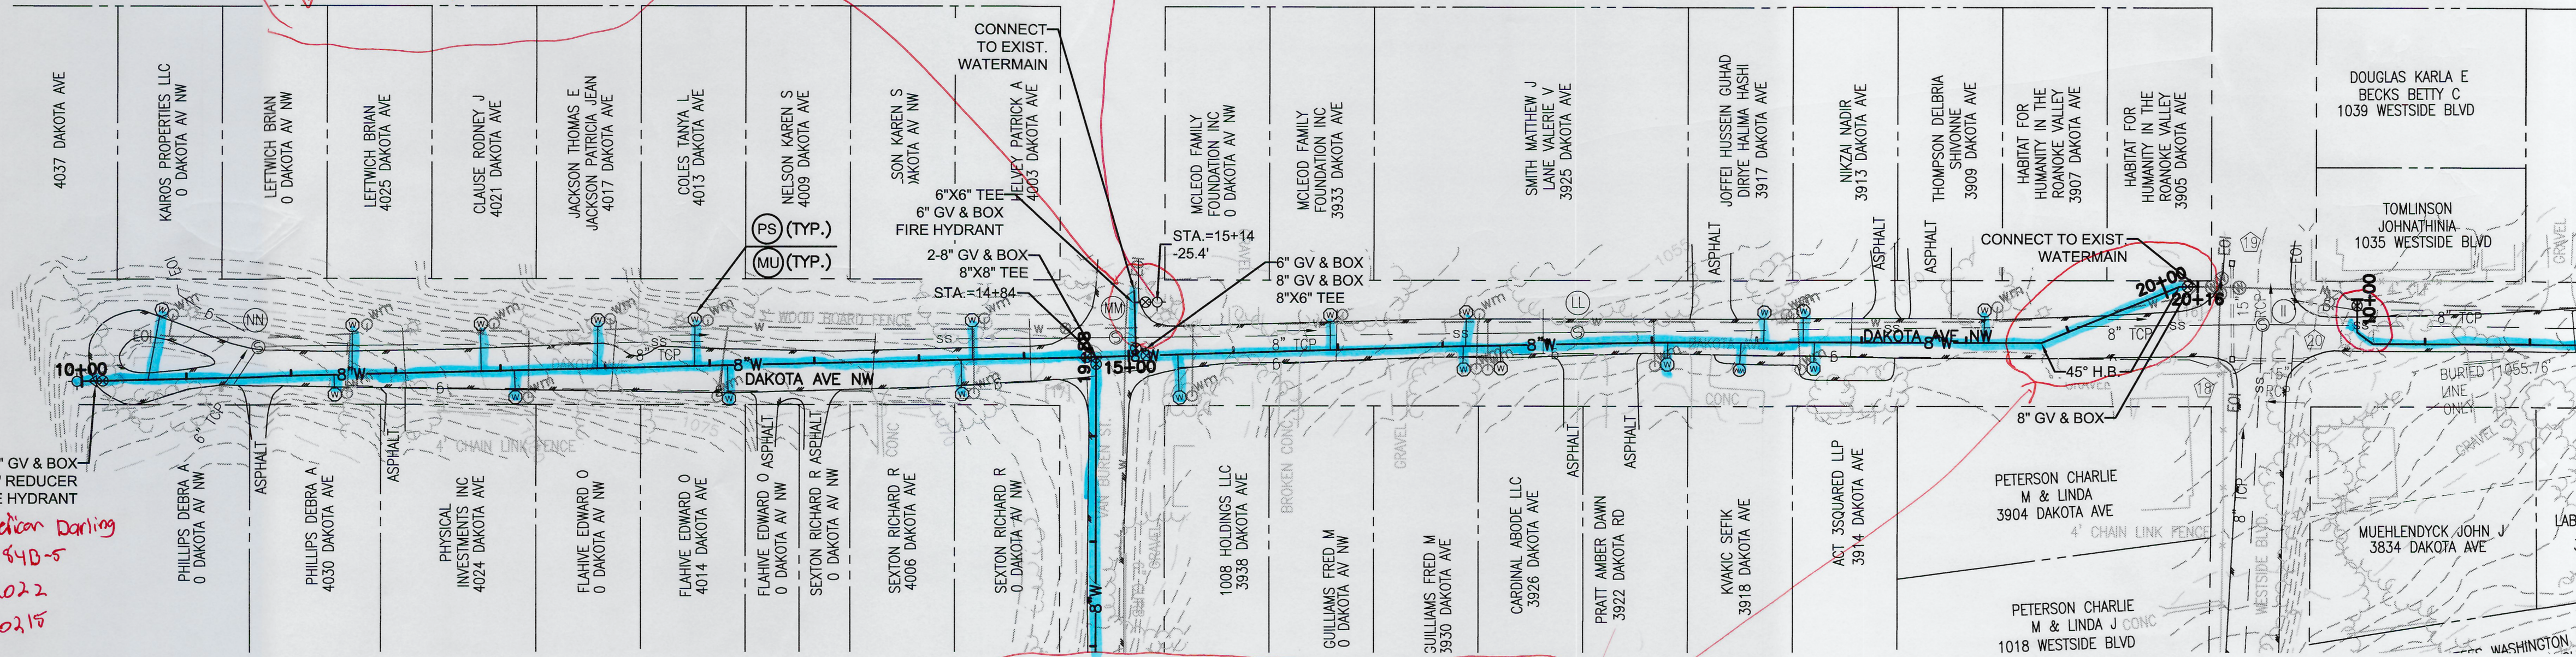

- NOTES:
1. CONTRACTOR SHALL CONFIRM EXISTING SERVICES MARKED FOR DEMOLITION ARE INACTIVE PRIOR TO DEMOLITION. OWNER WILL ASSIST CONTRACTOR WITH VERIFICATION.
 2. CONTRACTOR SHALL PERFORM EXPLORATORY EXCAVATIONS AT UTILITY CROSSINGS TO VERIFY DEPTH PRIOR TO CONSTRUCTION AS DIRECTED BY PROJECT MANUAL.
 3. CONTRACTOR SHALL COORDINATE SHUTDOWNS WITH OWNER TO MAINTAIN LOOPED FLOW TO EACH STREET DURING CONSTRUCTION.
 4. ALL DENUDED AREAS DISTURBED BY THE WORK SHALL BE RESTORED USING TEMPORARY SEEDING, PERMANENT SEEDING, AND MULCHING.

DAKOTA AVE WATER

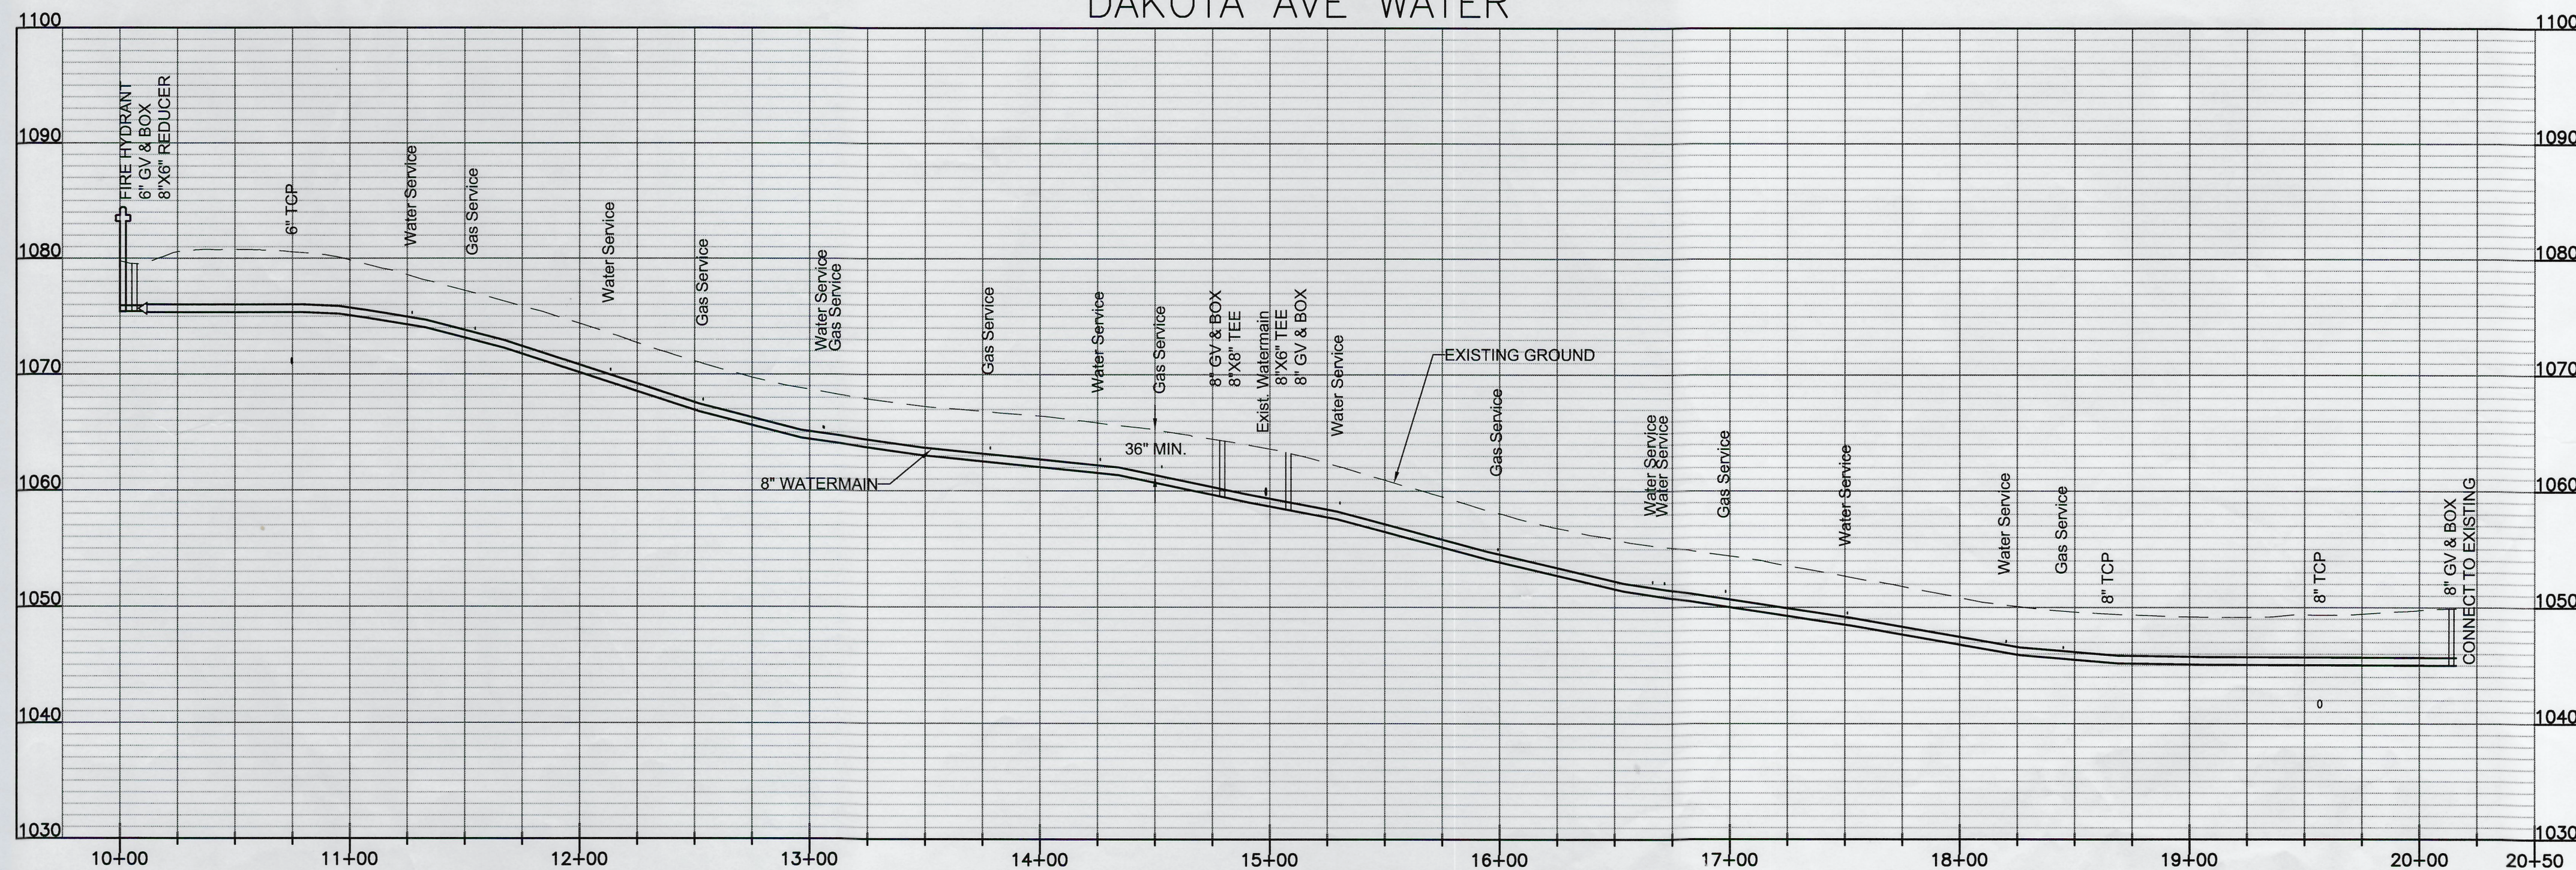

HURT & PROFFITT

INSPIRED / RESPONSIVE / TRUSTED




HANDP.COM
BLACKSBURG, VA 24060
ENGINEERING • SURVEYING • LAND DEVELOPMENT • ENVIRONMENTAL
CONSTRUCTION TESTING & INSPECTION • CULTURAL RESOURCES

1861 PRATT DR, STE 1100

PLAN & PROFILE SOUTH WASHINGTON HEIGHTS WATER SYSTEM IMPROVEMENTS ROANOKE, VA.

PROJECT NO. 20221865
LAT. 36.911436
LONG. -80.318494
DATE: 20 MAR 23
DRAWN BY: CBD
CHECKED BY: DAA

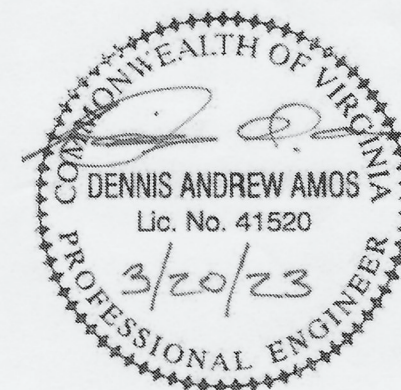

PLAN &
PROFILE

HURT & PROFFITT

SHEET NO.
C106

REV.