




The profile view of the Van Buren St Water main shows the following details:

- Vertical Axis:** Elevation in feet, ranging from 1010 to 1090.
- Horizontal Axis:** Stationing, ranging from 10+00 to 20+00.
- Existing Ground:** Represented by a dashed line.
- Proposed Water Main:** Represented by a solid line.
- Key Features and Structures:**
 - 10+00:** CONNECT TO EXIST. WATERMAIN, 8" TCP
 - 11+00:** Gas Service, Water Service
 - 12+00:** 24" RCP, 8" GV & BOX, 8" X 8" TEE, 8" GV & BOX
 - 13+00:** 24" RCP, Water Service, Gas Service, Water Service
 - 14+00:** 36" MIN., 8" TCP, Water Service RCP Pipe
 - 15+00:** 8" TCP
 - 16+00:** 8" GV & BOX, 8" X 8" TEE, 8" GV & BOX, 8" TCP, Exist. Watermain Water Service
 - 17+00:** 8" WATERMAIN
 - 19+00:** EXIST. Gas Main, 8" GV & BOX, CONNECT TO PROPOSED WATERMAIN

PROJECT NO.	20221865
LAT.	36.911436
LONG.	-80.318494
DATE:	20 MAR 23
DRAWN BY:	CBD
CHECKED BY:	DAA

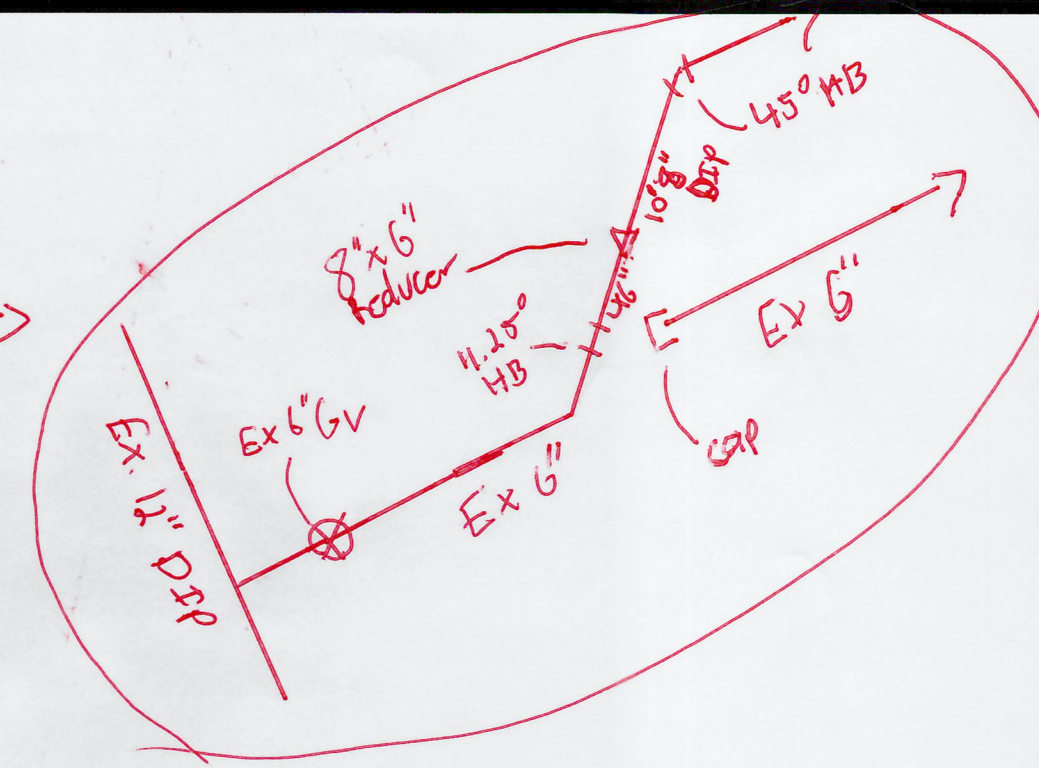

<i>SHEET NO.</i> C108	<i>REV.</i>
---------------------------------	-------------

540.552.5592
1861 PRATT DR, STE 1100
BLACKSBURG, VA. 24060
HANDP.COM

ENGINEERING • SURVEYING • LAND DEVELOPMENT • ENVIRONMENTAL
GEOTECHNICAL • CONSTRUCTION TESTING & INSPECTION • CULTURAL RESOURCES