




- NOTES:**
1. CONTRACTOR SHALL CONFIRM EXISTING SERVICES MARKED FOR DEMOLITION ARE INACTIVE PRIOR TO DEMOLITION. OWNER WILL ASSIST CONTRACTOR WITH VERIFICATION.
  2. CONTRACTOR SHALL PERFORM EXPLORATORY EXCAVATIONS AT UTILITY CROSSINGS TO CONFIRM DEPTH PRIOR TO CONSTRUCTION. AS DIRECTED BY PROJECT MANUAL.
  3. CONTRACTOR SHALL COORDINATE SHUTDOWNS WITH OWNER TO MAINTAIN LOOPED FLOW TO EACH STREET DURING CONSTRUCTION.
  4. ALL DENuded AREAS DISTURBED BY THE WORK SHALL BE RESTORED USING TEMPORARY SEEDING, PERMANENT SEEDING, AND MULCHING.

**PLAN & PROFILE**  
**SOUTH WASHINGTON HEIGHTS**  
**WATER SYSTEM IMPROVEMENTS**  
**ROANOKE, VA.**


**HURT & PROFFITT**  
INSPIRED / RESPONSIVE / TRUSTED

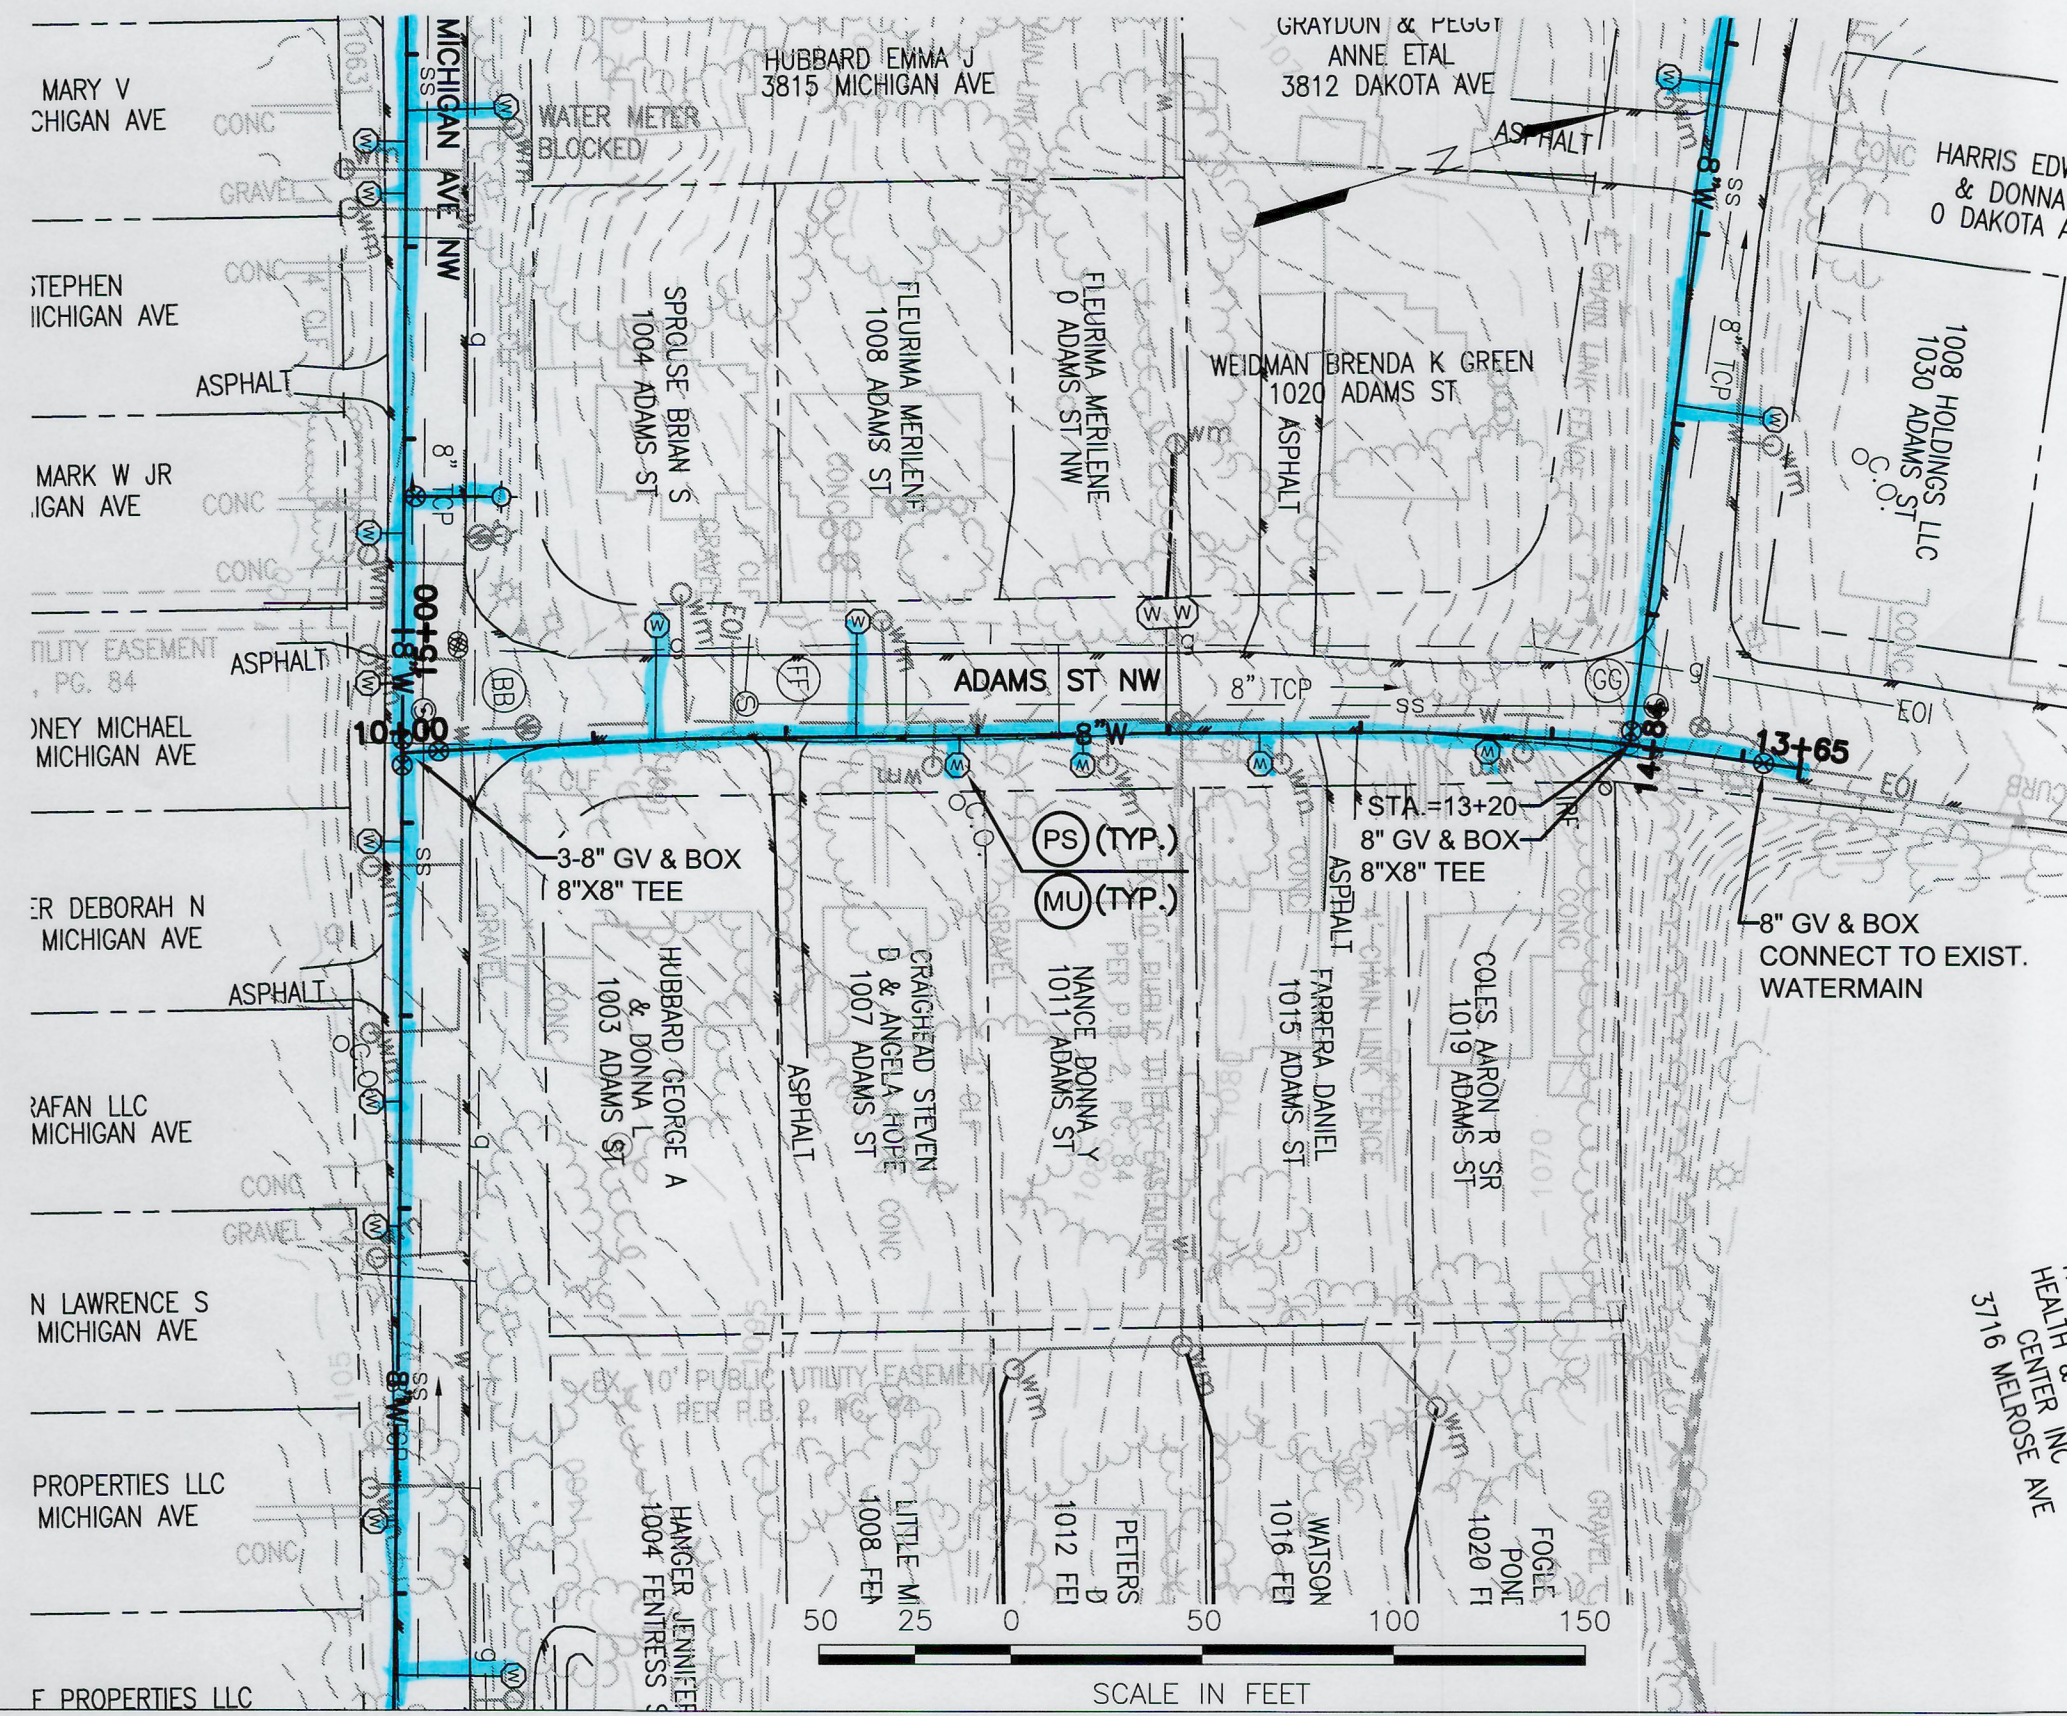

**540.552.5592**  
**1861 PRATT DR, STE 1100**  
**BLACKSBURG, VA. 24060**  
**HANDP.COM**

ENGINEERING • SURVEYING • LAND DEVELOPMENT • ENVIRONMENTAL  
GEOTECHNICAL • CONSTRUCTION TESTING & INSPECTION • CULTURAL RESOURCES

|             |            |
|-------------|------------|
| PROJECT NO. | 20221865   |
| LAT.        | 36.911436  |
| LONG.       | -80.318494 |
| DATE:       | 20 MAR 23  |
| DRAWN BY:   | CBD        |
| CHECKED BY: | DAA        |

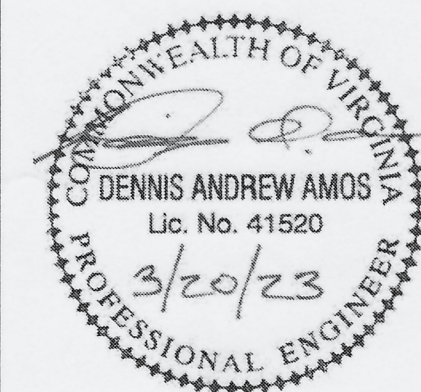

## PLAN & PROFILE

**HURT & PROFFITT**

|                          |      |
|--------------------------|------|
| SHEET NO.<br><b>C110</b> | REV. |
|--------------------------|------|