


ENGINEERS / SURVEYORS Roanoke / Richmond Shenandoah Valley New River Valley / Lynchburg www.balzer.cc

> 1208 Corporate Circle Roanoke, VA 24018 540.772.9580

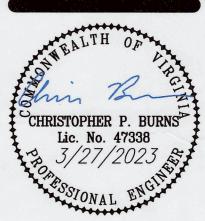

HYUND/

BTC BTC

**DESIGNED BY** CHECKED BY 5/16/2022 1" = 30' REVISIONS

7/15/2022 8/10/2022

DRAWN BY

DATE

SCALE

2/23/2023 PR#1