



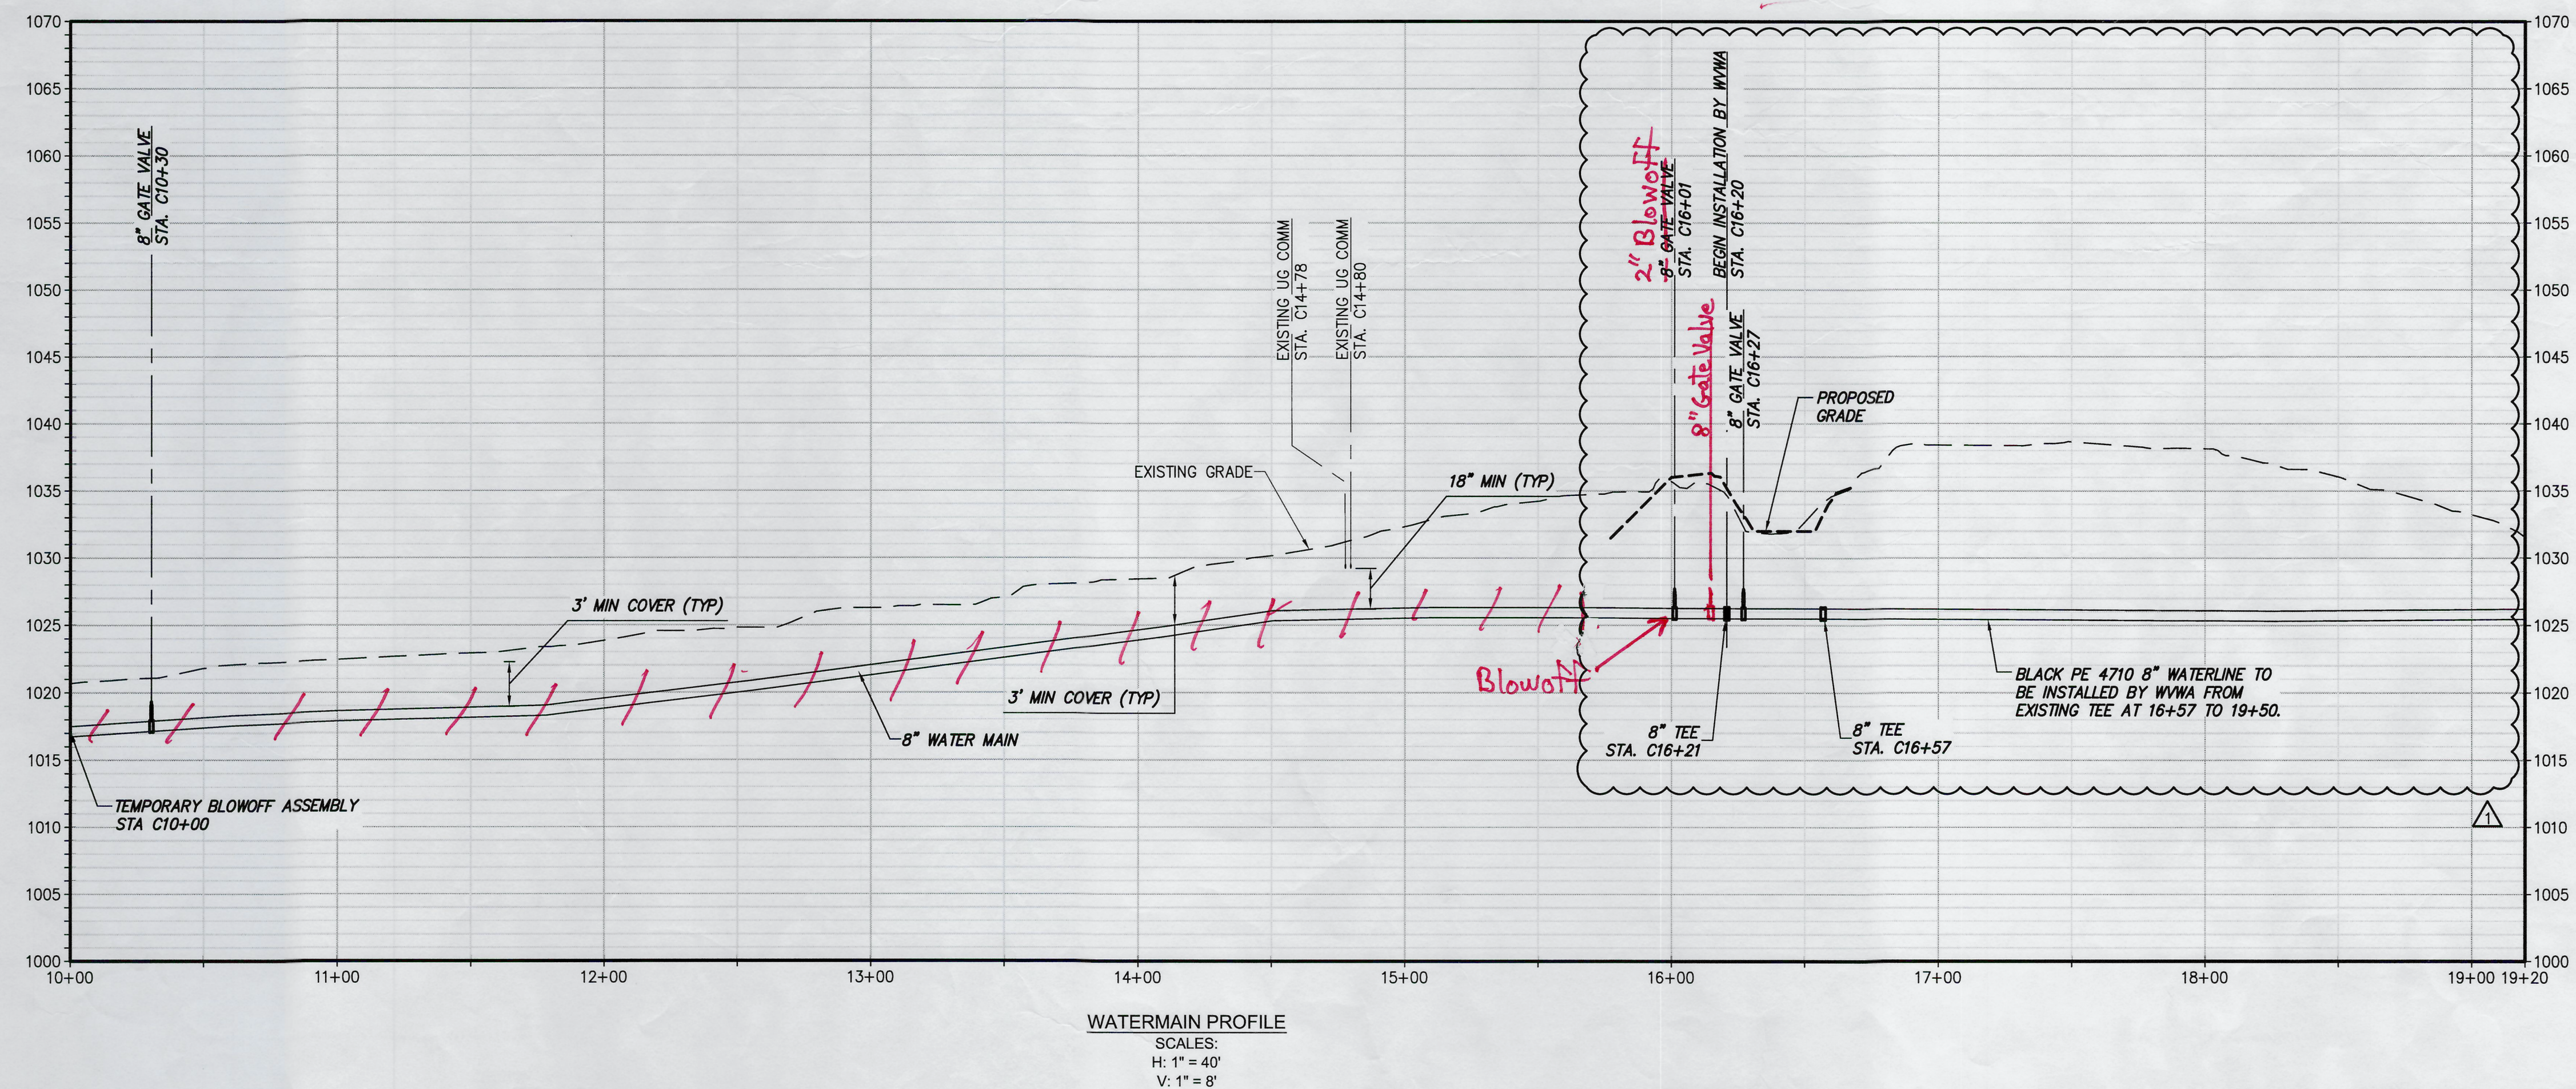


GENERAL NOTES:

1. JOINT DEFLECTION SHALL BE LIMITED TO A MAXIMUM OF 5-DEGREES.
2. ELEVATIONS OF EXISTING UTILITIES ASSUMED. CONTRACTOR TO FIELD ADJUST PROPOSED WATER MAIN TO PROVIDE 3' MIN. COVER AND 18" MIN VERTICAL SEPARATION FROM ALL OTHER UTILITIES. CONTRACTOR TO NOTIFY ENGINEER OF ANY CONFLICTS.
3. JACK AND BORE OR HDD CAN BE UTILIZED FOR INSTALLATION OF WATER MAIN ACROSS ROUTE 40.
4. WATERLINE MATERIAL MAY BE AWWA C151 DIP, AWWA C900 PVC OR AWWA C906 DR 11.

Drawing Copyright © 2023

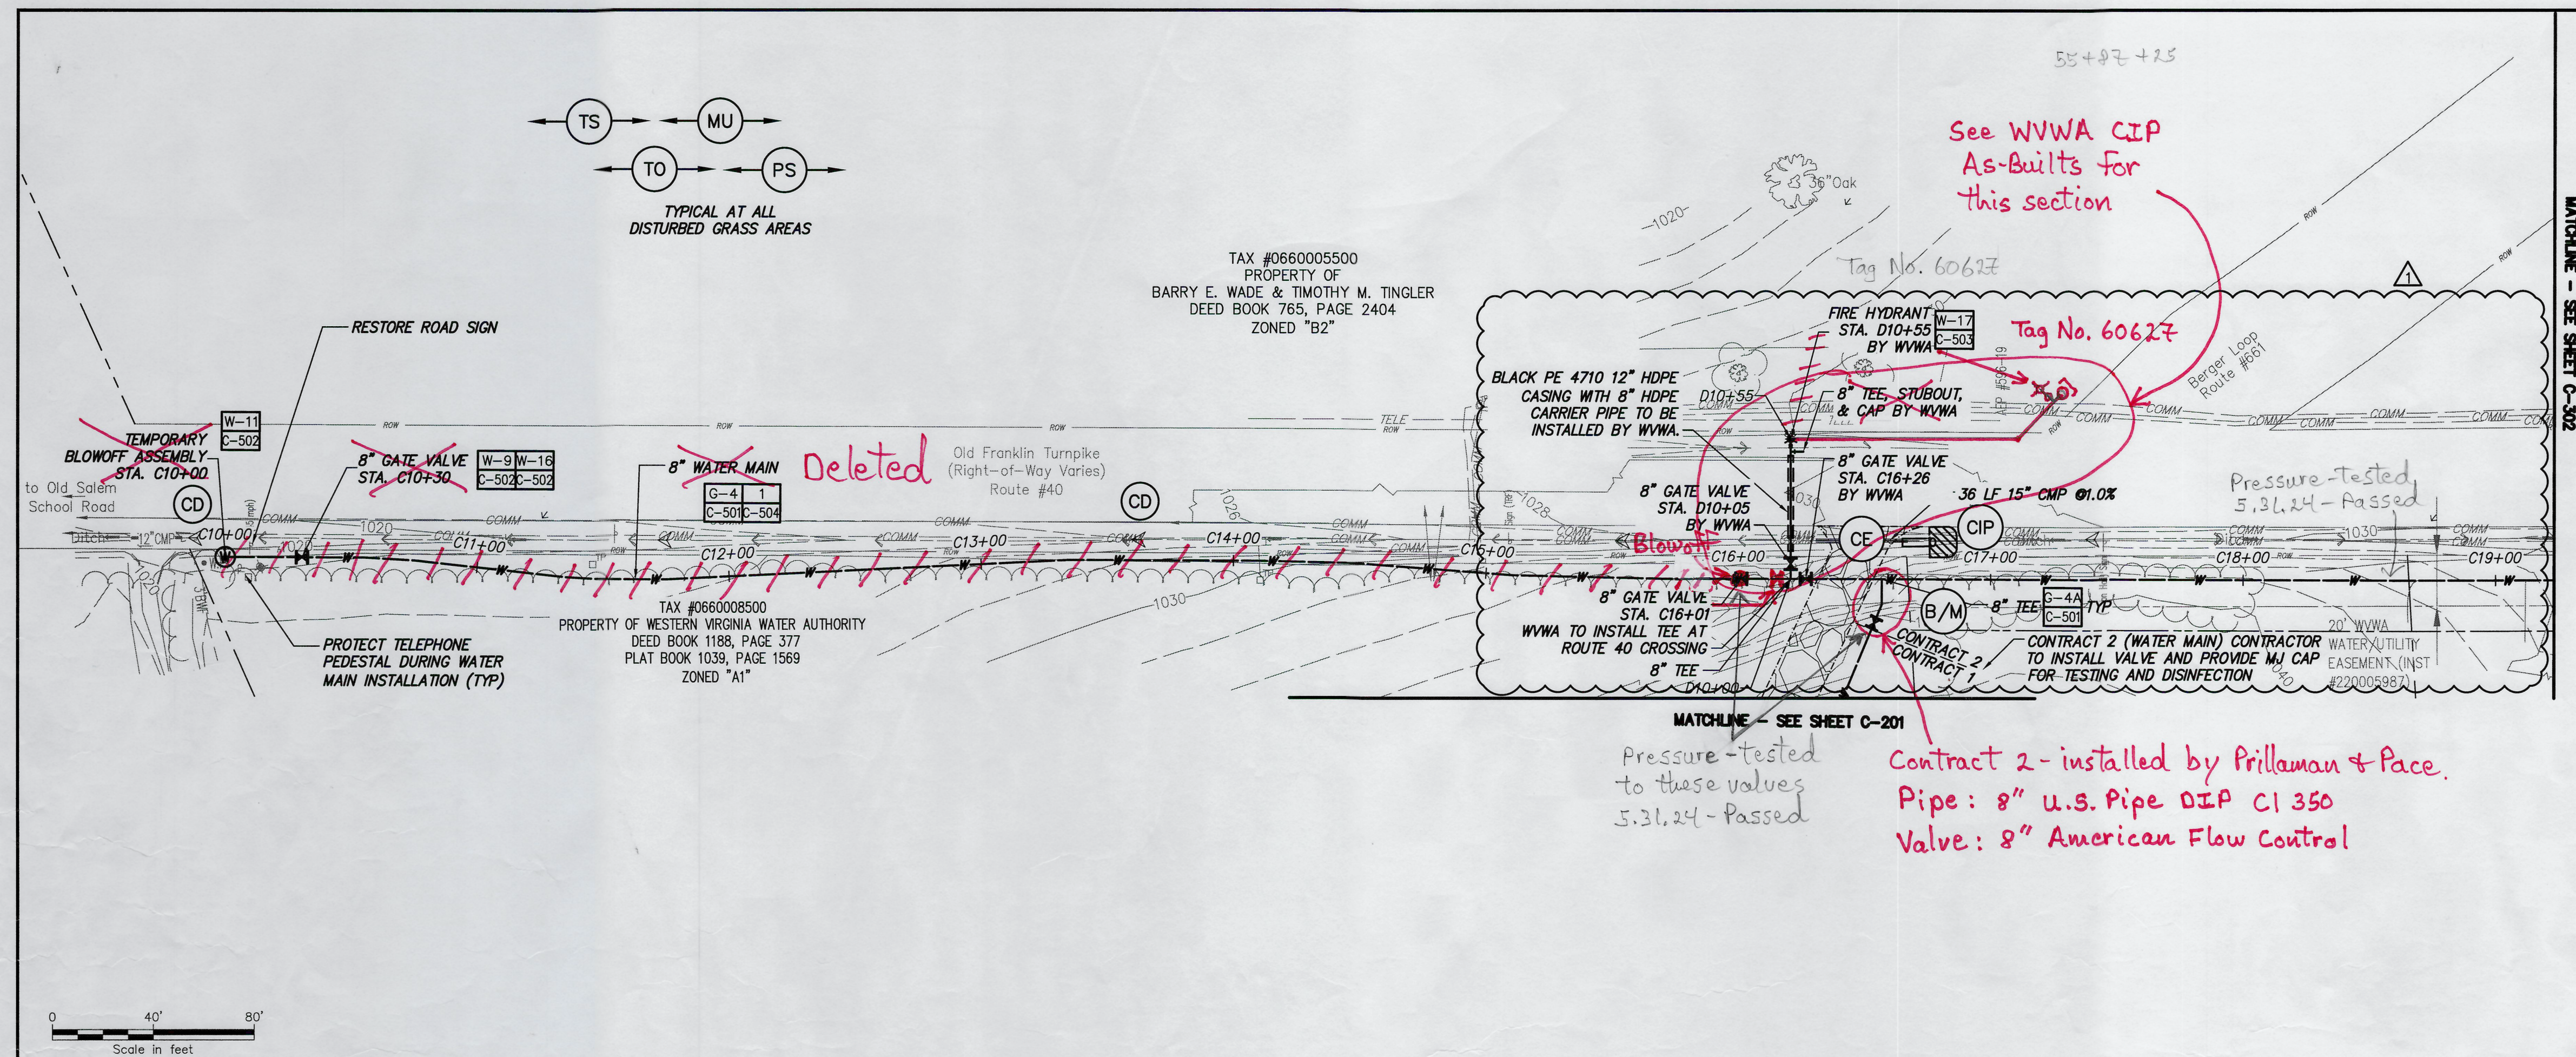

WESTERN
VIRGINIA WATER
AUTHORITY

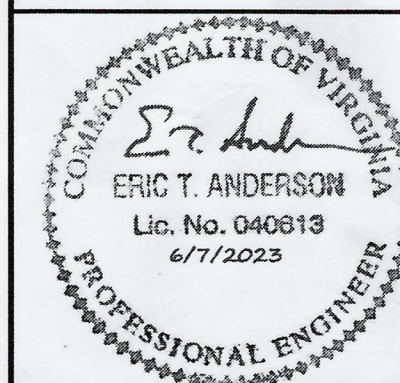

IT IS A VIOLATION OF LAW FOR ANY PERSON, UNLESS THEY ARE ACTING UNDER THE DIRECTION OF A LICENSED PROFESSIONAL ENGINEER, ARCHITECT, LANDSCAPE ARCHITECT OR LAND SURVEYOR, TO ALTER AN ITEM IN ANY WAY. IF AN ITEM BEARING THE STAMP OF A LICENSED PROFESSIONAL IS ALTERED, THE ALTERING ENGINEER, ARCHITECT, LANDSCAPE ARCHITECT OR LAND SURVEYOR SHALL STAMP THE DOCUMENT AND INCLUDE THE NOTATION "ALTERED BY" FOLLOWED BY THEIR SIGNATURE, THE DATE OF SUCH ALTERATION, AND A SPECIFIC DESCRIPTION OF THE ALTERATION.

SOUTHLAKE WATER
SYSTEM

CONTRACT 1: WATER TREATMENT PLANT

No.	Submittal / Revision	App'd.	By	Date
	CHANGE ORDER	SMS	BJM	6/7/23
	BID ISSUE	ETA	CDR	4/4/23

WATERMAIN PLAN AND PROFILE

Designed By: CDR	Drawn By: CDR	Checked By: ETA
Issue Date: 06/07/23	Project No: 073612	Scale: AS NOTED

Drawing No.:

C-301

Contract 2: Inspectors' As-Builts K. Winslow 9.9.24 Contractor: Prillaman & Pace