

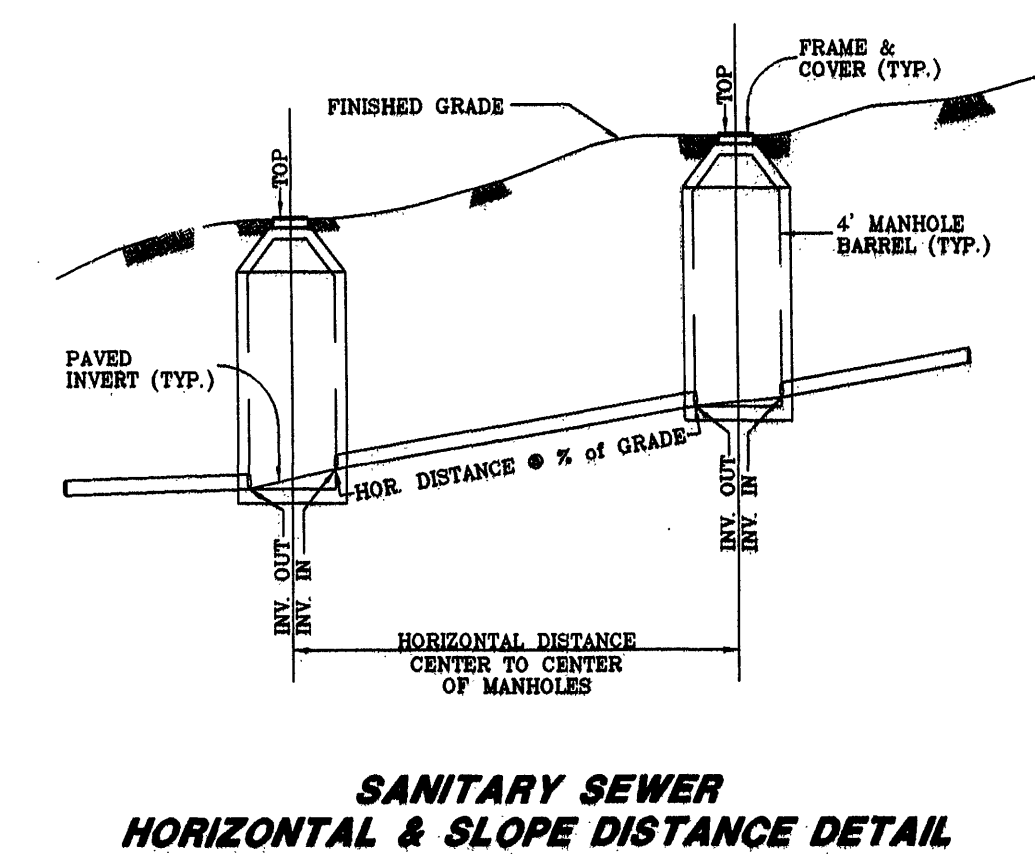


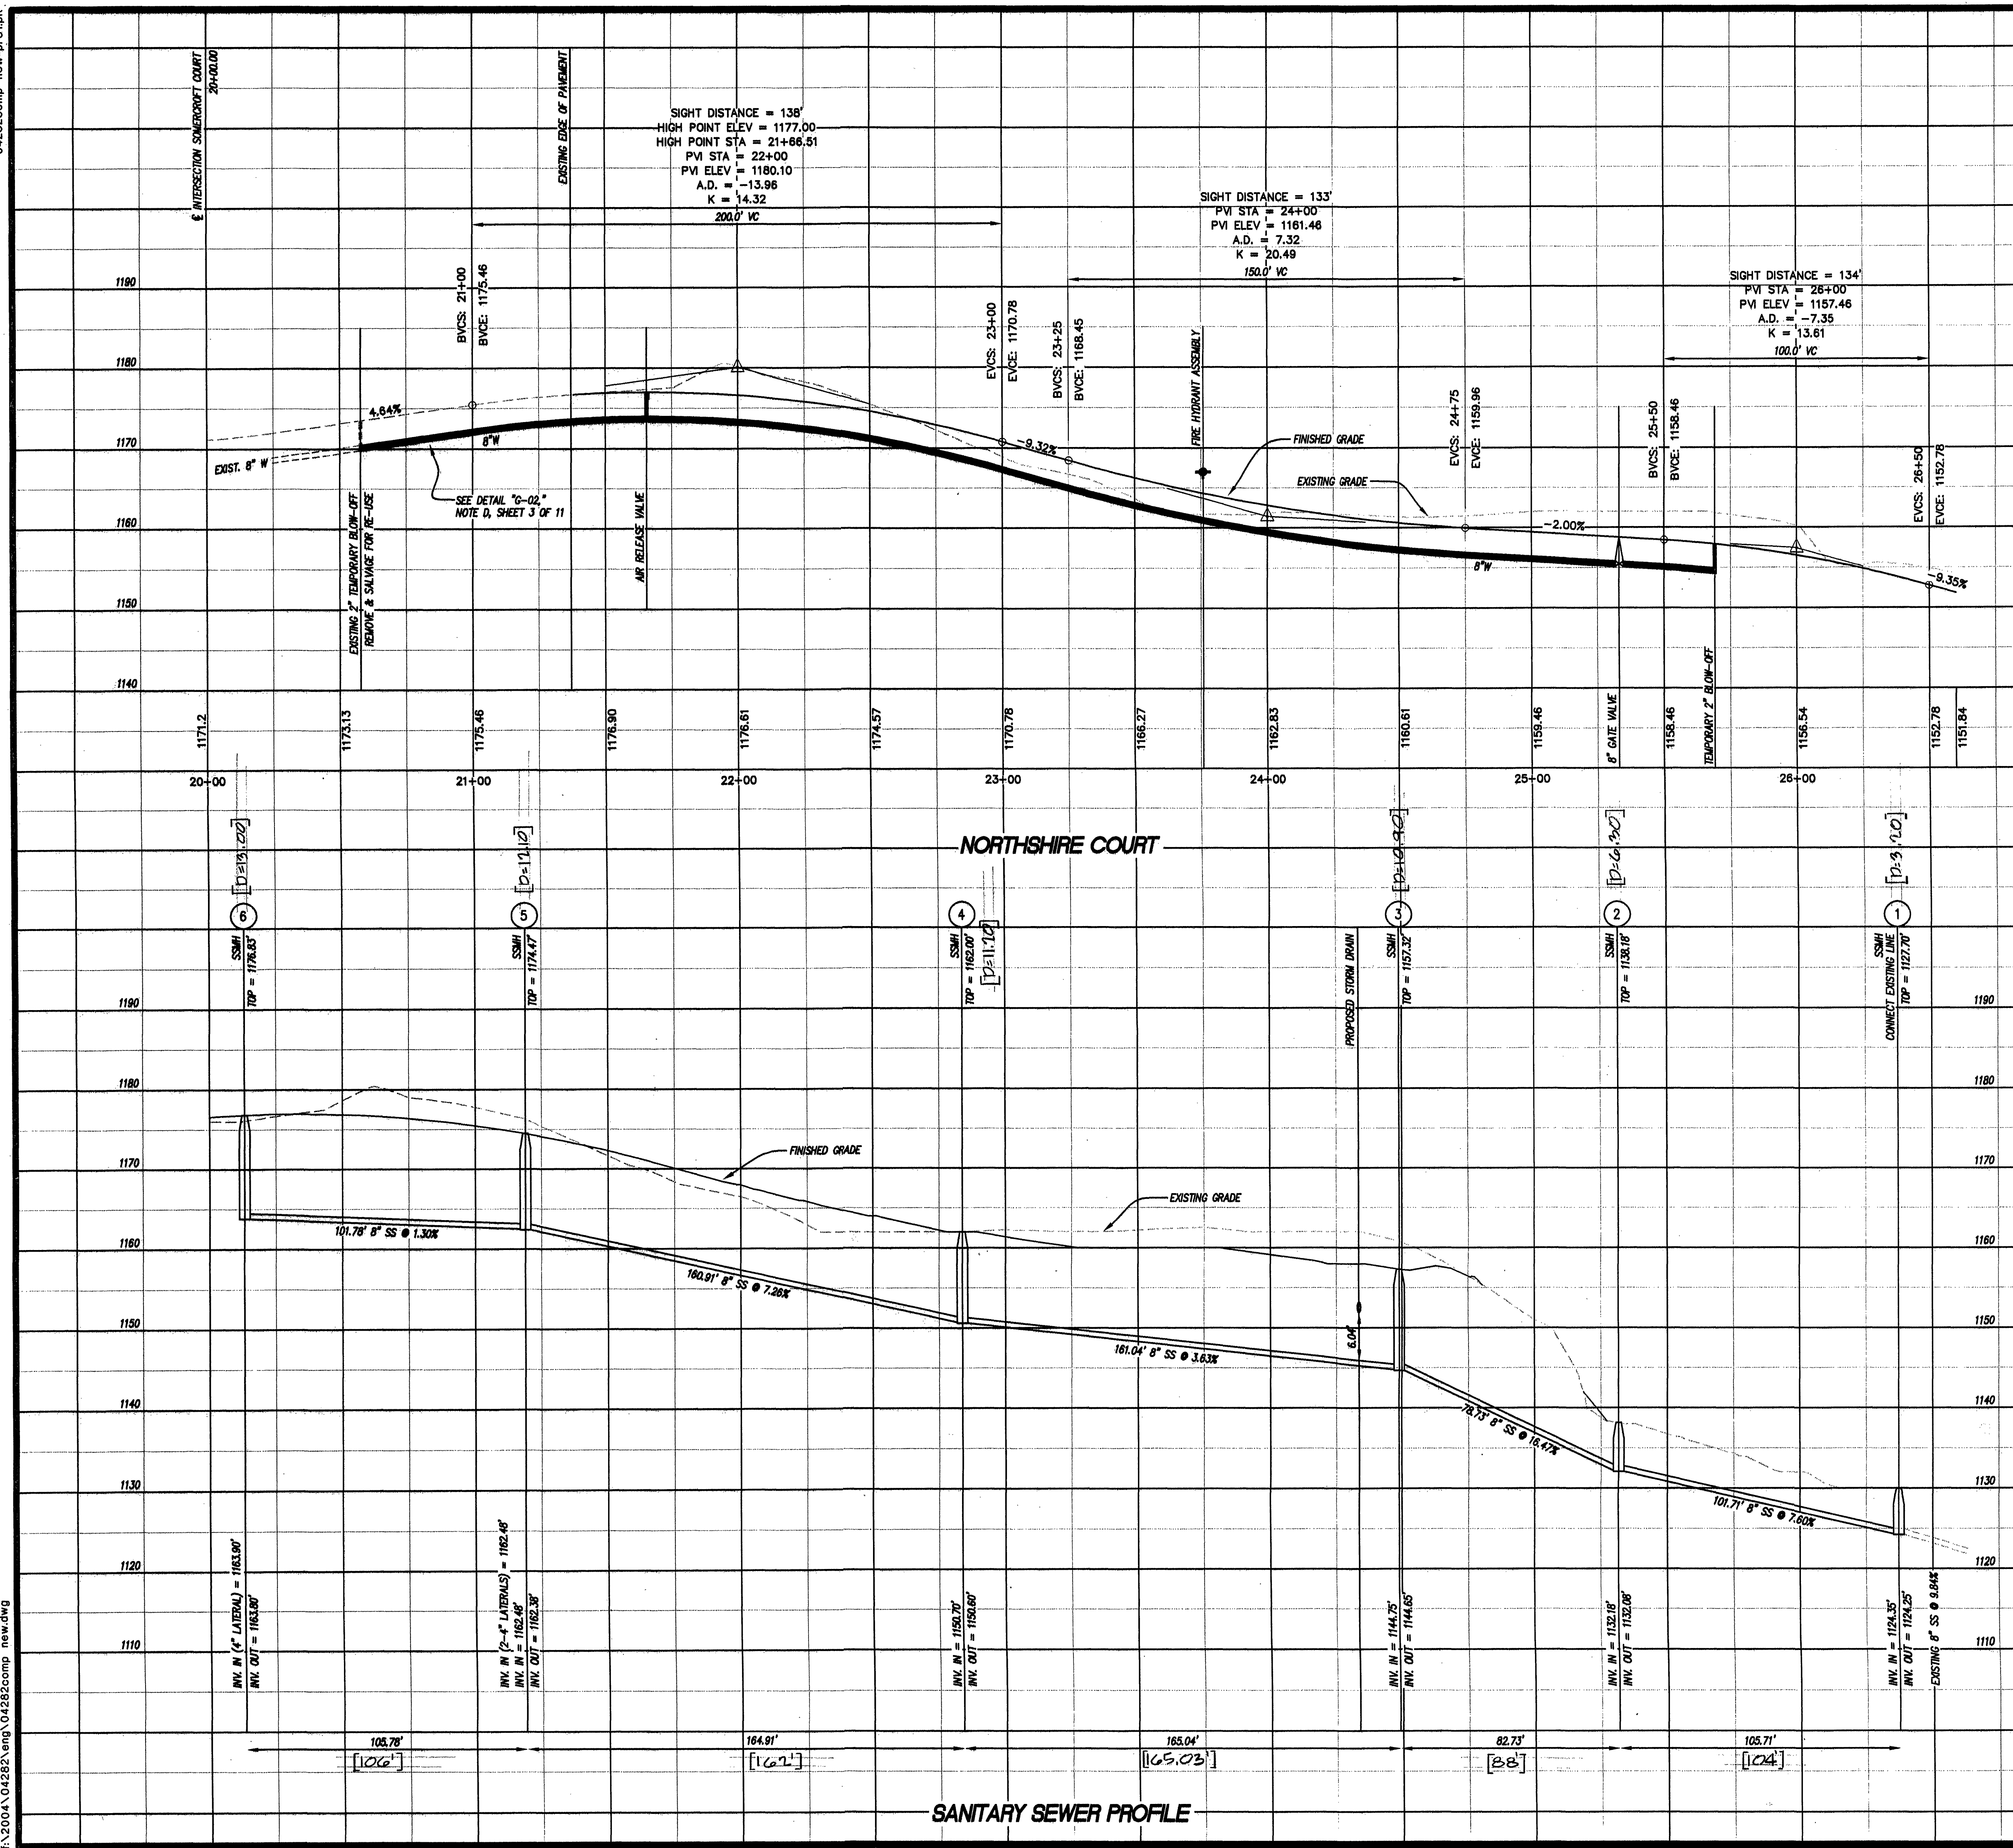

GENERAL NOTES:

1. TRAFFIC BEARING BO REQUIRED IN TRAFFIC AREAS.
2. ALL PIPE AND FITTINGS SHALL BE OF SIMILAR MATERIAL.
3. ALL PIPE SHALL BE OF THE SAME SIZE.
4. NO BENDS ARE ALLOWED IN THE LATERAL FROM THE MAIN TO THE CLEANOUT STACK WYE. (EXCEPT AS NOTED)
5. ALL MAIN LINE TAPS ON ACTIVE MAINS WILL BE PERFORMED BY WESTERN VIRGINIA WATER AUTHORITY.
6. PIPING BEHIND CLEANOUT TO BE INSTALLED PER BOCA CODE.
7. MINIMUM LATERAL SIZE:
 - a. 6" FOR RESIDENTIAL SERVICE
 - b. 8" FOR NON-RESIDENTIAL SERVICE
8. MINIMUM COVER FOR ALL SEWER LATERALS SHALL BE THREE(3) FEET.
9. PROPERTY OWNER RESPONSIBLE FOR INSTALLING CLEANOUT ON PROPERTY LINE WHEN INTERFERENCE OCCURS.

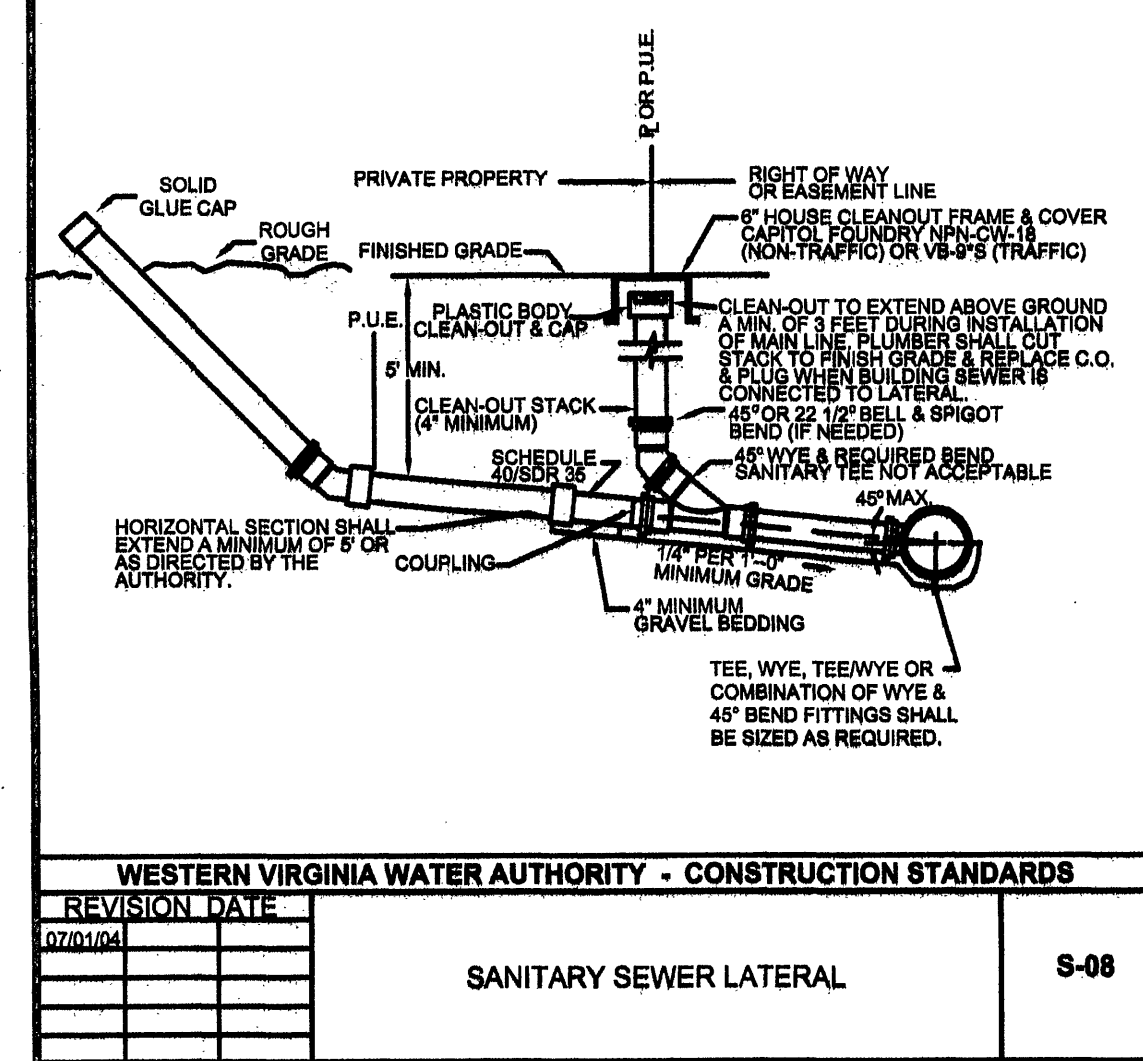

REVISIONS	
NO.	DATE
1	3/23/14
DESCRIPTION WATER & SEWER AS BUILT	
2	
3	
4	
5	

DATE: April 22, 2005
 SCALE: 1"=30'(H), 1"=10'(V)
 COMMISSION NO: 04-282

SHEET 7 OF 11