


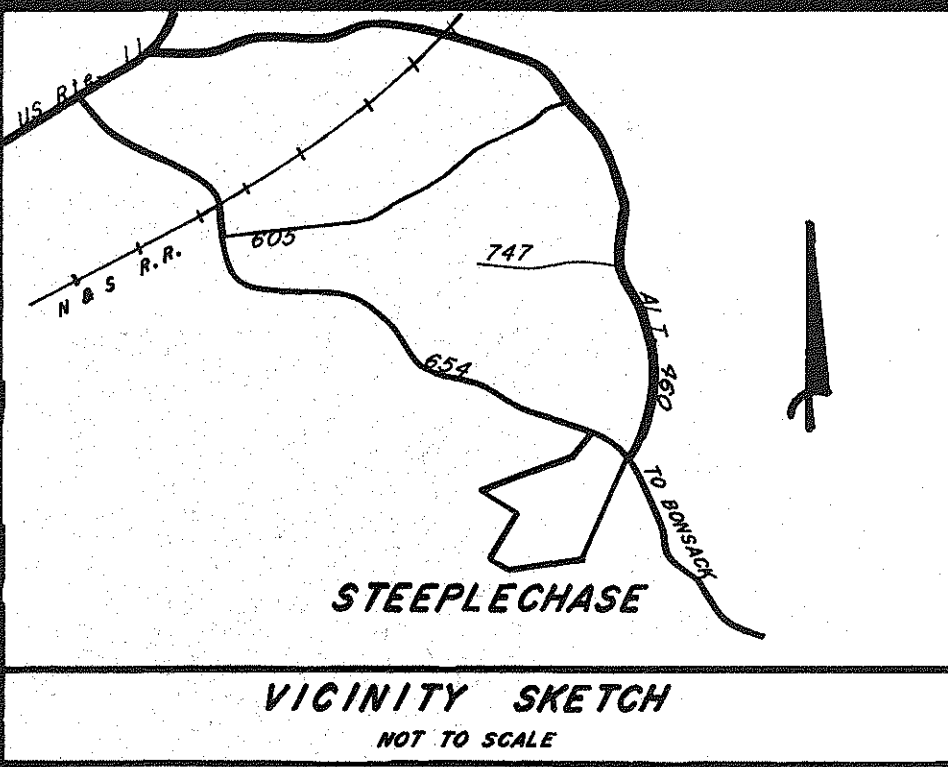

PROJECT NAME: *As-Built Steeplechase Sect II*  
DATE: *12-91*  
TYPE: *As-Built*  
LOCATION: *9*  
TOTAL # SHEETS: *9*  
A/E FIRM: *Shanks*  
# OF SETS: *Shanks*

# STEEPLECHASE

## SECTION 2

### AS - BUILT Sanitary Sewer Plans

Blue Ridge Magisterial District  
BOTETOURT COUNTY, VIRGINIA

Owner & Developer  
**A. R. OVERBAY**

Contractor  
**St. Clair Construction**

#### SHEET INDEX

|                                                                                                    | AS-BUILT<br>PLANS | CONSTRUCTION<br>PLANS |
|----------------------------------------------------------------------------------------------------|-------------------|-----------------------|
| COVER SHEET                                                                                        | 1                 | 11                    |
| PLAN & PROFILE SHEETS:                                                                             |                   |                       |
| DOWNING STREET - Sta. 10+00 to Sta. 23+30<br>MH 2 and 3 (Plan View Only)<br>MH 18 (Plan View Only) | 2                 | 5                     |
| DOWNING STREET - Sta. 23+30 to Sta. 29+30<br>MH 4 and 5 (Plan View Only)<br>MH 19 and 20           | 3                 | 6                     |
| STAYMAN ROAD - Sta. 14+00 to Sta. 23+00<br>MH 14 through 17                                        | 4                 | 7                     |
| WINESAP ROAD - Sta. 9+98 to Sta. 21+98<br>MH 12 and MH 21 through 23                               | 5                 | 8                     |
| WINESAP ROAD - Sta. 21+98 to 25+32<br>MH 11 and 12                                                 | 6                 | 9                     |
| McINTOSH ROAD                                                                                      | N/C               | 10                    |
| ONSITE SEWER<br>MH's 4, 5, 6, 10, 11, 12, 13, and 14                                               | 7                 | 16                    |
| OFFSITE SEWER - Sta. 10+00 to Sta. 40+00<br>MH 99 - 109                                            | 8                 | 14                    |
| OFFSITE SEWER - Sta. 40+00 to Sta. 58+94<br>MH 99 - 114                                            | 9                 | 15                    |
| ONSITE SEWER - Sta. 0+00 to Sta. 6+99<br>MH 2 - 4                                                  |                   |                       |


THE FOLLOWING CONSTRUCTION PLAN SHEETS HAVE BEEN OMITTED FROM AS-BUILT PLANS

| SHEET NUMBER | ITEM                          |
|--------------|-------------------------------|
| 2            | OVERALL DEVELOPMENT PLAN      |
| 3            | SECTION 2 RECORD PLAT         |
| 4            | SECTION 2 RECORD PLAT         |
| 10           | McINTOSH ROAD (SEE SECTION 3) |
| 11           | EROSION CONTROL DETAILS       |
| 12           | UTILITY SPECIFICATIONS        |
| 13           | SANITARY SEWER DETAILS        |
| 17           | WATER PLANS & DETAILS         |
| 18           | WATER PLANS & DETAILS         |



SHANKS ASSOCIATES, P.C. - ENGINEERS - SURVEYORS - PLANNERS  
313 LUCK AVENUE ROANOKE, VIRGINIA 24011 (703) 343-6605

| DATE                                           | REVISION DESCRIPTION |
|------------------------------------------------|----------------------|
| DATE<br>12/09/91                               |                      |
| DRAWN BY:<br>CEG                               |                      |
| DESIGNED BY:<br>FOS                            |                      |
| CHECKED BY:<br>FOS                             |                      |
| SCALE:<br>AS NOTED                             |                      |
| STEEPLECHASE - SECTION 2<br>AS BUILT PLANS     |                      |
| COVER SHEET                                    |                      |
| SHEET NUMBER<br>1 OF 9<br>JOB NUMBER<br>291010 |                      |


|                  |                             |    |      |
|------------------|-----------------------------|----|------|
| <b>PROFILE</b>   | SURVEYED                    | BY | DATE |
|                  | PLOTTED                     |    |      |
| <b>NOTE BOOK</b> | GRADES CHECKED              | BY | DATE |
|                  | B. M.'s NOTED               |    |      |
| <b>NO.</b>       | STRUCTURE NOTATIONS CHECKED |    |      |

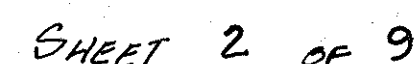


|                  |                                   |          |            |
|------------------|-----------------------------------|----------|------------|
| <b>PROFILE</b>   | SURVEYED _____                    | BY _____ | DATE _____ |
|                  | PLOTTED _____                     |          |            |
|                  | GRADES CHECKED _____              |          |            |
|                  | B. M.'s NOTED _____               |          |            |
| <b>NOTE BOOK</b> | STRUCTURE NOTATIONS CHECKED _____ |          |            |
|                  | No. _____                         |          |            |

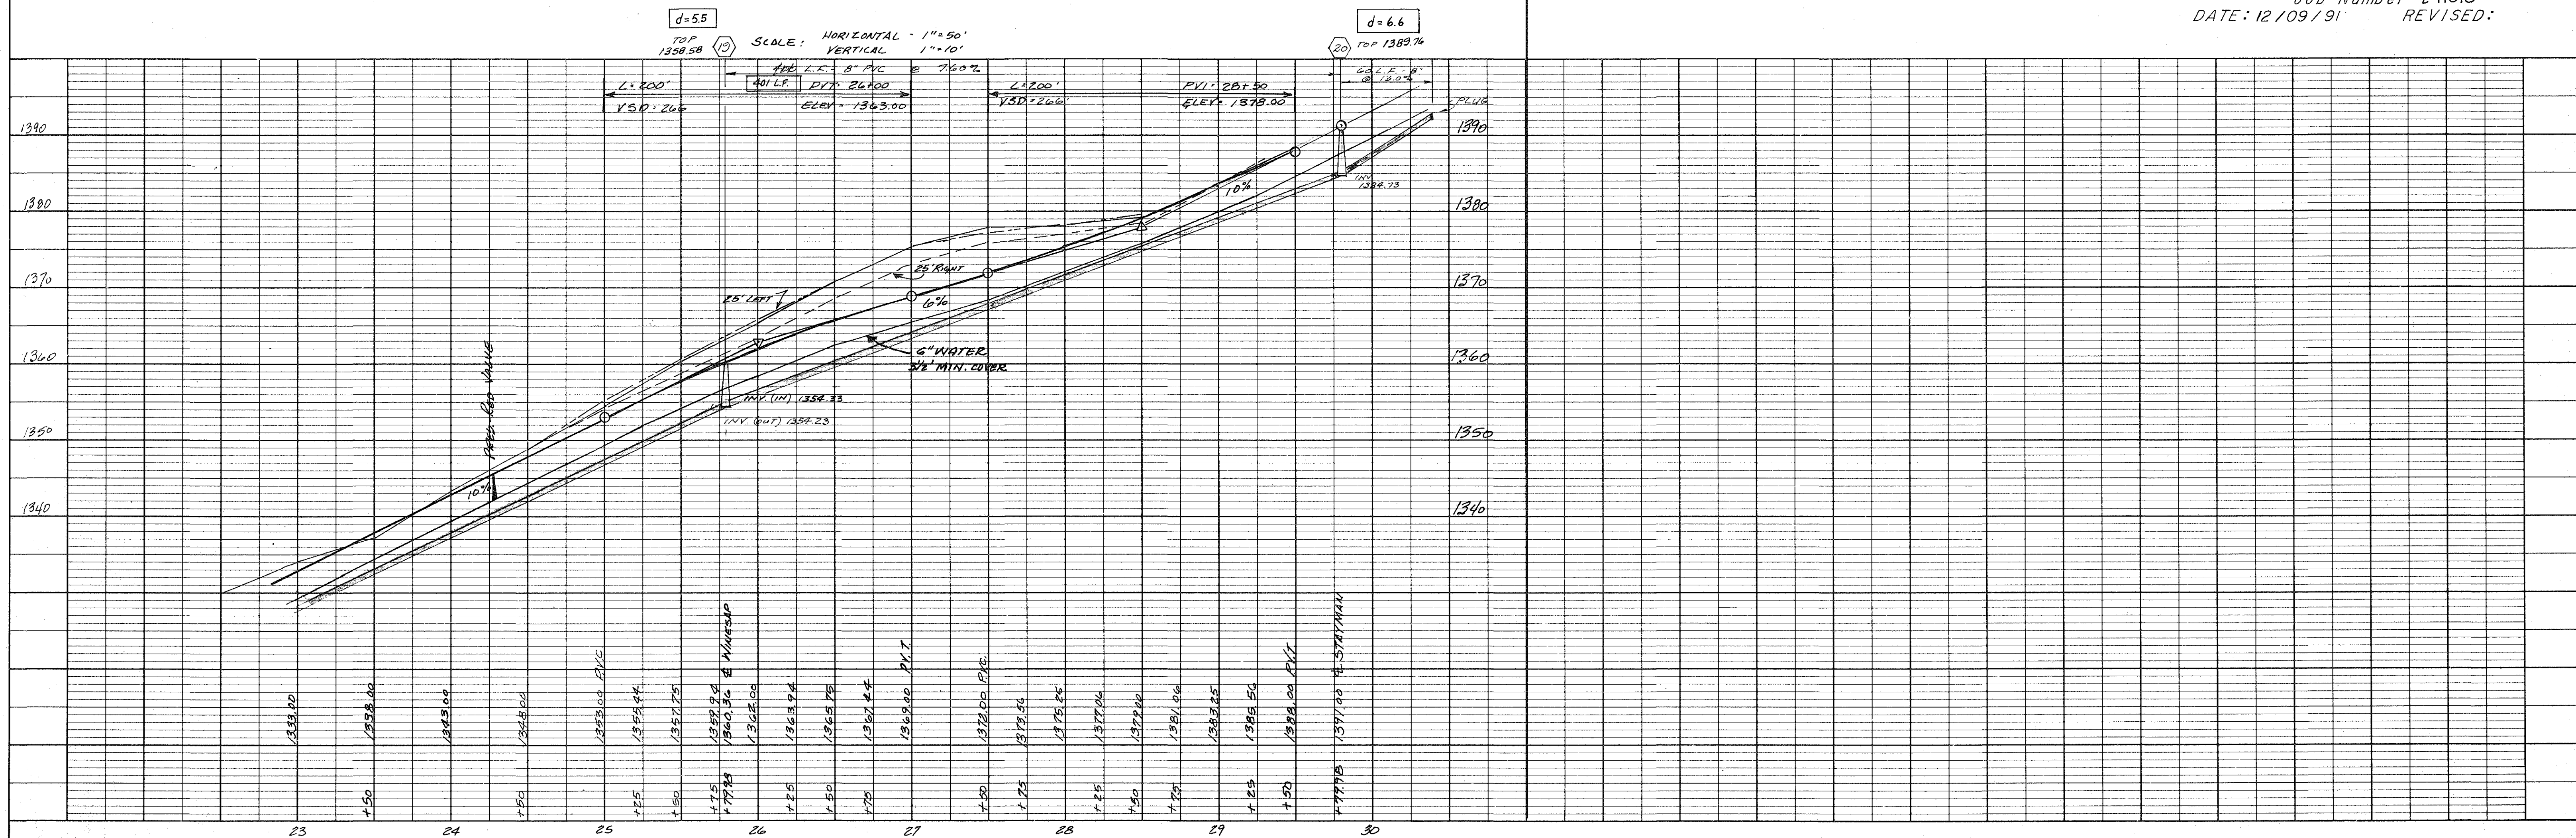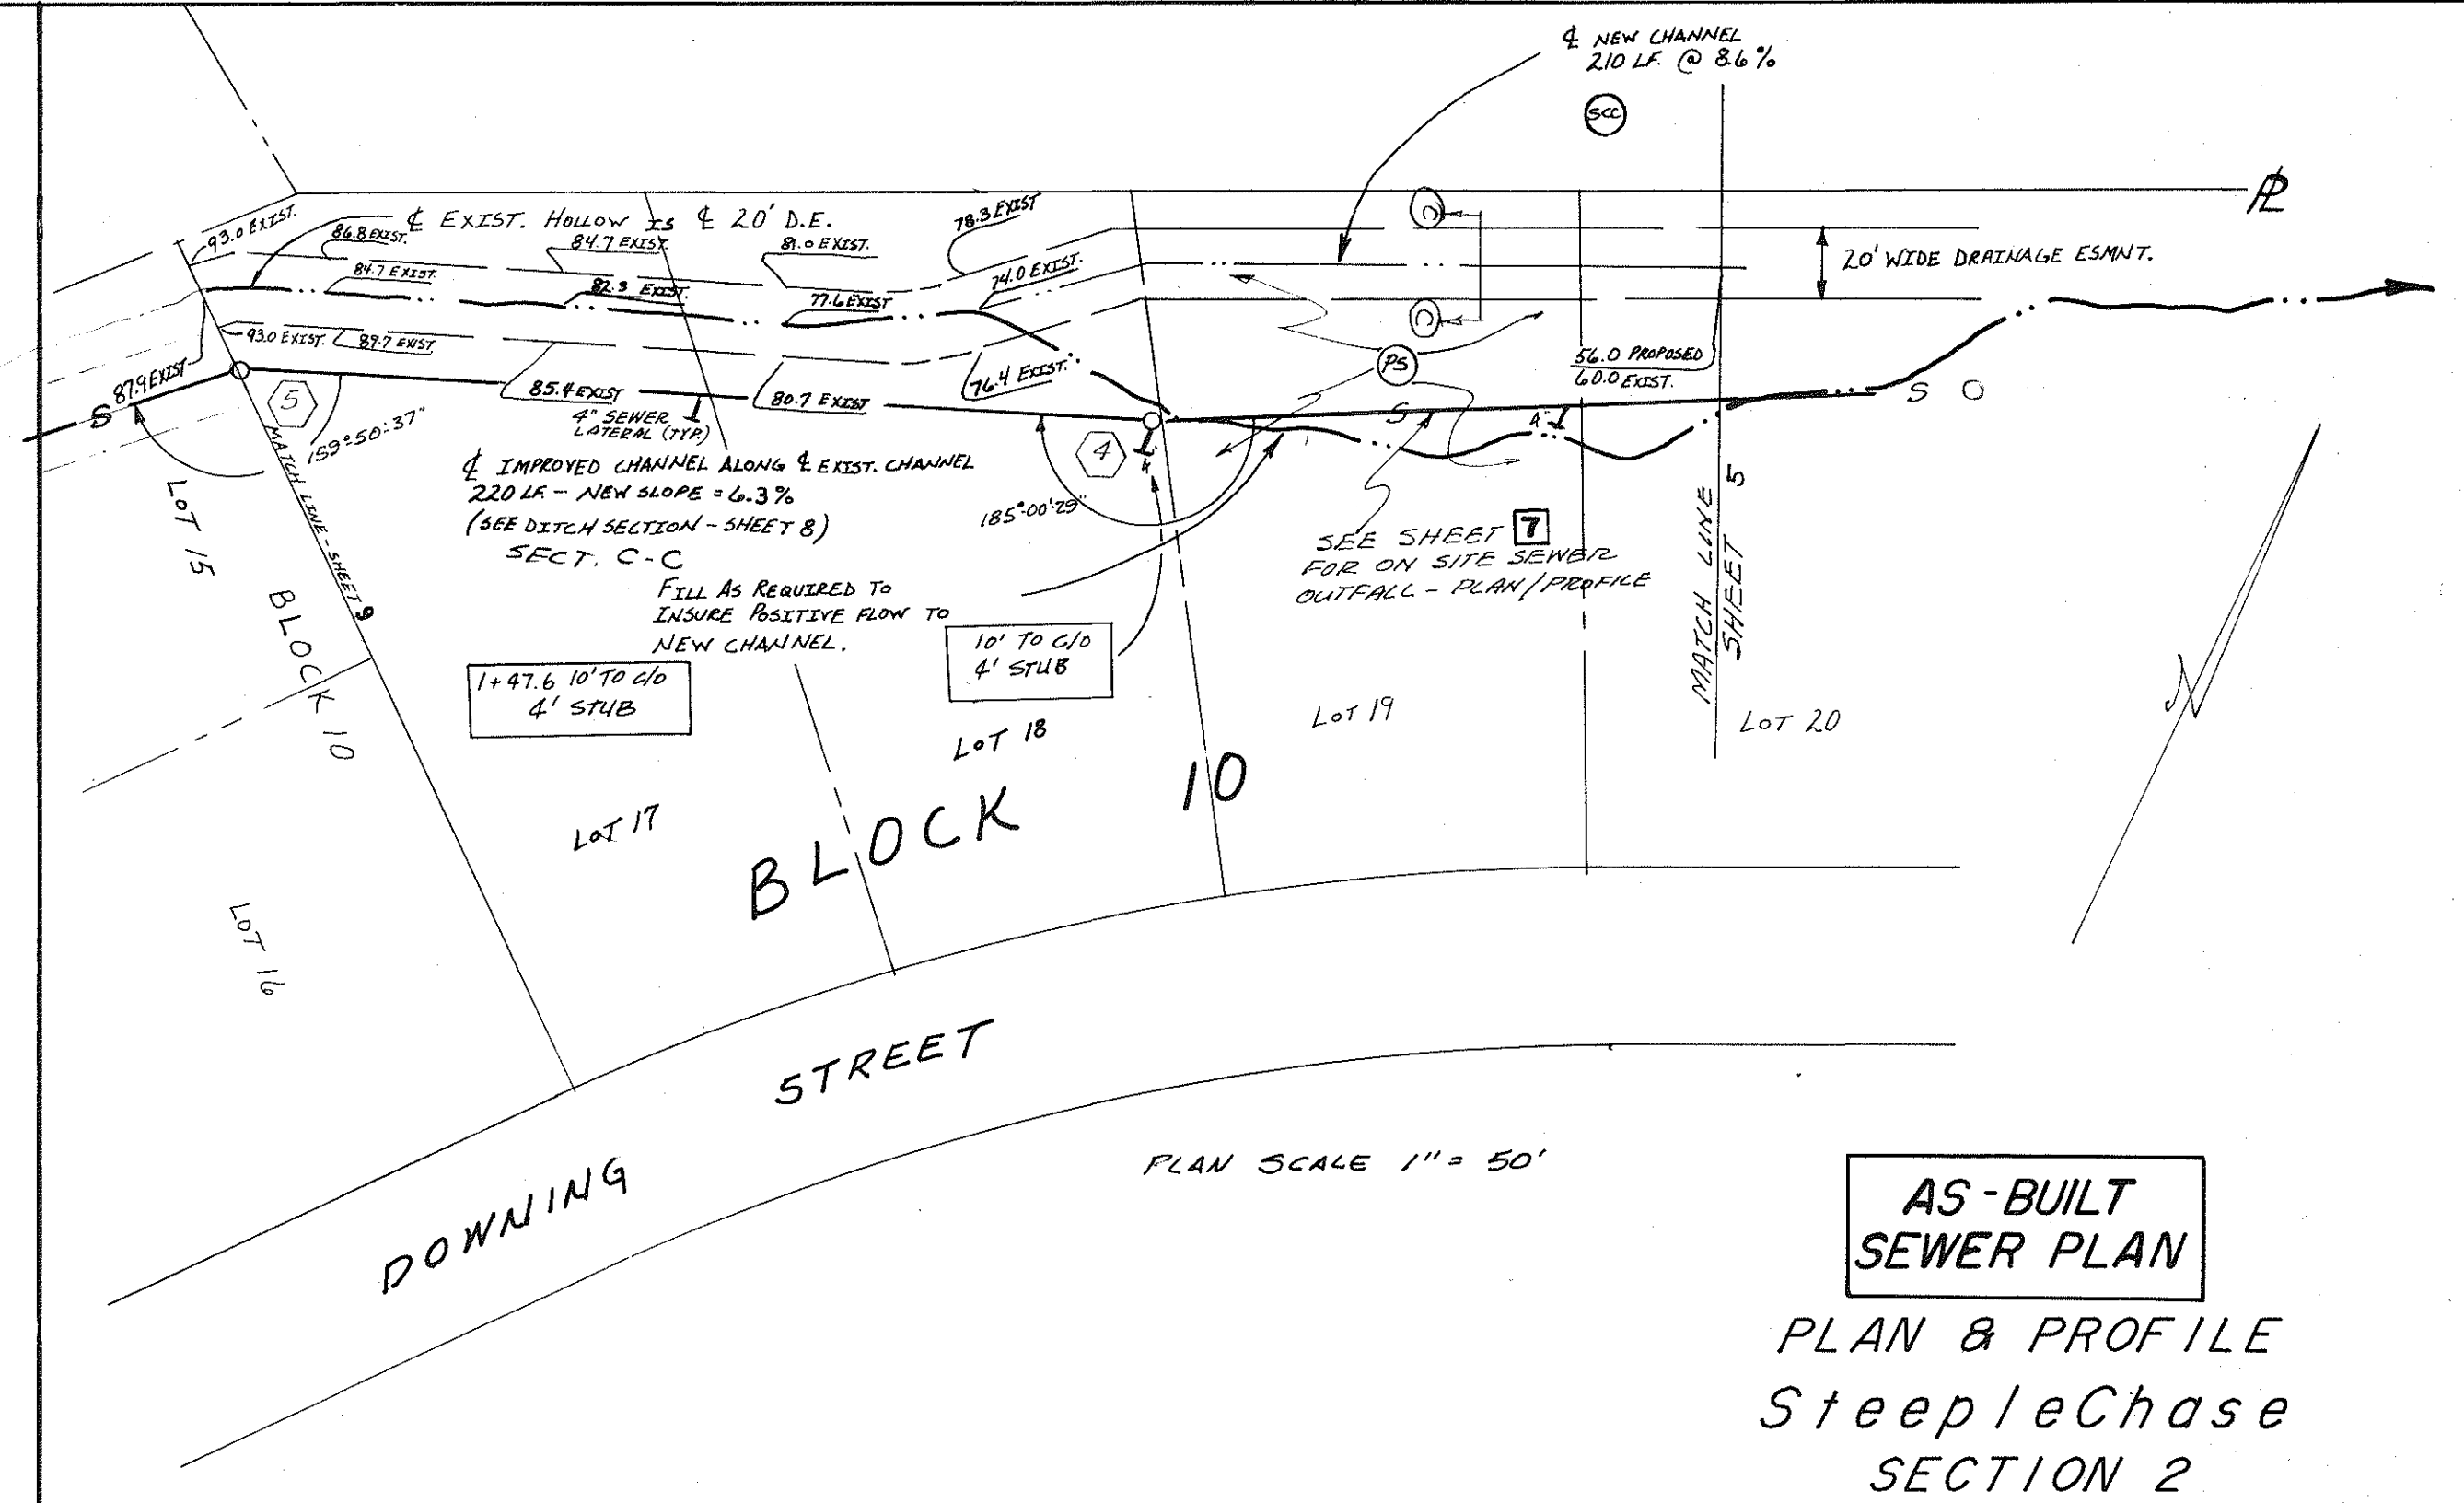

| PROFILE                           |  | BY | DATE |
|-----------------------------------|--|----|------|
| SURVEYED _____                    |  |    |      |
| PLOTTED _____                     |  |    |      |
| GRADES CHECKED _____              |  |    |      |
| B. M.'s NOTED _____               |  |    |      |
| STRUCTURE NOTATIONS CHECKED _____ |  |    |      |

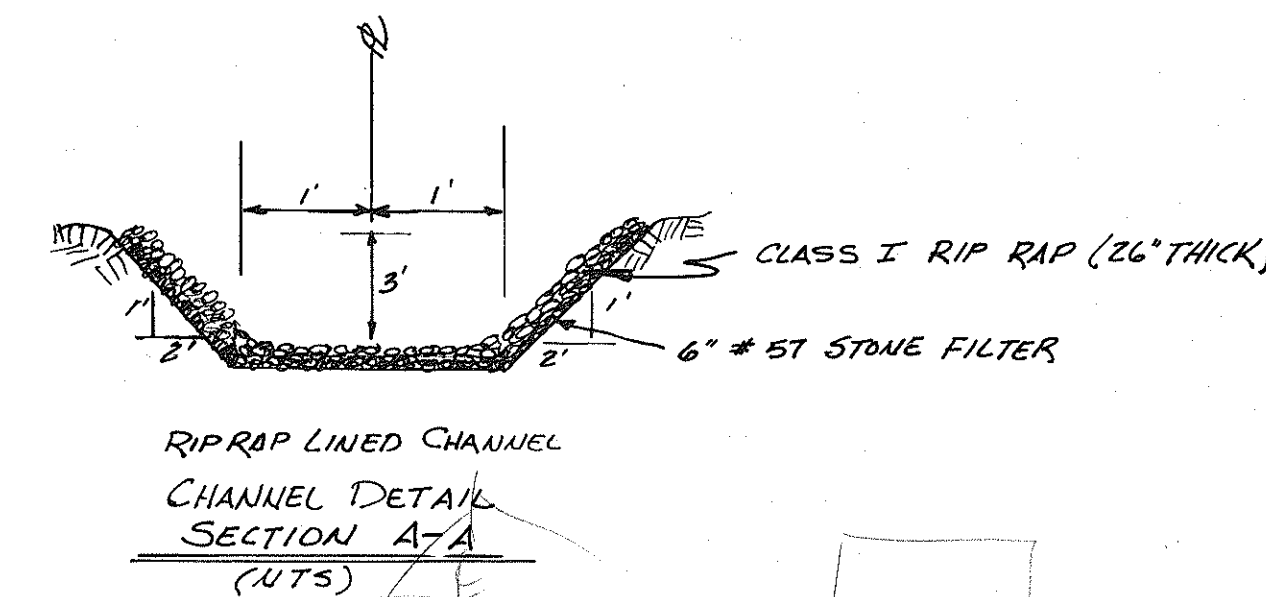


FRED O. SHANKS, III, P.C.  
ENGINEERS-SURVEYORS-PLANNERS  
313 LUCK AVENUE  
ROANOKE, VIRGINIA 24015  
(703) 343-6685  
Job Number 291010  
DATE: 12/09/91 REVISED:

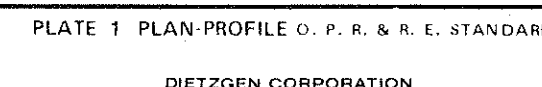

|           |  |
|-----------|--|
| DATE      |  |
| BY        |  |
| SURVEYED  |  |
| ALIGNED   |  |
| NOTE BOOK |  |
| NO.       |  |

|           |  |
|-----------|--|
| DATE      |  |
| BY        |  |
| SURVEYED  |  |
| ALIGNED   |  |
| NOTE BOOK |  |
| NO.       |  |

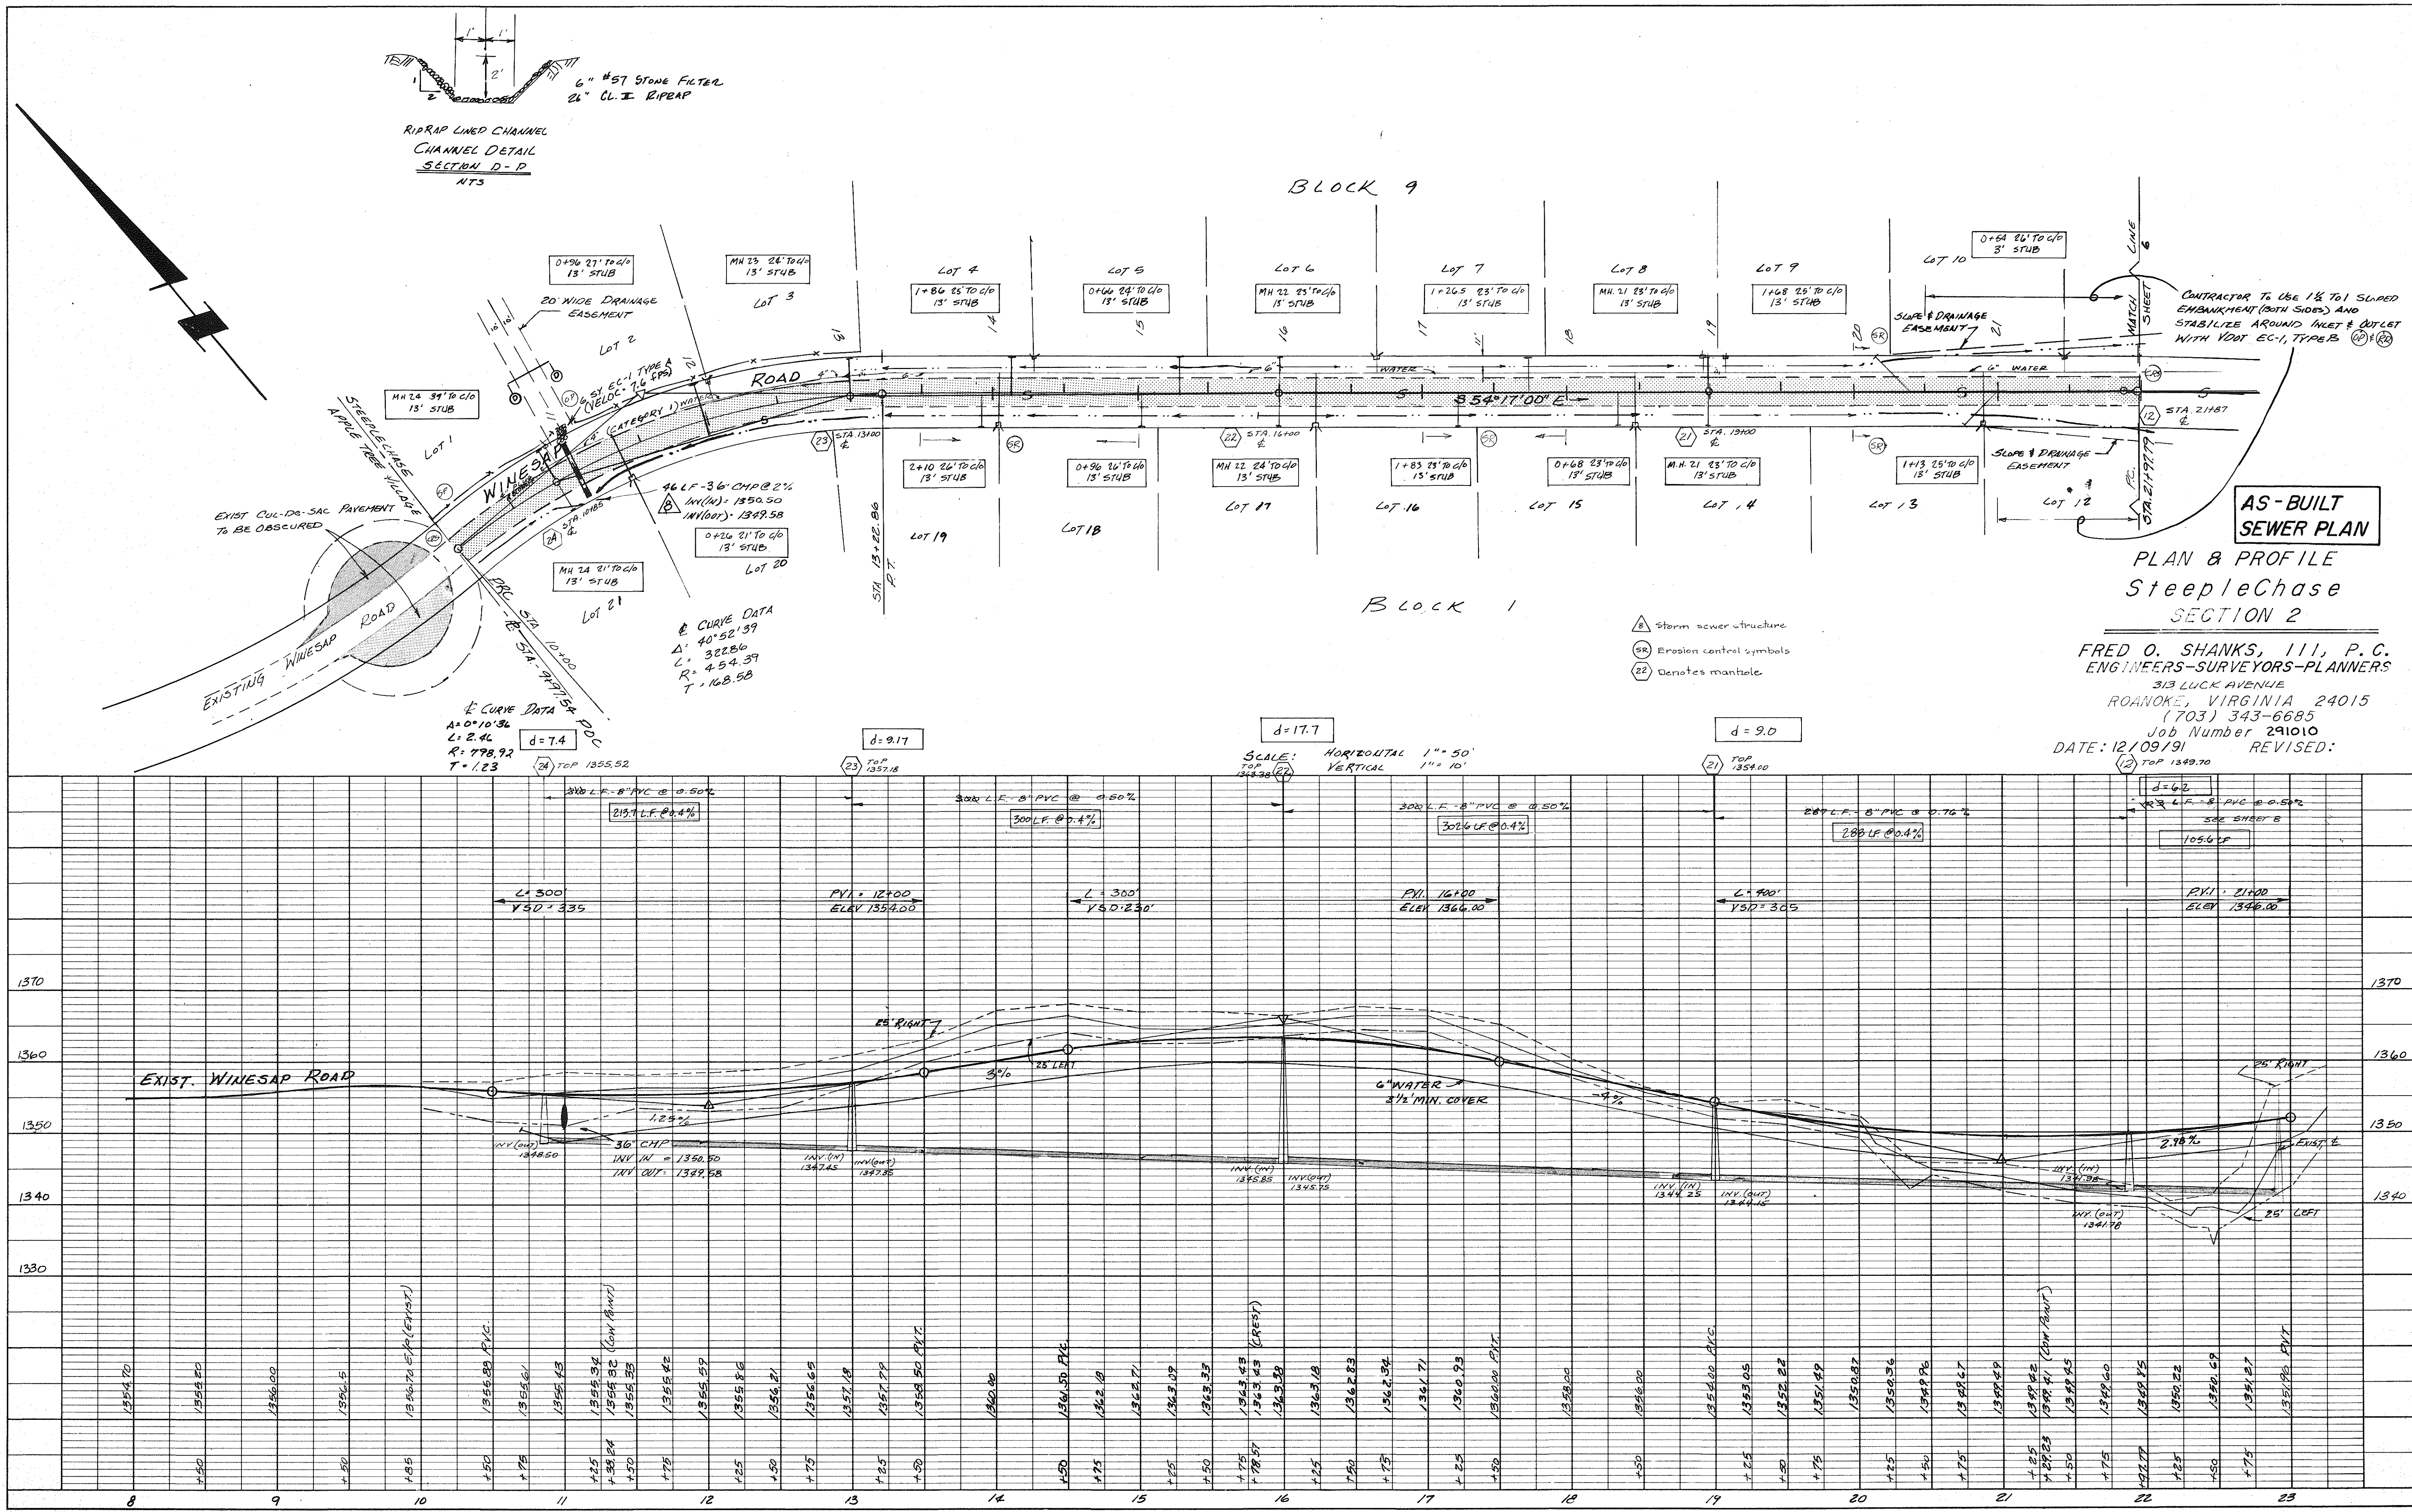

| PLAN      | DATE | BY |
|-----------|------|----|
| SURVEYED  |      |    |
| PLOTTED   |      |    |
| NOTE BOOK |      |    |
| NO.       |      |    |

| PROFILE   | DATE | BY |
|-----------|------|----|
| SURVEYED  |      |    |
| PLOTTED   |      |    |
| NOTE BOOK |      |    |
| NO.       |      |    |

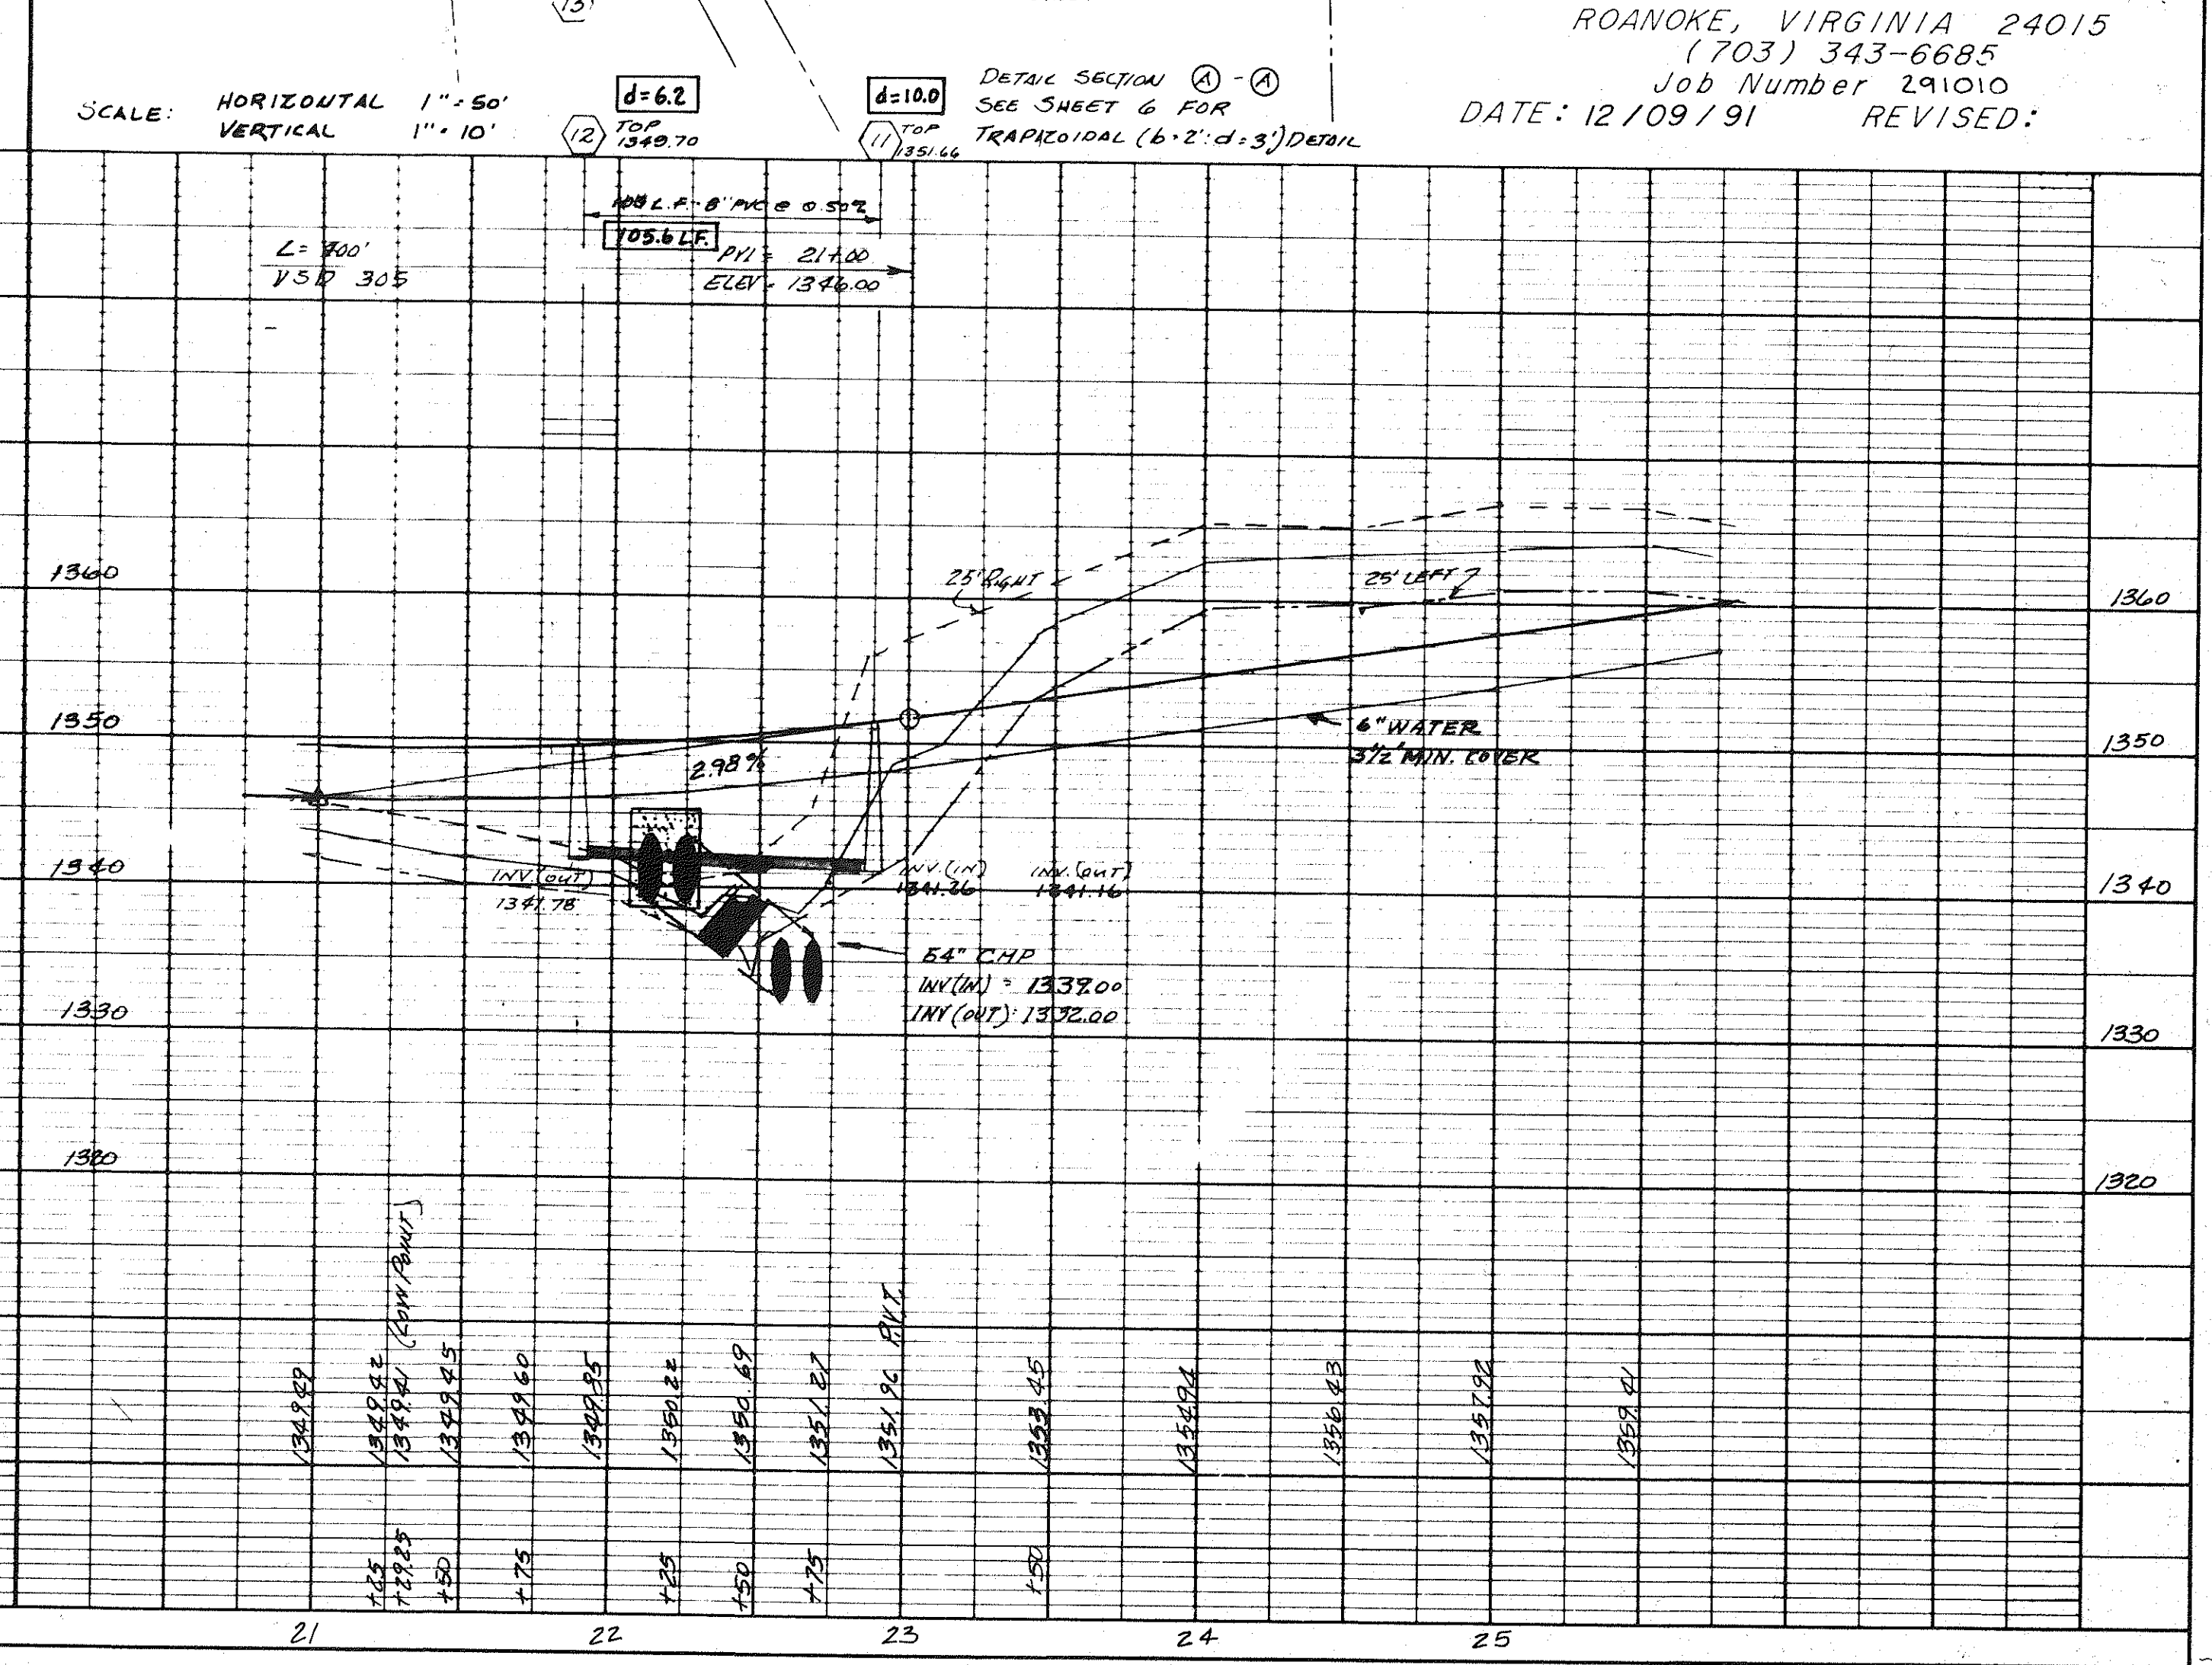
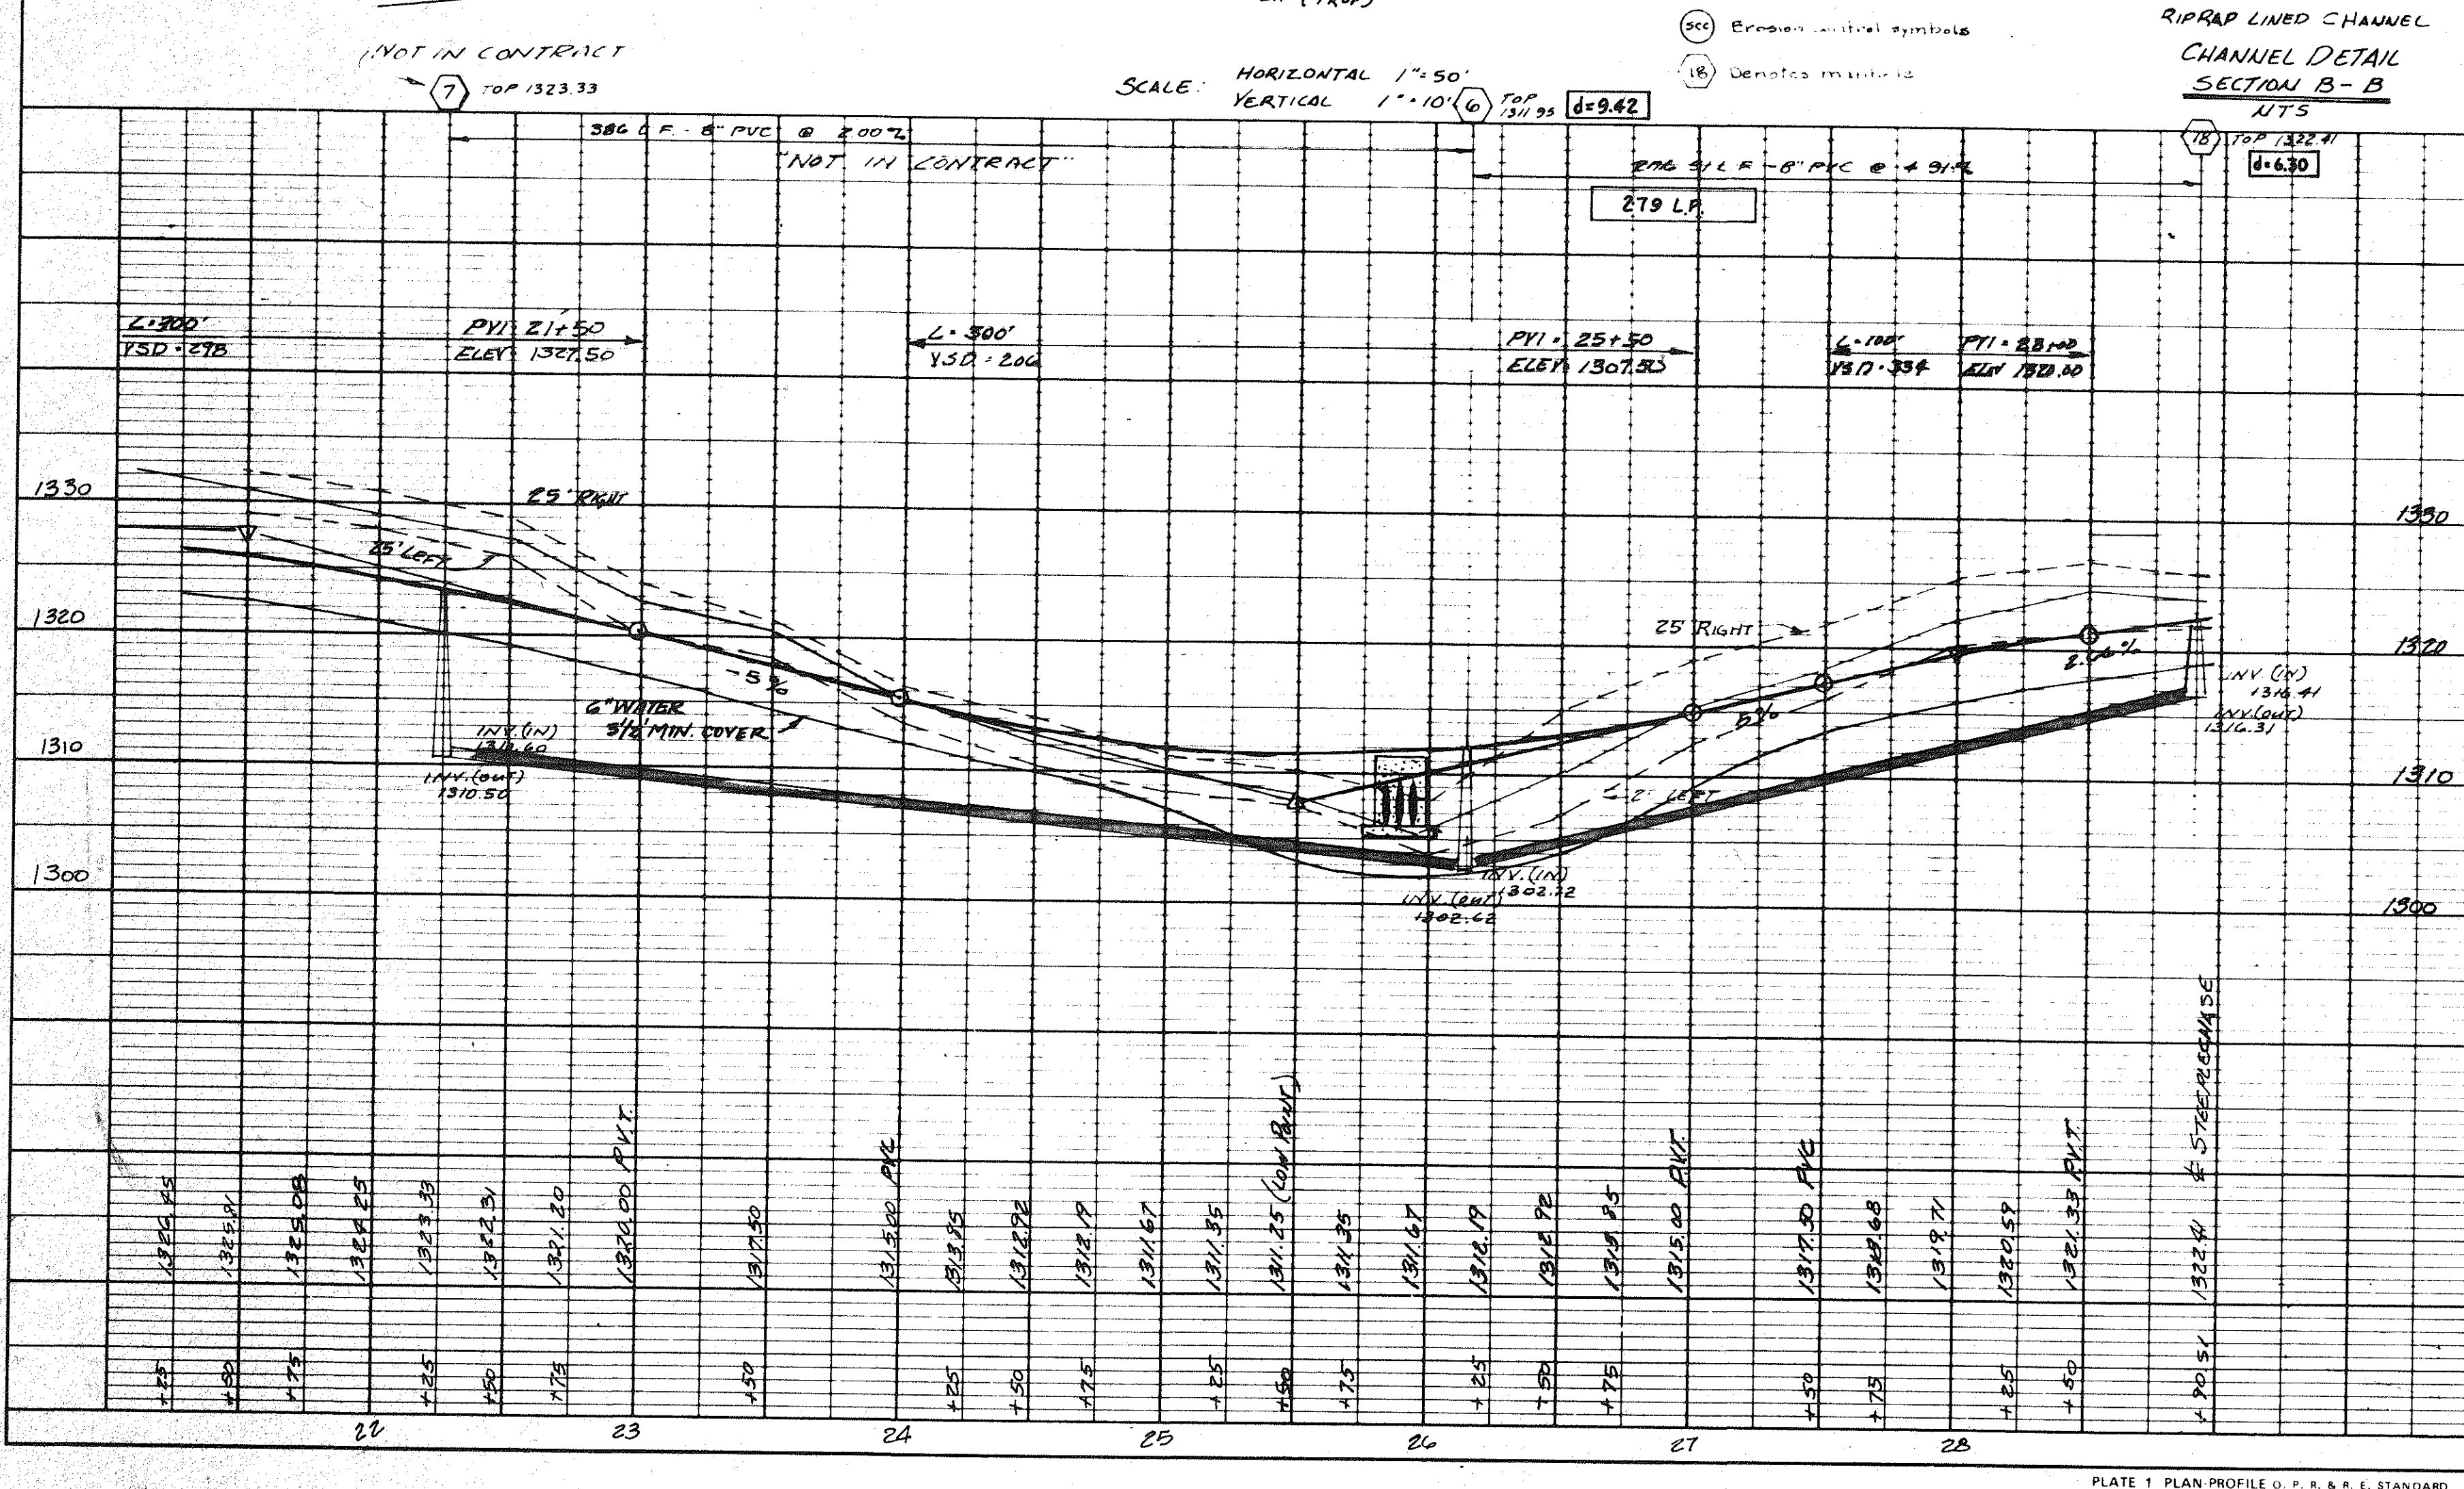
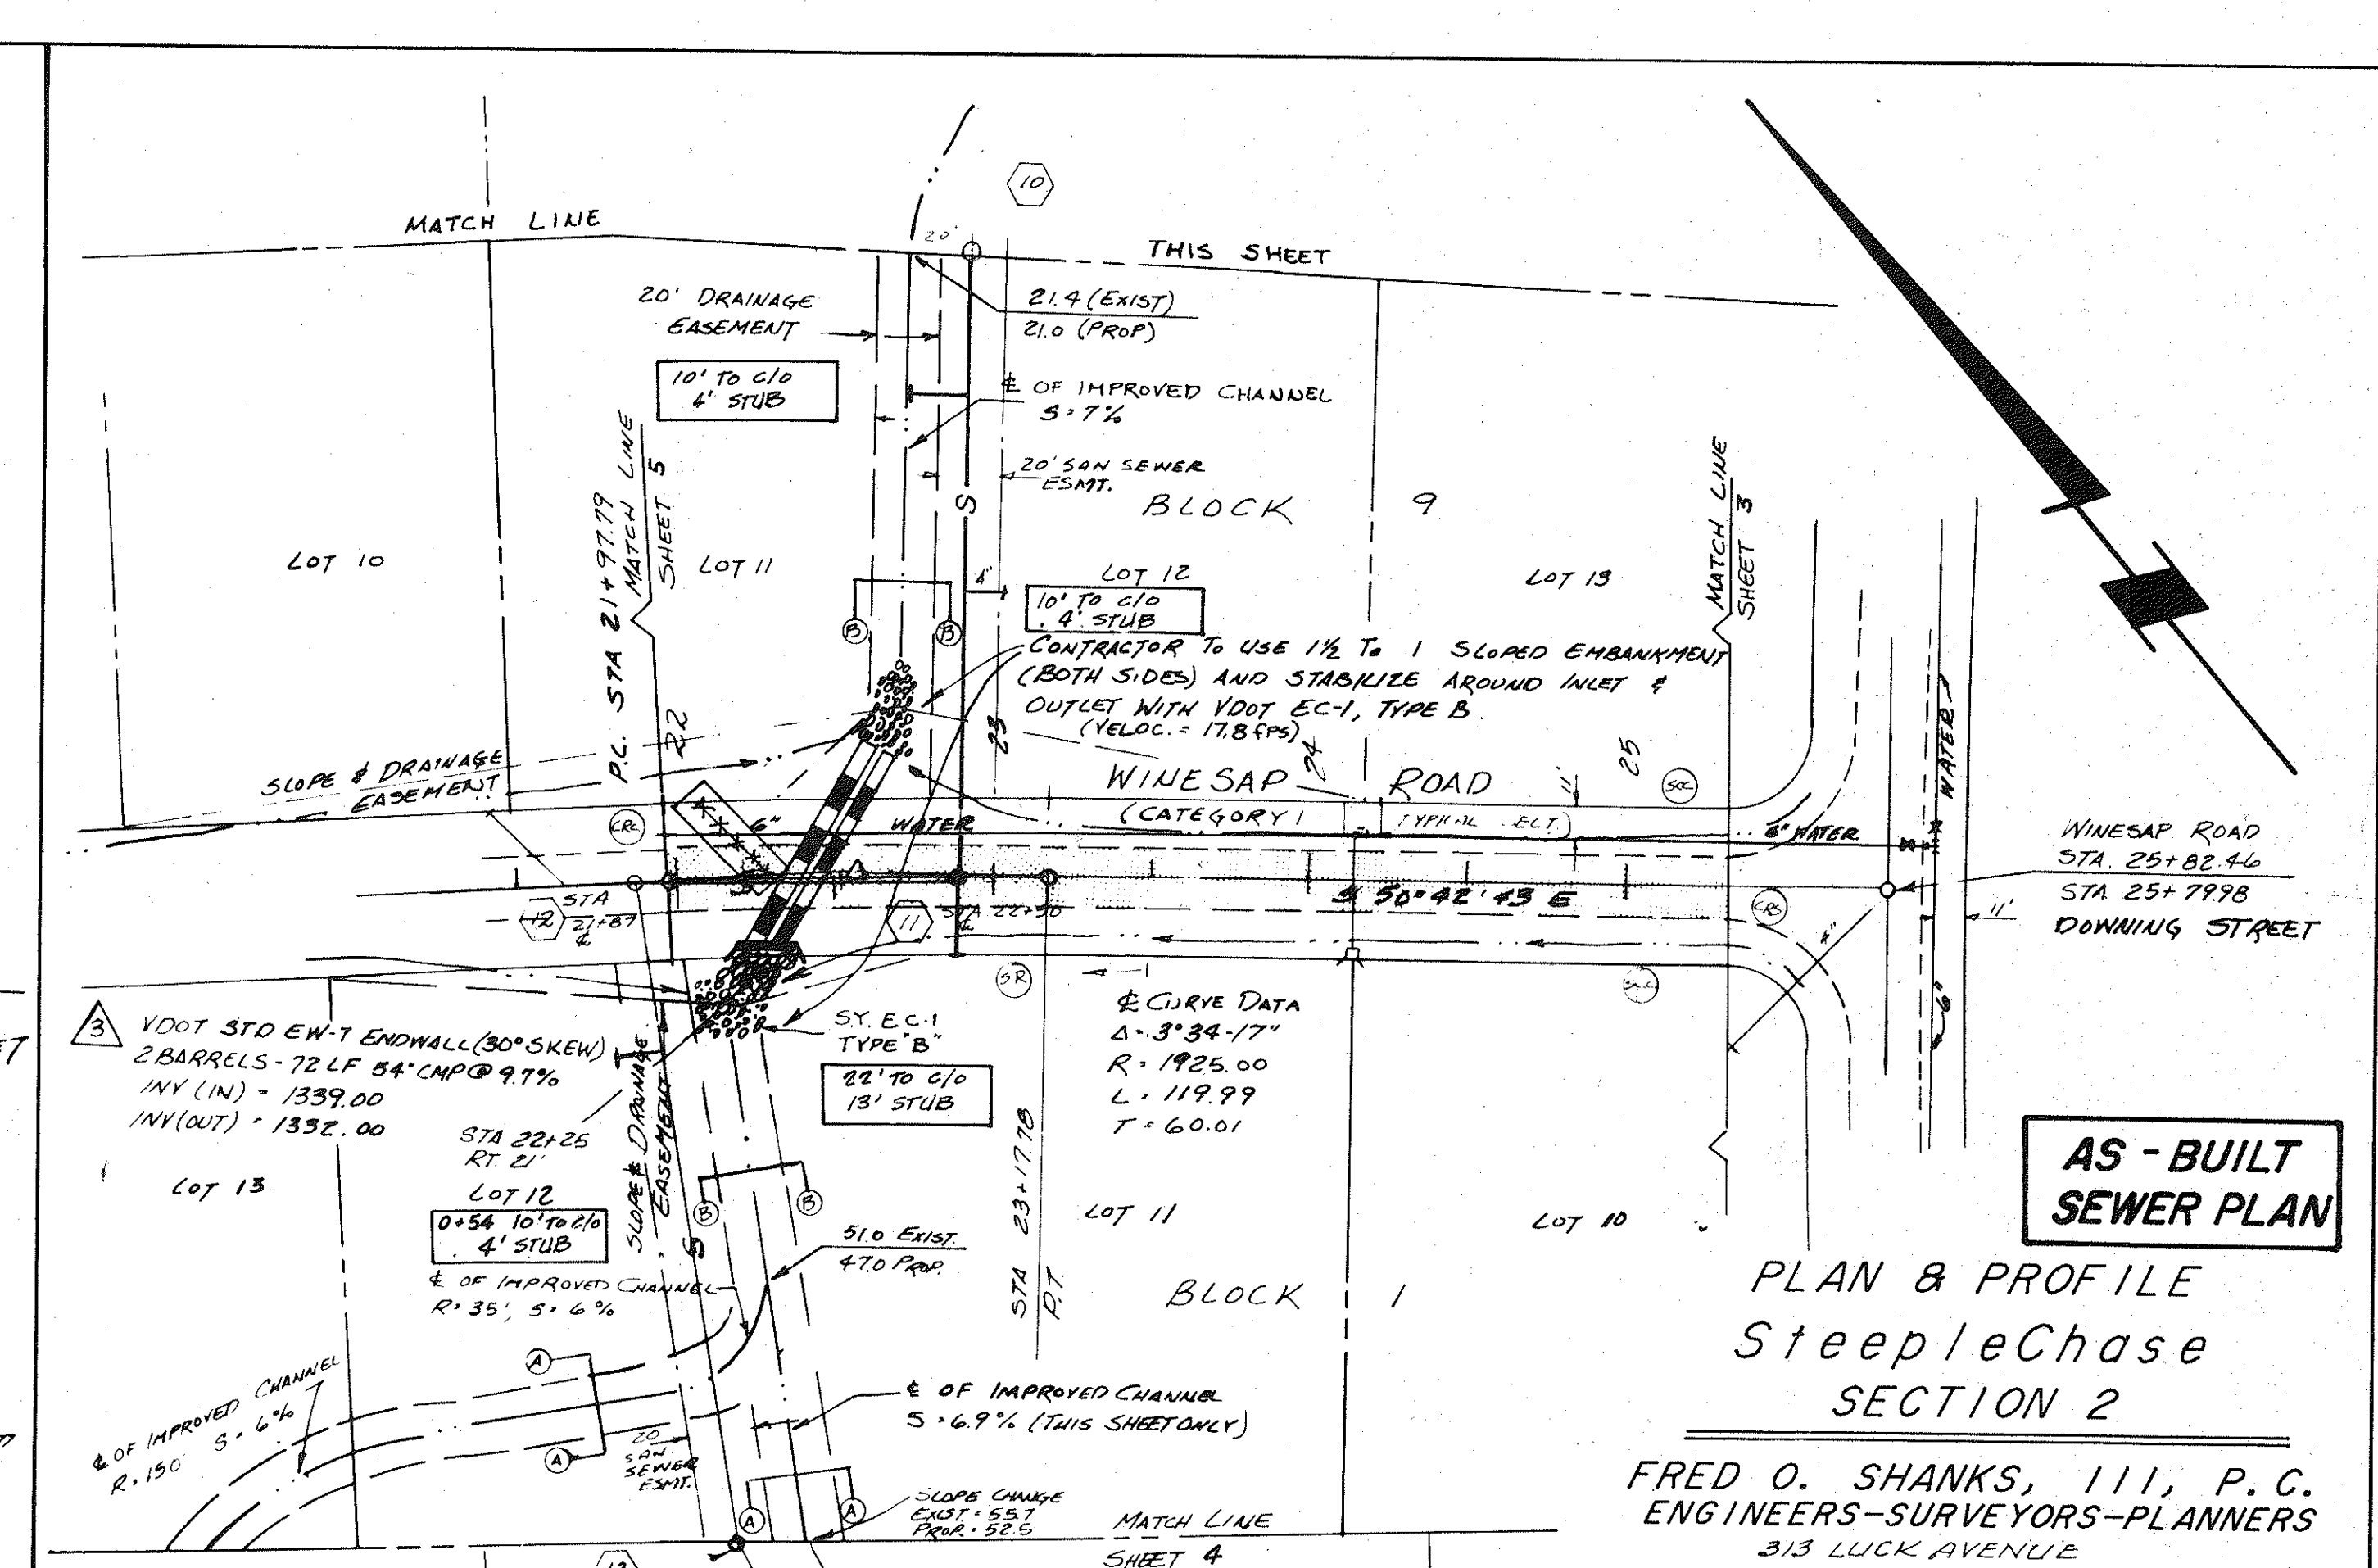
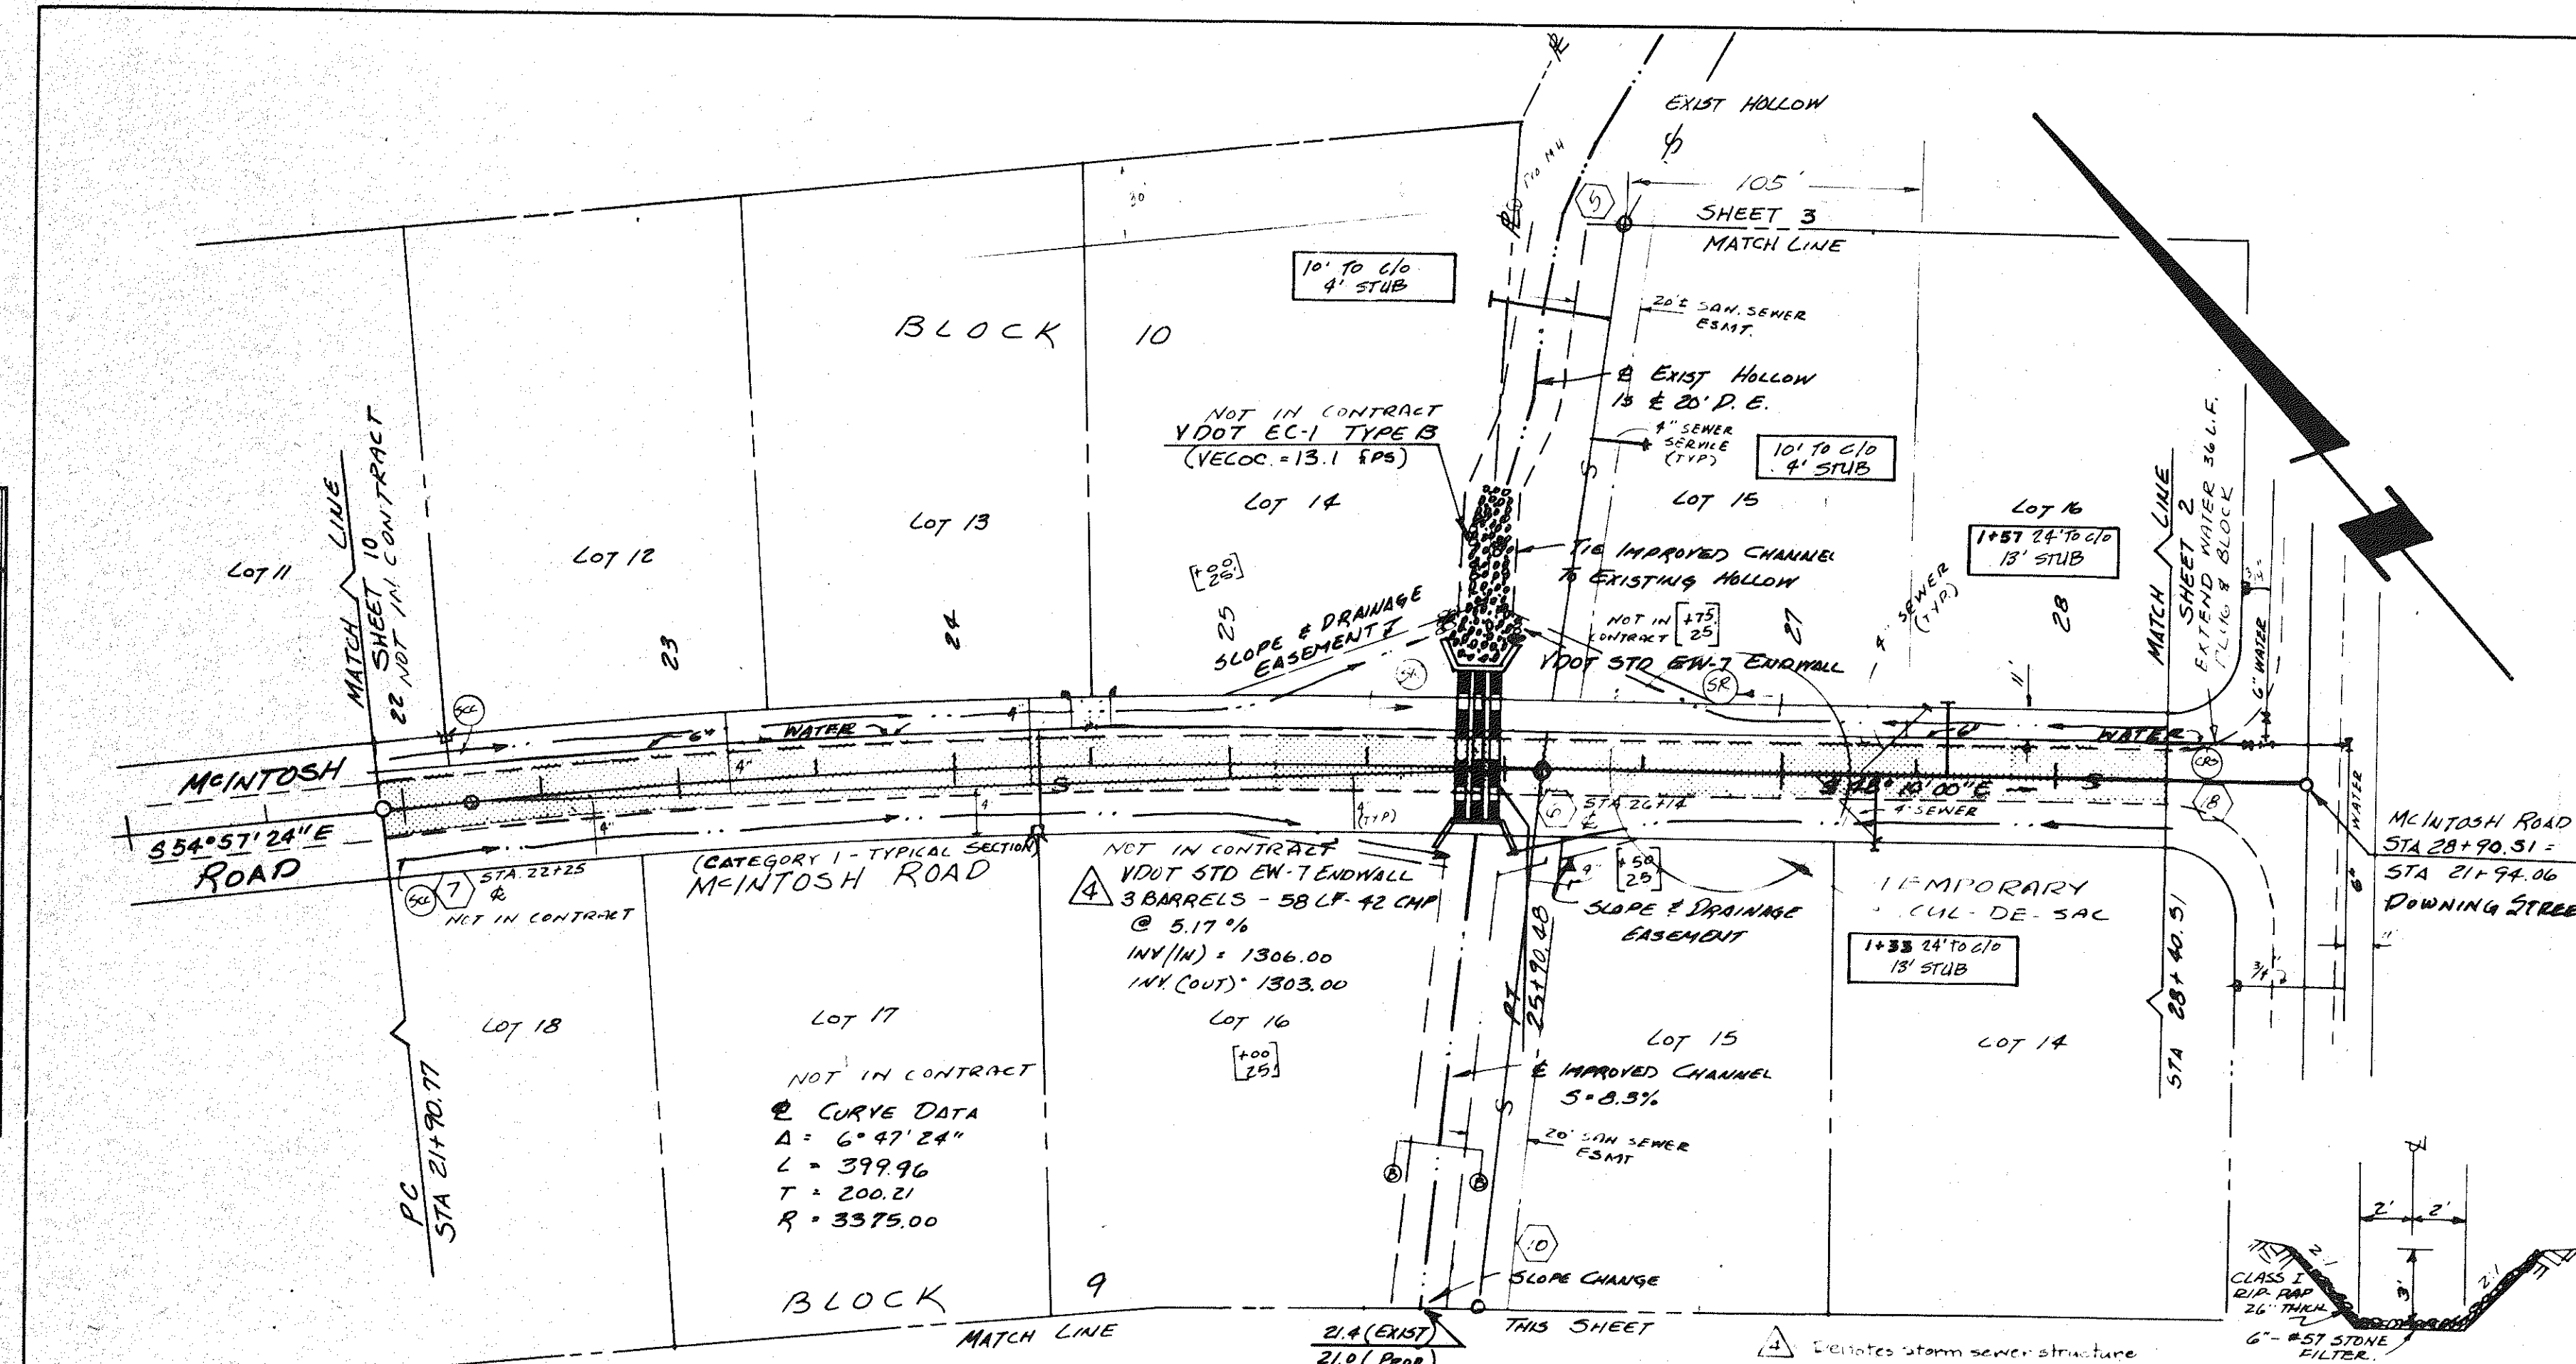



PLATE 1 PLAN-PROFILE O. P. R. & E. STANDARD  
DIETZEN CORPORATION

**AS-BUILT  
SEWER PLAN**


**PLAN & PROFILE  
SteepleChase  
SECTION 2**  
FRED O. SHANKS, III, P.C.  
ENGINEERS-SURVEYORS-PLANNERS  
313 LUCK AVENUE  
ROANOKE, VIRGINIA 24015  
(703) 343-6685  
Job Number 291010  
DATE: 12/09/91 REVISED:

|               |          |  |
|---------------|----------|--|
| PLAN          | DATE     |  |
|               | BY       |  |
|               | BURVEYED |  |
|               | NOTED    |  |
| NOTE BOOK NO. |          |  |


|               |          |  |
|---------------|----------|--|
| PROFILE       | DATE     |  |
|               | BY       |  |
|               | BURVEYED |  |
|               | NOTED    |  |
| NOTE BOOK NO. |          |  |

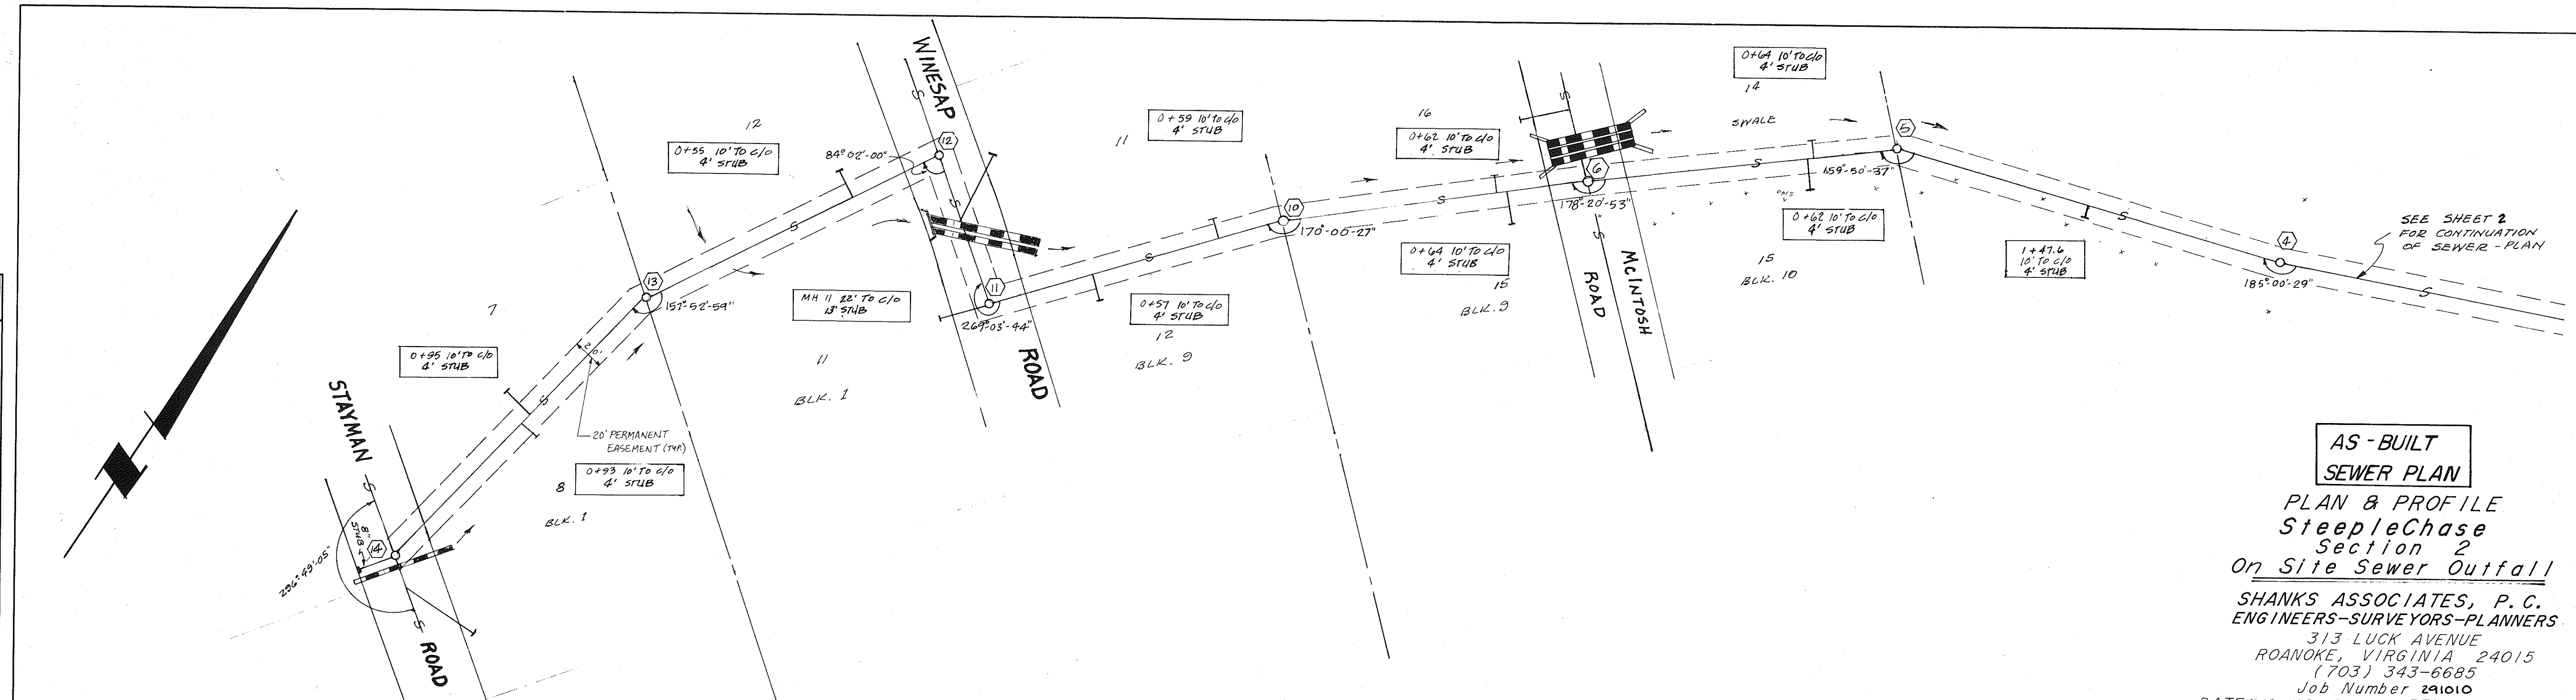


**AS-BUILT  
SEWER PLAN**  
**PLAN & PROFILE**  
**SteepleChase**  
 Section 2  
 On Site Sewer Outfall  
 SHANKS ASSOCIATES, P.C.  
 ENGINEERS-SURVEYORS-PLANNERS  
 313 LUCK AVENUE  
 ROANOKE, VIRGINIA 24015  
 (703) 343-6685  
 Job Number 291010  
 DATE: 12/09/91 REVISED:

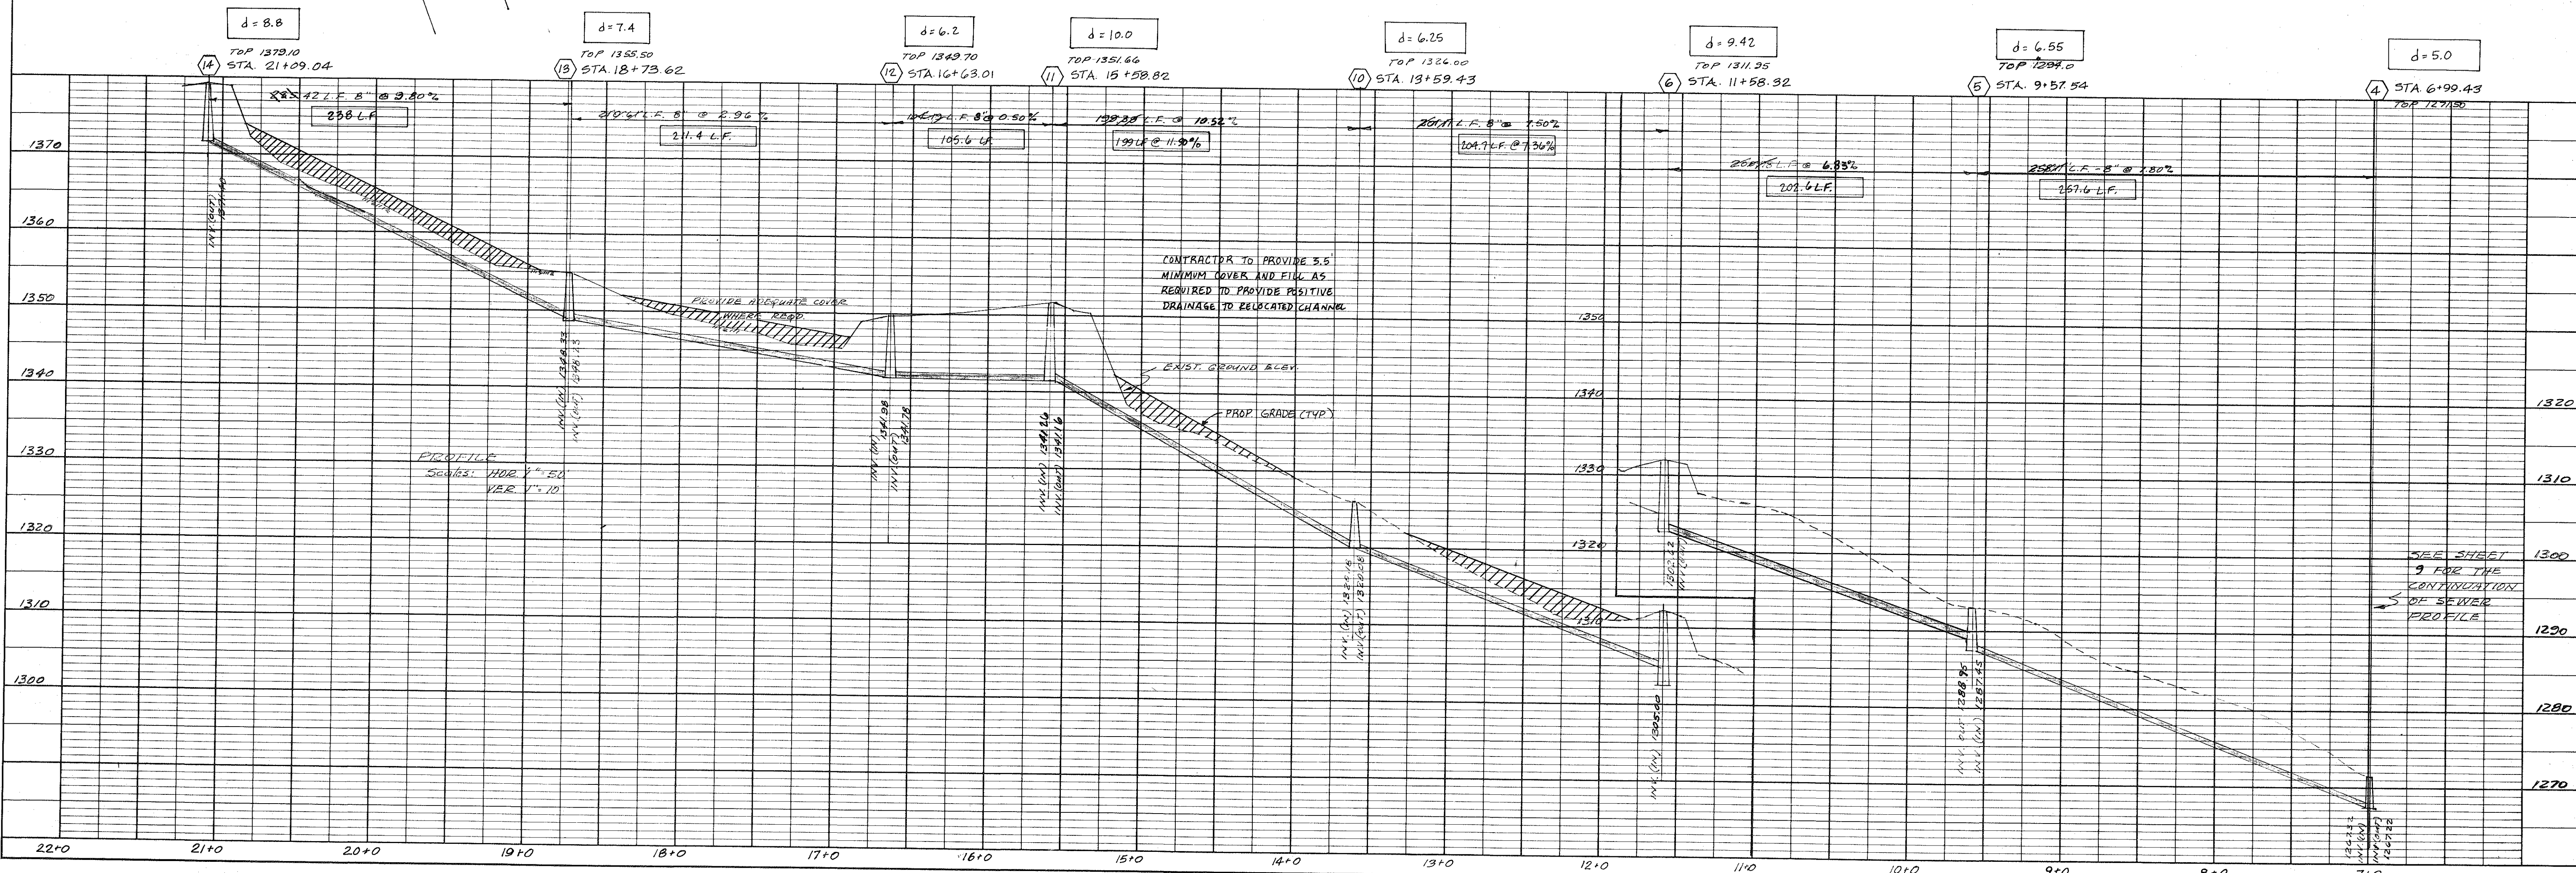

|                  |                                   |          |            |
|------------------|-----------------------------------|----------|------------|
| <b>PROFILE</b>   | SURVEYED _____                    | BY _____ | DATE _____ |
|                  | PLOTTED _____                     |          |            |
| <b>NOTE BOOK</b> | GRADES CHECKED _____              |          |            |
|                  | B. M.'S NOTED _____               |          |            |
| No. _____        | STRUCTURE NOTATIONS CHECKED _____ |          |            |

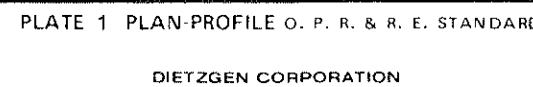

|                  |                                   |          |            |
|------------------|-----------------------------------|----------|------------|
| <b>PROFILE</b>   | SURVEYED _____                    | BY _____ | DATE _____ |
|                  | PLOTTED _____                     |          |            |
|                  | GRADES CHECKED _____              |          |            |
|                  | B. M.'s NOTED _____               |          |            |
|                  | STRUCTURE NOTATIONS CHECKED _____ |          |            |
| <b>NOTE BOOK</b> |                                   |          |            |
| No. _____        |                                   |          |            |

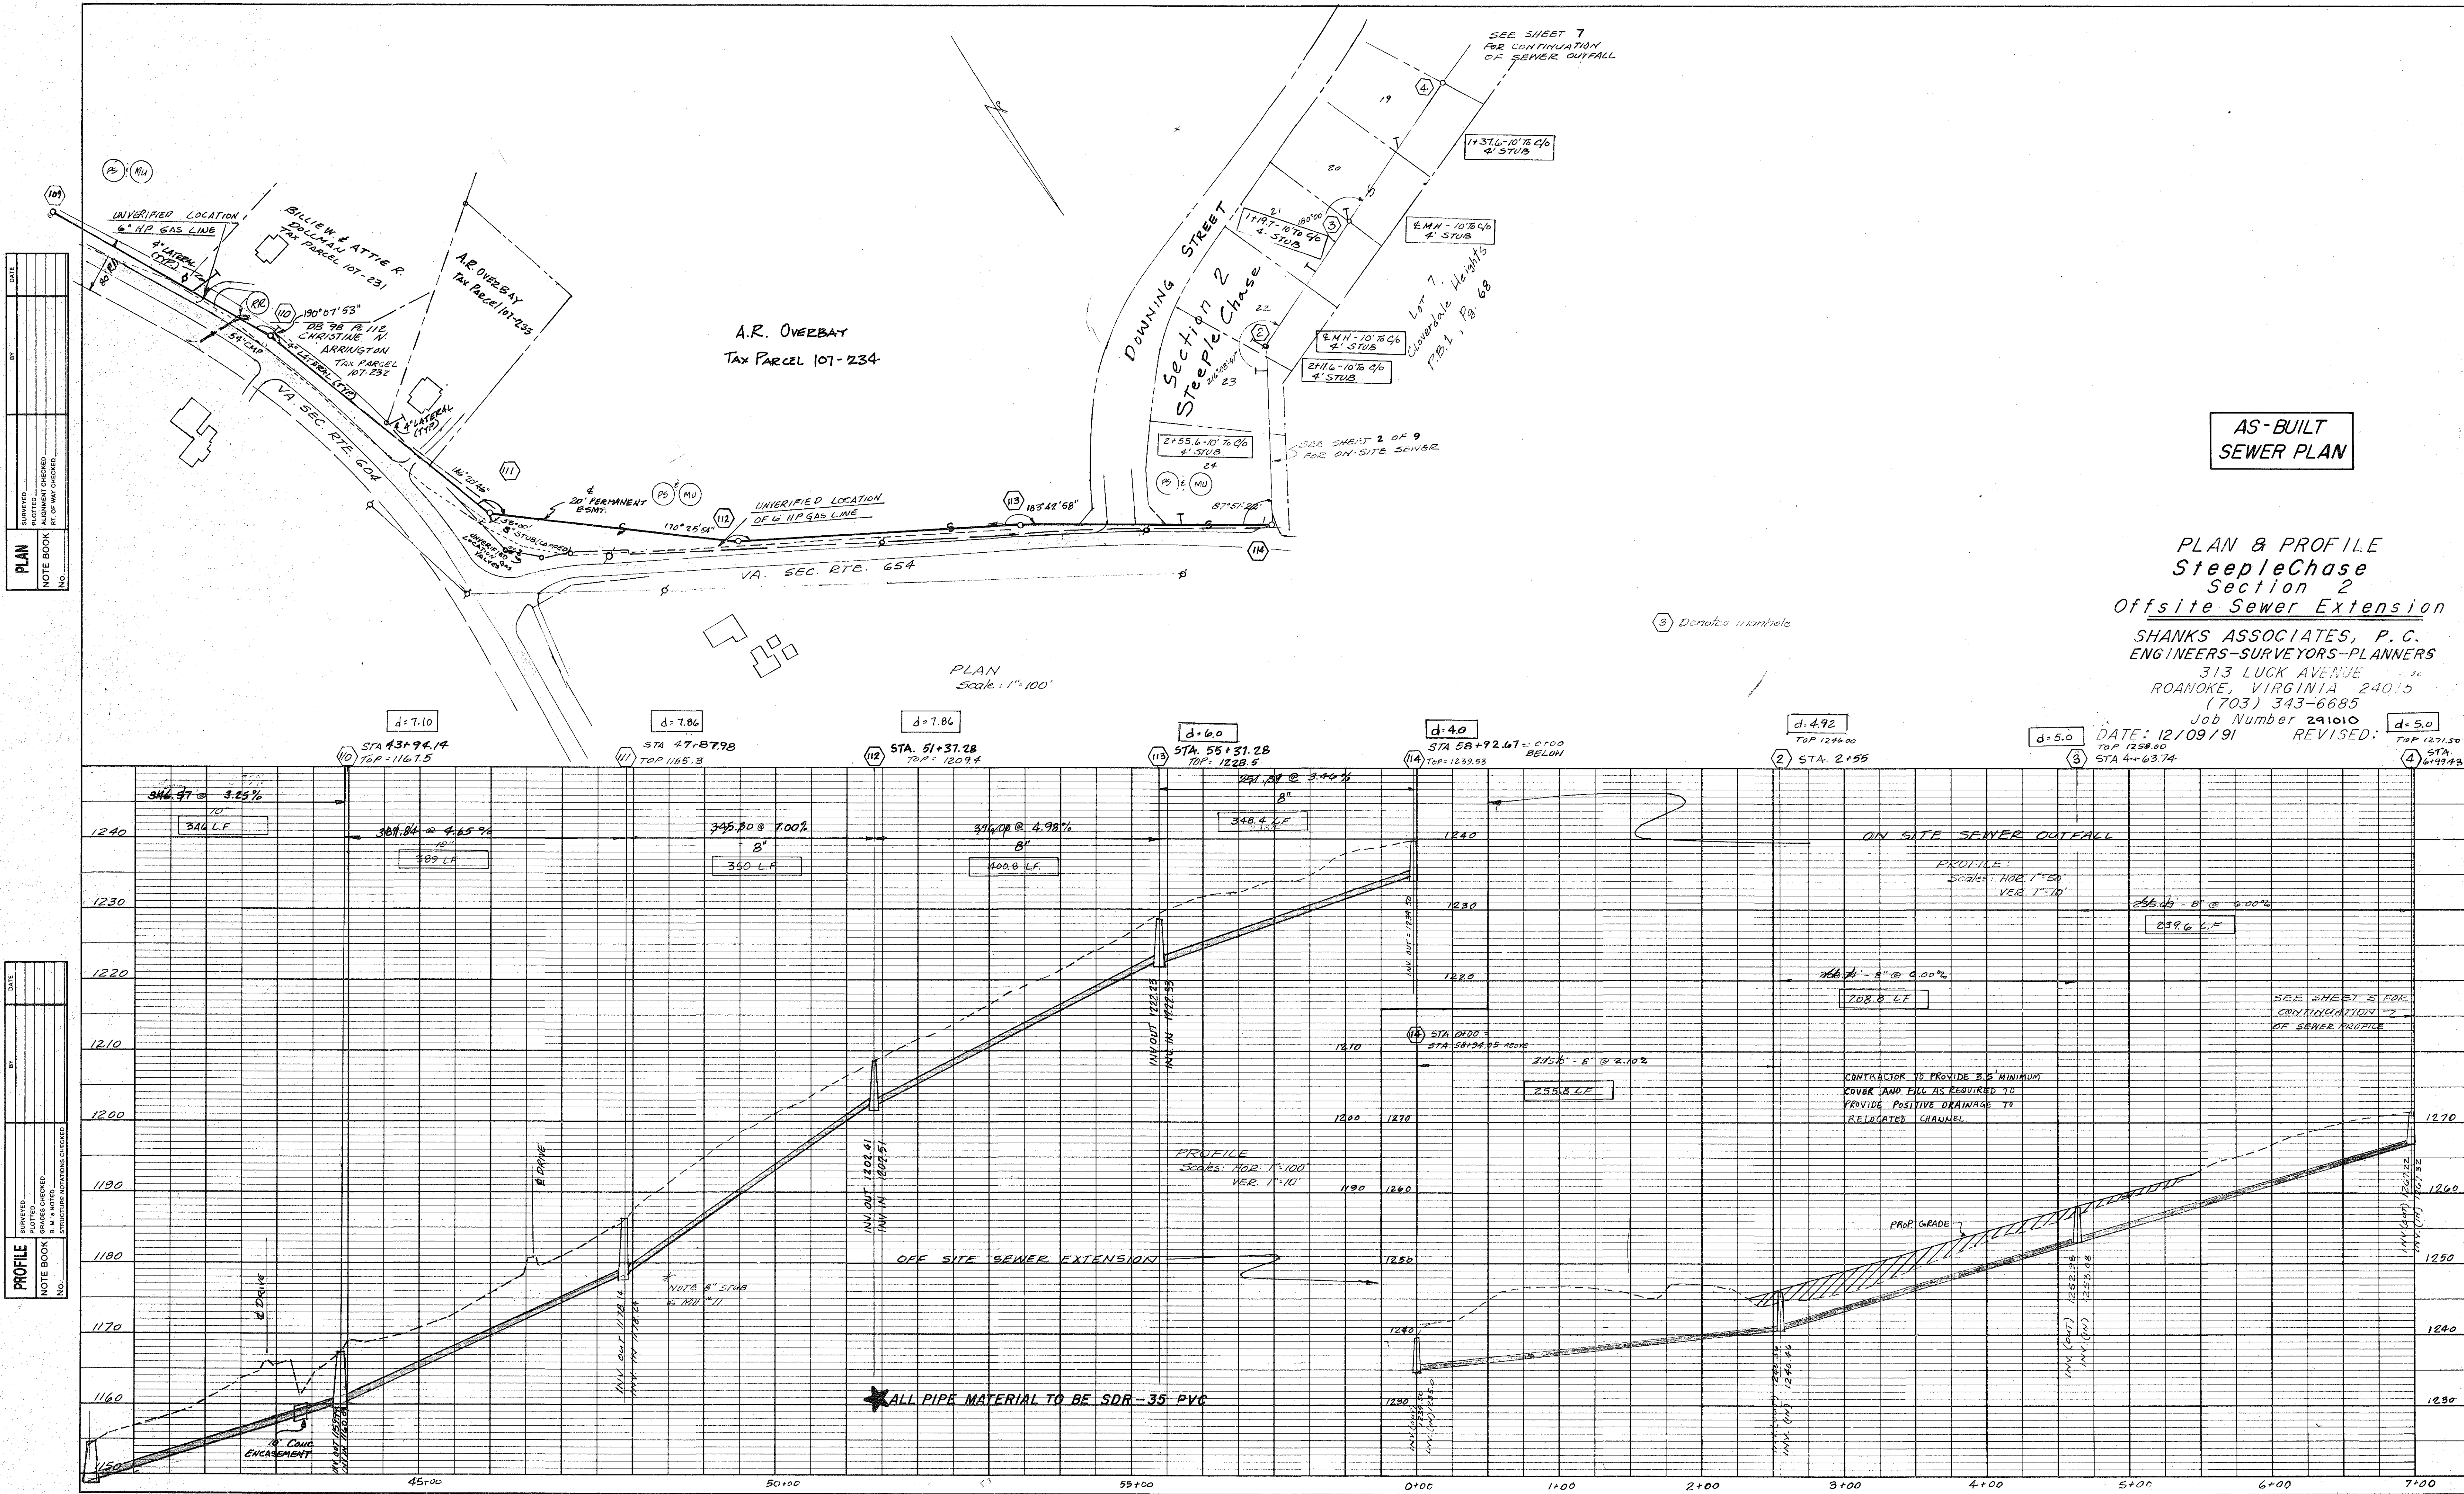

AS-BUILT  
SEWER PLAN

PLAN & PROFILE  
SteepleChase  
Section 2  
Offsite Sewer Extension

SHANKS ASSOCIATES, P. C.  
ENGINEERS-SURVEYORS-PLANNERS  
313 LUCK AVENUE  
ROANOKE, VIRGINIA 24015  
(703) 343-6685  
Job Number 291010

DATE: 12/09/91 REVISED: a=3.0  
TOP 1258.00 TOP 1271.50  
STA. 4+63.74 4 STA. 6+99.43