



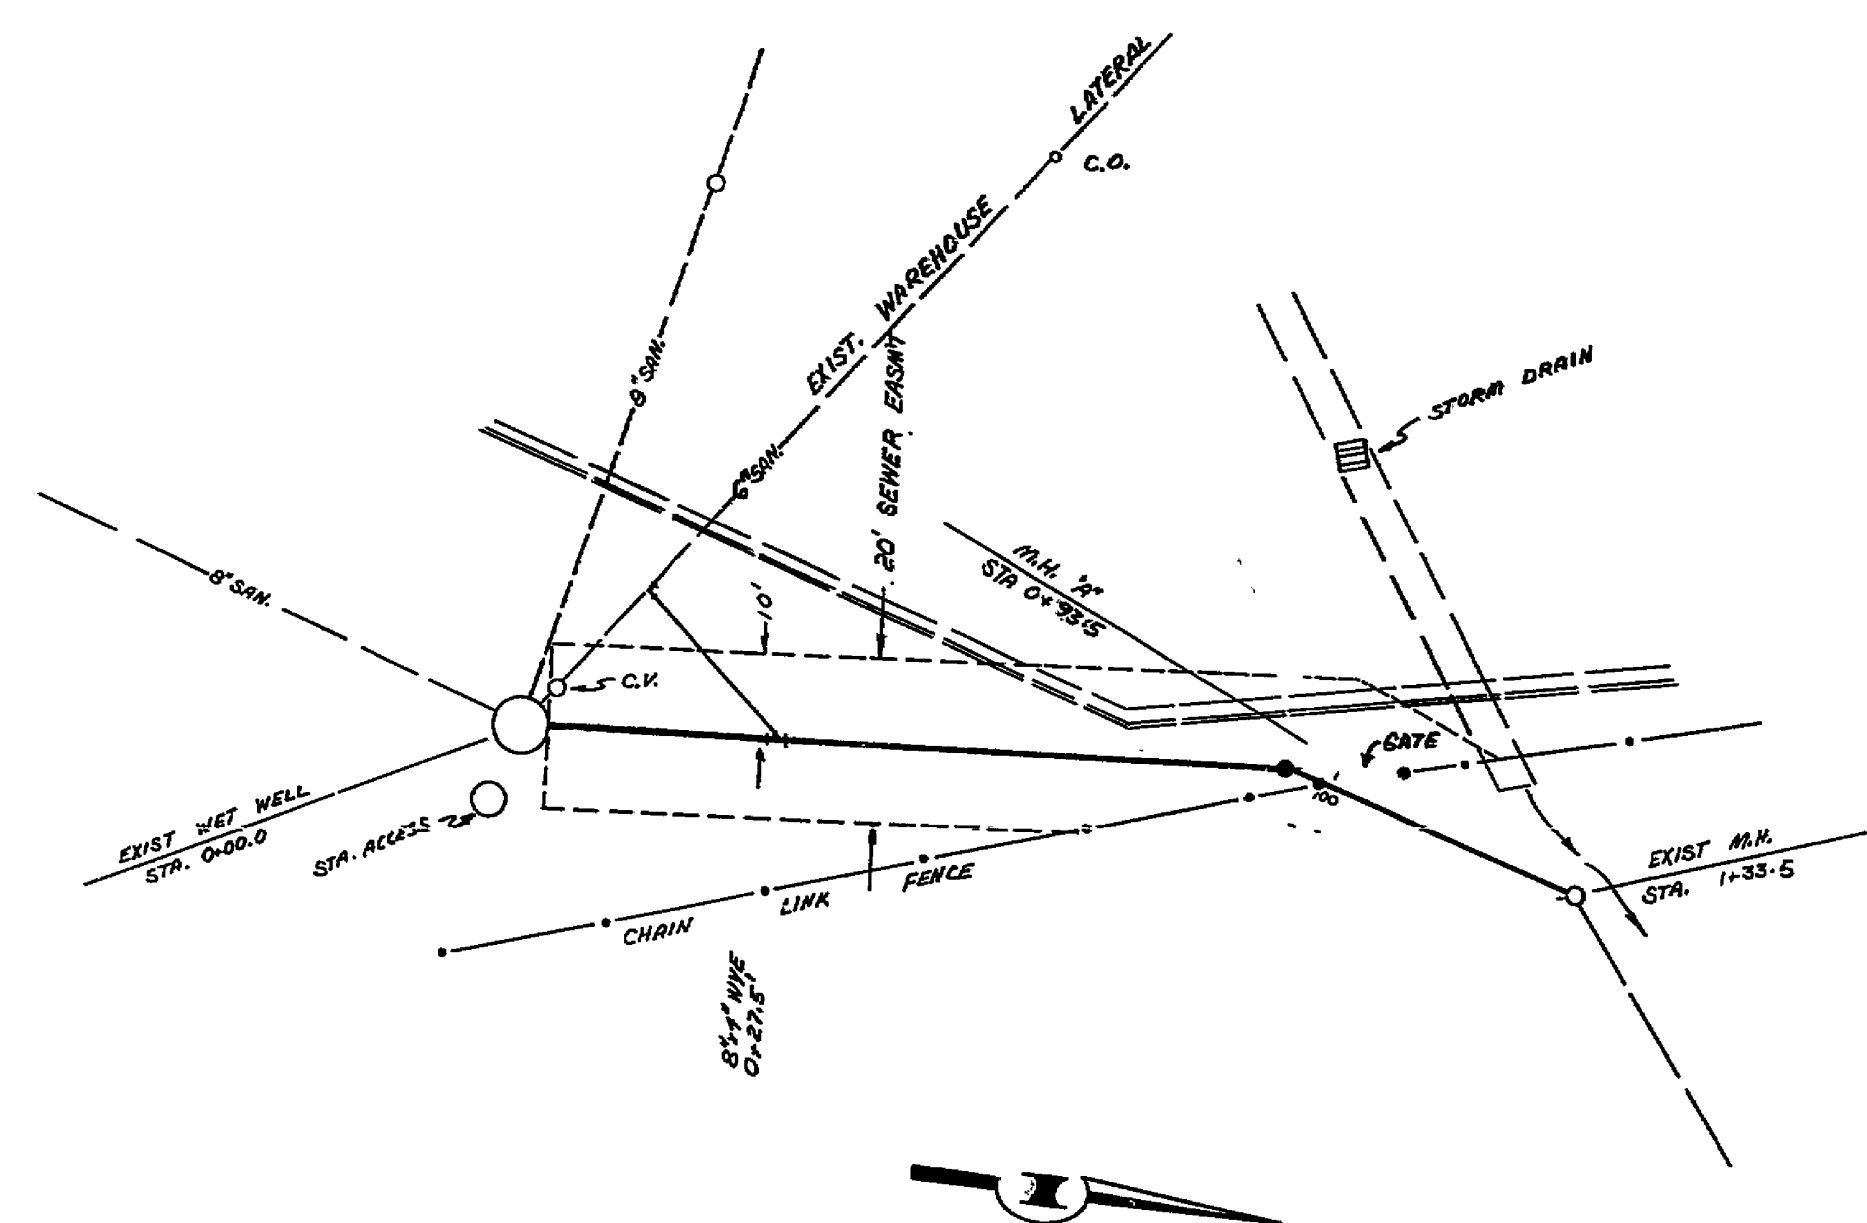

- GENERAL NOTES:
- 1) ALL MATERIAL SHALL BE SUPPLIED AND INSTALLED IN ACCORDANCE WITH THE LATEST EDITION OF THE ROADWORK COUNTY UTILITY DEPT. RULES AND REGULATIONS AND CONSTRUCTION STANDARDS AND SPECIFICATIONS.
 - 2) A MINIMUM COVER OF THREE (3) FEET OVER THE PROPOSED LINES IS REQUIRED.
 - 3) NO WORK SHALL BEGIN WITHOUT NOTIFYING THE R.C.U.D. AT LEAST 24 HOURS IN ADVANCE.
 - 4) WORK SHALL BE INSPECTED BY THE R.C.U.D.
 - 5) ALL EXIST. UTILITIES ~~MAY~~NOT BE SHOWN OR MAY NOT BE SHOWN IN THE EXIST. LOCATIONS. THE CONTRACTOR SHALL COMPLY WITH STATE WATER WORKS REGULATIONS WHERE LINES CROSS.
 - 6) ALL TRENCHES WITHIN THE VIRGINIA DEPT. OF HIGHWAYS AND TRANSPORTATION RIGHT-OF-WAYS MUST BE COMPACTED IN SIX INCH LAYERS.
 - 7) AT LEAST 48 HOURS BEFORE BEGINNING CONSTRUCTION, NOTIFY VIRGINIA DEPT. OF HIGHWAYS AND TRANSPORTATION SERVICE SO THAT EXIST. UTILITIES MAY BE MARKED.
 - 8) PVC PIPE, TYPE PSM, SDR 35 TO BE INSTALLED IN ACCORDANCE WITH THE R.C.U.D. PLASTIC PIPE SPECIFICATIONS.

- SPECIAL NOTES:**
- 1) CONTRACTOR SHALL MAKE PROVISIONS TO INSURE THAT PRESENT FLOW MAY BE MAINTAINED AT ALL TIMES AND NOTIFY THE R.C.U.D. OF THE SUGGESTED METHOD.
 - 2) CONTRACTOR SHALL TAKE CARE NOT TO DISTURB EXISTING PAVEMENT, CURB, AND GUTTER.

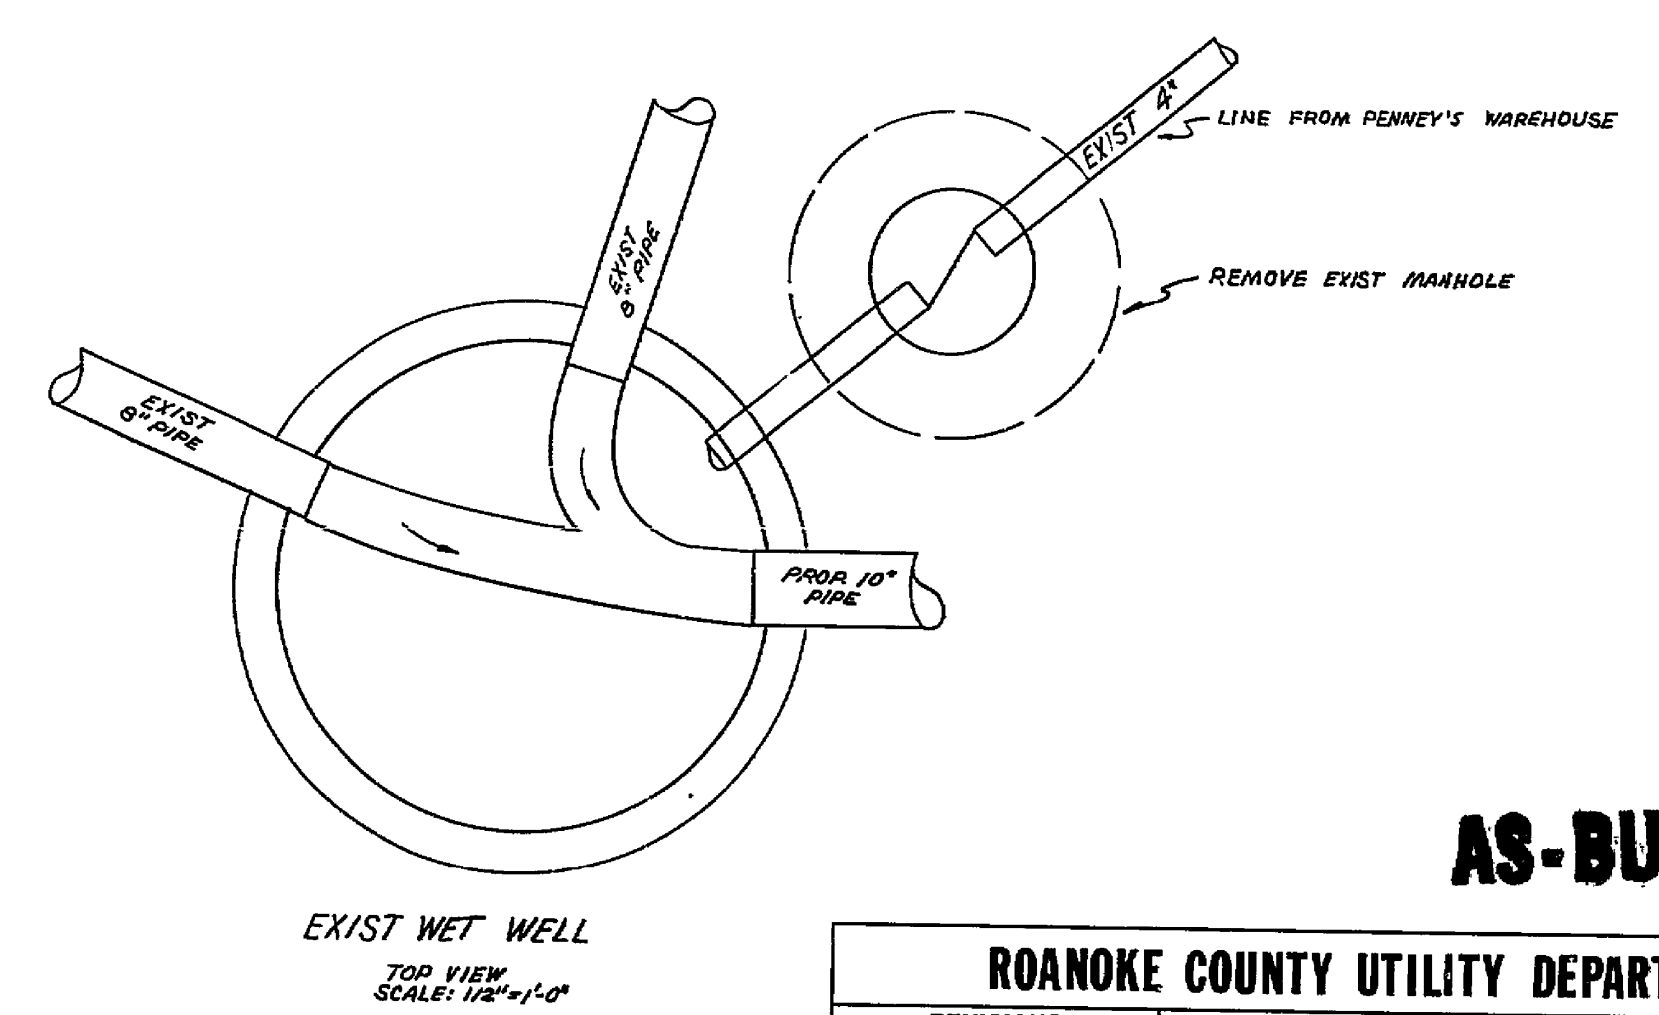

AS-BUILT

ROANOKE COUNTY UTILITY DEPARTMENT		
REVISIONS		
NO.	ITEM	DATE
1	LATERAL REL.	6-2-82
2	AS-BUILT	6-18-82

TANGLEWOOD-02E BRANCH

CONNECTION

APP. BY:	DSN. BY:	GLR
DATE: SEPT 2, 1981	DWG. BY:	MAG
SCALE: AS SHOWN	SHEET:	OF

