GENERAL NOTES

PRE-CONSTRUCTION MEETING AND CONSTRUCTION COMMENCEMENT

- 1. All construction methods and materials shall conform to the Construction Standards and Specifications of Roanoke County, the Western Virginia Water Authority, and the Virginia Department of Transportation.
- 2. Stormwater Management Agreements with an attached 8 1/2" x 11" or 8 1/2" x 14" plat must be approved and recorded prior to the pre-construction meeting.
- 3. Once all required items are submitted to the County of Roanoke, the developer must contact the Development Review Coordinator to indicate that a pre-construction meeting needs to be scheduled. The pre-construction meeting will be scheduled with the owner/developer two (2) working days later.
- 4. All land disturbing projects that require approval of an erosion and sediment control plan, grading or clearing permit shall require that the applicant provide the name of an ndividual who will be responsible for land disturbing activities and that this individual hold a Responsible Land Disturber (RLD) Certificate from the Department of Environmental Quality. The Responsible Land Disturber can be anyone from the Project team that is certified by the Commonwealth of Virginia to be in charge of carrying out the land disturbing activity for the project.
- 5. It is the responsibility of the owner/developer to notify the certified Responsible Land Disturber and the Utility Contractor to attend the pre-construction meeting.
- 6. The Development Review Coordinator will schedule the pre-construction meeting with the County Review Engineer, the County Inspector, and the Western Virginia Water Authority and the Town of Vinton Public Works Department if applicable.
- 7. An approved set of plans, Storm Water Pollution Prevention Plan (SWPPP), VSMP coverage letter, and all permits must be available at the construction site at all times.
- 8. The developer and/or contractor shall supply all utility companies with copies of approved plans, advising them that all grading and installation shall conform to approved plans.
- 9. The project engineer will inform the owner/developer verbally and in writing of the County's obligation to perform inspections on site. Everyone in the meeting will be required to sign a pre-construction checklist indicating their knowledge of Roanoke County's obligation to perform inspections on site.
- 10. The Erosion Control Permit or Combined Erosion Control & VSMP Permit is given to the developer at this pre-construction meeting.
- 11. Notify the County of Roanoke prior to beginning installation of ESC measures. The County will inspect initial installations to ensure compliance with approved plan prior to start of grading. The developer SHALL contact the project inspector 24 hours before beginning any grading or construction on the property.
- 12. County inspectors must inspect storm drain / stormwater management / BMP installations during the process of installation. Please contact the site inspector 24
- 13. All work shall be subject to inspection by Roanoke County, the Western Virginia Water Authority and the Virginia Department of Transportation Inspectors.
- 14. Contractors shall notify utilities of proposed construction at least two (2), but not more than ten (10) working days in advance. Area public utilities may be notified thru "Miss Utility": 1-800-552-7001 or VA 811.
- 15. The 100 year Floodway shall be staked prior to any construction.
- 16. Grade stakes shall be set for all curb and gutter, culvert, sanitary sewer and storm sewer at all times of construction.
- 17. The Department of Community Development shall be notified when a spring is encountered during construction.
- 18. Construction debris shall be containerized in accordance with the Virginia Litter Control Act. No less than one litter receptacle shall be provided on site.
- 19. The contractor shall provide adequate means of cleaning mud from trucks and/or other equipment prior to entering public streets or rights of ways. It is the contractors responsibility to insure that the streets are in a clean, mud and dust free condition at
- 20. Plan approval in no way relieves the developer or contractors of the responsibilities contained within the erosion and sediment control or stormwater management policies.
- 21. Field construction shall honor proposed drainage divides as shown on plans.
- 22. Field corrections shall be approved by the Roanoke County Engineering Division and/or the Western Virginia Water Authority and the Professional of Record, prior to such construction.
- 23. The developer or contractor shall supply the County and the Western Virginia Water Authority with correct As-Built plans before final acceptance.


VIRGINIA DEPARTMENT OF TRANSPORTATION:

- 24. Plan approval by Roanoke County does not guarantee issuance of any permits by the Virginia Department of Transportation.
- 25. A permit must be obtained from the Virginia Department of Transportation, Salem Residency Office prior to construction in the highway right-of-way.
- 26. The preliminary pavement designs should be based on a predicted sub-grade CBR value of 7.0 and with a Resiliency Factor (RF) of 2.0 as shown in Appendix I of the 2000 Virginia Department of Transportation Pavement Design Guide for Subdivision and Secondary Roads. The sub-grade soil is to be tested by an independent laboratory and the results submitted to the Virginia Department of Transportation prior to base construction. Should the sub-grade CBR value and/or the RF value be less than the predicted values, additional base material will be required in accordance with Departmental specifications. Refer to the same manual as the number and locations of the required soil samples to be tested. All pavement designs shall be submitted to the Department for review and approval. The sub-grade shall be approved by the Virginia Department of Transportation prior to placement of the base. Base shall be approved by the Virginia Department of Transportation for depth, template, and compaction before the surface is applied.
- Standard guardrail with safety end sections may be required on fills or in areas where hazards exist as deemed necessary. After completion of rough grading operations, the County Engineer and Virginia Department of Transportation shall be contacted to schedule a field review. Where guard rail is warranted, the standard shoulder width shall be provided and the guard rail shall be installed in accordance with the 2001 VDOT Road and Bridge Standards as part of this development.
- 28. Standard street and traffic control signs shall be erected at each intersection by the developer prior to final street acceptance.
- 29. All traffic devices shall be in accordance with current edition of the "Manual on Uniform Traffic Control Devices" (MUTCD).
- 30. All unsuitable material shall be removed from the construction limits of the roadway before placing embankment.

See Sheet <u>C4</u> for Stormwater Site Statistics Table. See Sheet N/A for New BMP Information Table.

The Project Engineer shall provide electronic copies of the approved plans to the Development Review Coordinator within 5 working days of the pre-construction

The notes on this sheet shall not be modified.

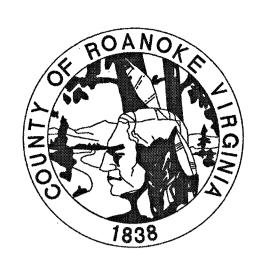

COUNTY OF ROANOKE, VA

EARTHWORK

TRENCH DRAIN

ROOF LEADER

WATER METER

PAVEMENT (INCLUDING SUB-BASE)

FIRE HYDRANT ASSEMBLIES

SANITARY SEWER LATERAL

LANDSCAPING (SEE SHEET C-9)

AS-BUILT PLANS - STORM SEWER


NAME OF DEVELOPMENT 202 - KROGER FUEL CENTER AM AWARE OF THE SITE DESIGN REQUIREMENTS IMPOSED BY THIS SITE DEVELOPMENT PLAN AND OTHER APPLICABLE ROANOKE COUNTY CODES. I HEREBY CERTIFY THAT I AGREE TO COMPLY WITH THESE REQUIREMENTS AND THE THIRTY (30) POINTS SHOWN ON THIS COVER SHEET UNLESS MAGISTERIAL DISTRICT(S) CAVE SPRING MODIFIED IN ACCORDANCE WITH LOCAL LAW. TANGLEWOOD VENTURE, LLC OWNER (name, address, telephone) 700 MONTGOMERY HIGHWAY - SUITE 186 BIRMINGHAM, AL 35216 KROGER LIMITED PARTNERSHIP. DEVELOPER (name, address, telephone) 3631 PETERS CREEK ROAD ROANOKE, VIRGINIA 24019 BALZER AND ASSOCIATES, INC. ENGINEER, ARCHITECT OR SURVEYOR (name, address, telephone) 1208 CORPORATE CIRCLE ROANOKE, VA 24018 ATTN: BEN CREW 540-772-9580 FAX 540-772-8050 TAX MAP NO(S) 077.16-01-02.00-0000

WATER NOTES

- All water facilities shall be constructed according to the Western Virginia Regional Design and Construction Standards (Latest Edition).
- A minimum cover of three (3) feet is required over proposed lines.
- Contractor shall be responsible for locating and uncovering valve vaults after paving and adjustment to final grade if necessary.
- All existing utilities may not be shown in their exact location. The contractor shall comply with the (State Water Works Regulations, Section 12VAC5-590-1150, where lines cross.
- All trenches in existing or future highway right-of-ways shall be compacted according to Virginia Department of Transportation
- standards. Lines shall be staked prior to construction.
- Water main shall be minimum Class 350 Ductile Iron in accordance to AWWA C151 or DR-14 PVC in accordance with AWWA C-900.

Ductile Iron Pipe in accordance with the Western Virginia Regional Design and Construction Standards shall be required for all pipe with

Western Virginia Water Authority Availability letter number: ______20-068

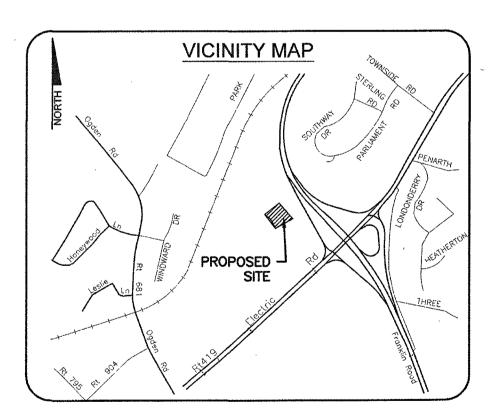

LEGEND

	Accordance of the Control of the Con
operty Line	
ght-of-way	
enterline	
nimum Building Line	MBL
sisting Storm Sewer	48"RCP 48"RCP
isting Sanitary Sewer	arranancementer of SAN annumental accession of contractions and the second
isting Water Main	8" WL
isting Contour	1155
oposed Contour	1155
oposed Drainage Divide	MANAGEMENT NAMED AND ADDRESS OF THE PARTY OF
oposed Limits of Clearing	
oposed Storm Sewer	
oposed Sanitary Sewer	8" SS
oposed Water Main	8" W
Be Removed	T.B.R.

SEWER NOTES

- All sanitary sewer facilities shall be installed according to the Western Virginia
- A minimum cover of three (3) feet is required over proposed lines

- Virginia Department of Transportation standards.

PRIVATE UTILITIES

Underground utilities installed on private property or in private utility easements and building related storm drains shall be designed and installed per the current edition of the Virginia Uniform Statewide Building Code. Design and installation to be permitted through and inspected by the Roanoke County Inspections Office.

Sheet Index

- COVER SHEET **EXISTING CONDITIONS & DEMO. PLAN** LAYOUT & UTILITY PLAN **GRADING PLAN** E.S.C. PLAN
- E.S.C. NOTES
- C10 GENERAL NOTES
- C11 SITE DETAILS
- C12 WVWA DETAILS C13 TRUCK TANKER ROUTE
- **E4.0 EXTERIOR LIGHTING PLAN**

SURVEY INFORMATION

Horizontal and vertical control s By: BALZER &	ASSOCIATES, IN	IC. (B & A INC.	<u> </u>
All vertical elevations must be r All horizontal elevations must b			Vertical Datum of 1929 or 198 Datum of 1927 or 1983.
Horizontal Datum: 198	3	tical Datum:	4000
Source of topographic mapping	is dated AP	RIL 2020	
Boundary was performed by	B & A INC.	dated:	APRIL 2020
	EXISTING STORI	N SEWER INLE	T
	TOP=1110.09'		

- Regional Design and Construction Standards. (Latest Edition).
- Contractor shall be responsible for locating and uncovering all manholes after paving. Manhole tops shall be adjusted to grade if necessary.
- All existing utilities may not be shown in their exact location. The contractor shall comply with (State Water Works Regulations, Section 12VAC5-590-1150, where
- All trenches in existing or future rights-of-way shall be compacted according to Lines shall be staked prior to construction.

requirements issued by the Western Virginia Water Authority that meet or exceed the USBC requirements are acceptable for private utilities. All private utilities are Vaults, valves and other devices installed by or under the control of the Western Virginia Water Authority may not substituted for the code required devices.

E.S.C. DETAILS STORM SEWER DETAILS LANDSCAPE PLAN

orizontal and vertical control y:BALZER &			
Il vertical elevations must be	referenced to the Na	ational Geodetic	: Vertical Datum of 1929 or 198
Il horizontal elevations must	be referenced to the	North American	Datum of 1927 or 1983.
orizontal Datum: 19	83 Verl	tical Datum:	1988
ource of topographic mappin	g is dated API	RIL 2020	
oundary was performed by _	B & A INC.	dated:	APRIL 2020
enchmark Information:	EXISTING STORM	SEWER INLE	T
	TOP=1110.09'		

NOTE: THIS COST ESTIMATE TABLE IS PROVIDED FOR BONDING PURPOSES ONLY. VERIFICATION OF ALL QUANTITIES AND PRICES FOR BIDDING PURPOSES SHALL BE THE RESPONSIBILITY OF THE BIDDER.

UNIT PRICE COST BONDABLE

\$2,500.00

\$1,500.00

\$1,500.00

\$3,500.00

\$ 1,500.00

\$ 275.00

\$1,500.00

\$2,500.00

\$1,500.00

\$42,000.00

\$1,500.00

\$3,500.00

\$ 1,500.00

\$ 275.00

\$2,500.00

\$1,500.00

\$42,000.00

\$1,500.00

\$3,500.00

\$ 1,500.00

\$ 275.00

\$ 5,478.00

\$60,253.00

QUANTITY & COST ESTIMATE

QUANTITY UNIT

C.Y.

LUMP SUM

EACH

EACH

EACH

LUMP SUM

& ASSOCIATES PLANNERS / ARCHITECTS ENGINEERS / SURVEYORS www.balzer.cc

1208 Corporate Circle Roanoke, Virginia 24018 Phone: 540/772-9580 FAX: 540/772-8050

15871 City View Drive Phone: 804/794-0571

80 College Stree Phone: 540/381-4290 FAX: 540/381-4291

Verona, Virginia 24482 Phone: 540/248-3220 FAX: 540/248-3221


128 West Market Street Phone: 540/433-1908

901 Jeffeson Street

DRAWN BY: DESIGNED BY: CHECKED BY:

REVISIONS:

Value / + Sleeve hydrant is a AVK 2020, TA6 # 21331

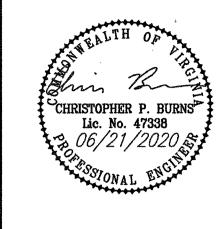

Midlothian, Virginia 23113 FAX: 804/794-2635

Christiansburg, Virginia 24073

1561 Commerce Road

Harrisonburg, Virginia 22801

Lynchburg, Virginia 24504 Phone: 434/528-5184

BTC BTC 05/21/2020

06/21/2020

Hydrant- 6"DIP Class 350 6" AVK TAPPINS

Pressure Statie : 125ps



24018 ELECTRIC ROAD COUNTY, VIRGINIA

As-builts Are Per Plan-Locations & Install per plan. | Inspector: Brian Whitenack-WWWD

4488 NOKE

BY SEALING THE PLANS, THE DESIGN PROFESSIONAL HEREBY CERTIFIES THAT THE FOREGOING ESTIMATE REFLECTS THE CURRENT

SUB-TOTAL 10% CONTINGENCY

ESTIMATED TOTAL

IMPROVEMENT COSTS OF THIS PROJECT.