


- NATIONAL 6" x 4" C900 DR 14 PVC
- AMERICAN FLOW CONTROL 6" x 4" GATE VALVES
- ENDOT 1" PE 4710 HDPE

* WATER	BAG T	SAMPLES "	TAKEN FROM TEMP. END OF LINE BLOW-OFF "
11-07-16	1000	CL ₂ : 0.65	" FAILED "
11-08-16	1115	CL ₂ : 0.71	" PASSED "
11-09-16	1115	CL ₂ : 0.66	" PASSED "


* TRACER WIRE CONTINUITY TEST 12-02-16

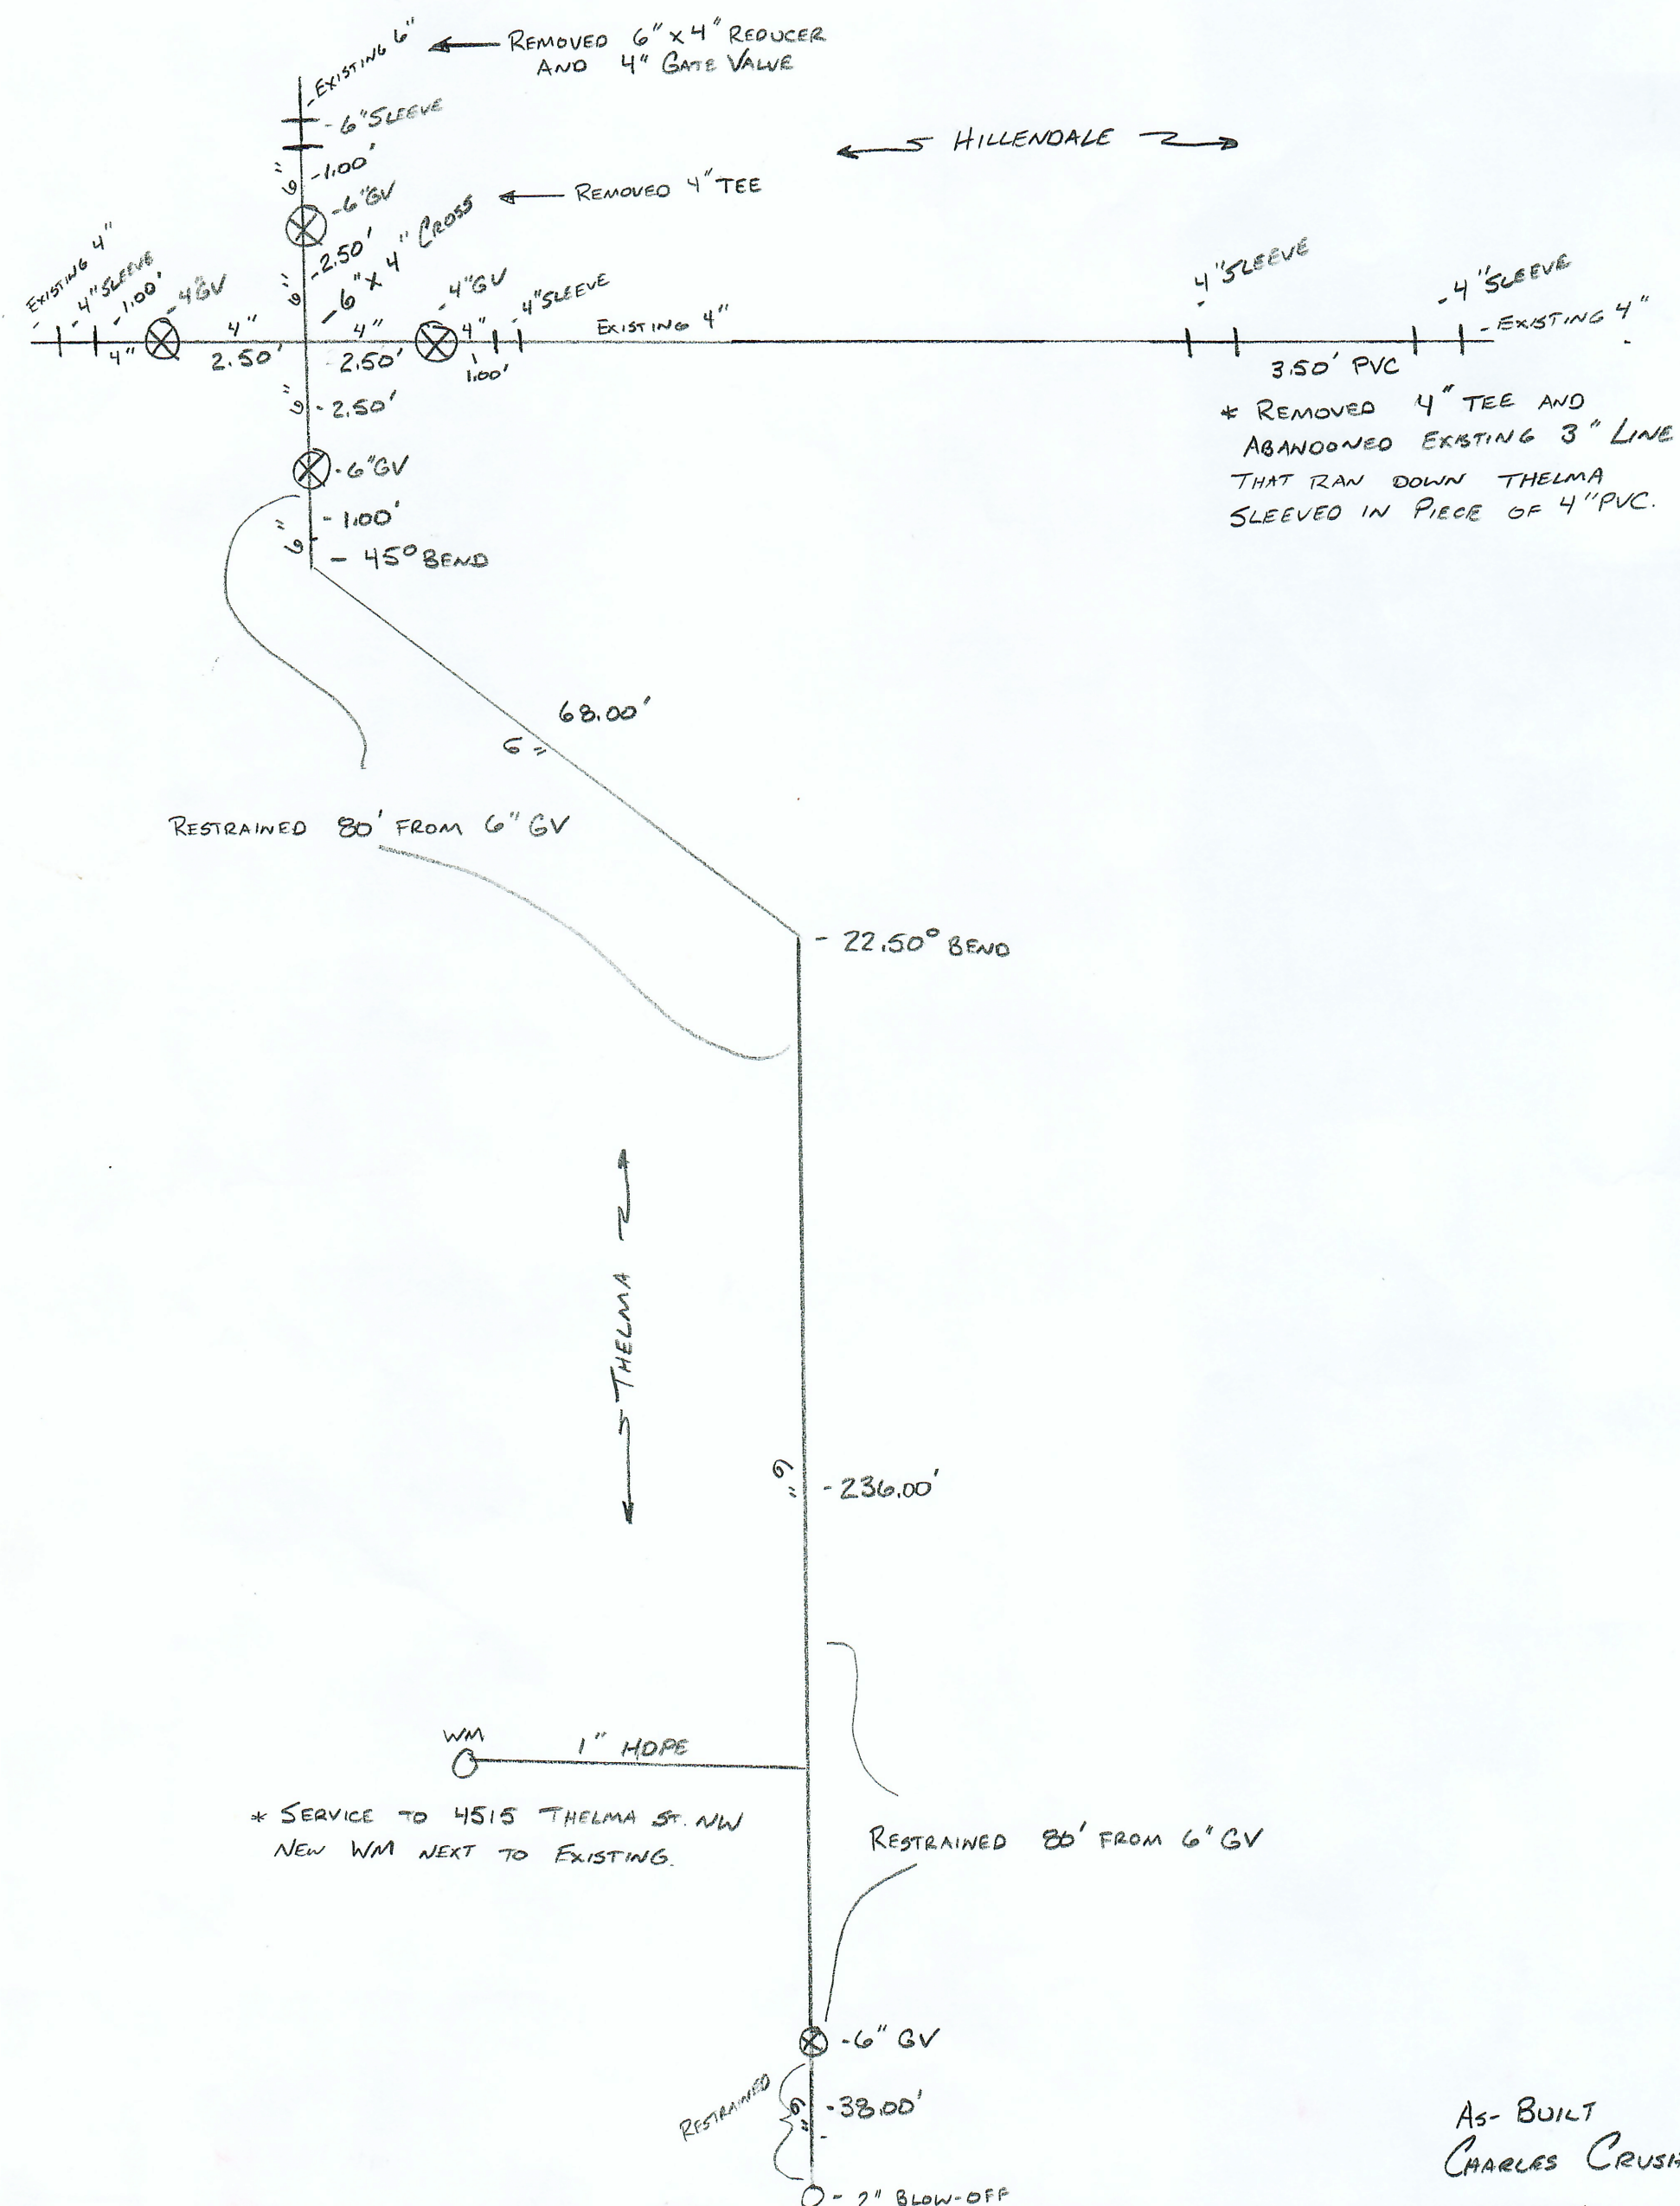

AS-BUILT
CHARLES CRUSH
12-06-16

WESTERN VIRGINIA
WATER AUTHORITY

Printed: 12/07/16 7:31:53 AM
Scale 1:282

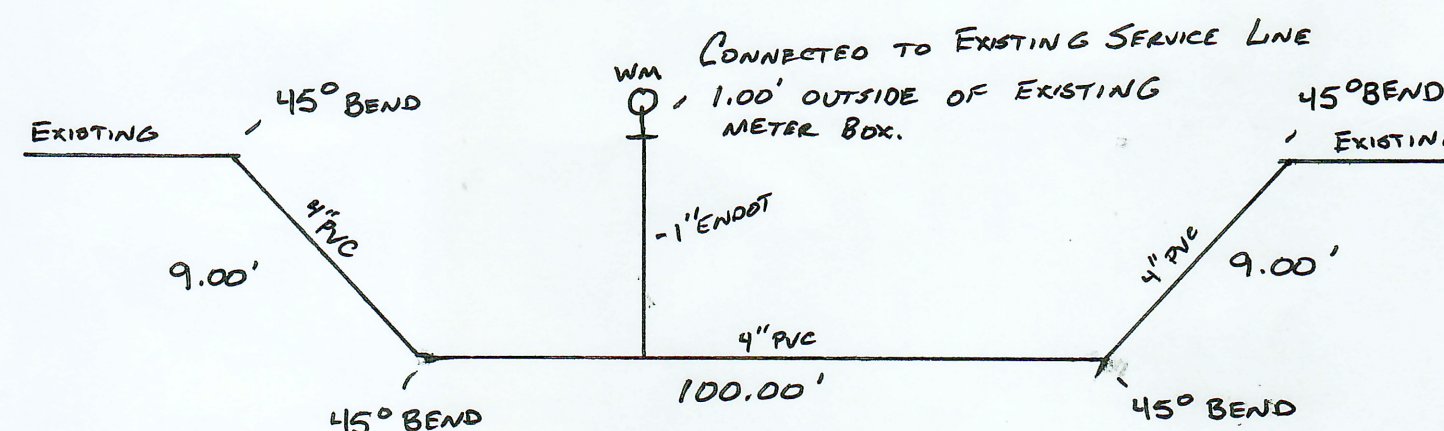

CHARLES CRUSH
AS-BUILT
12-07-16