

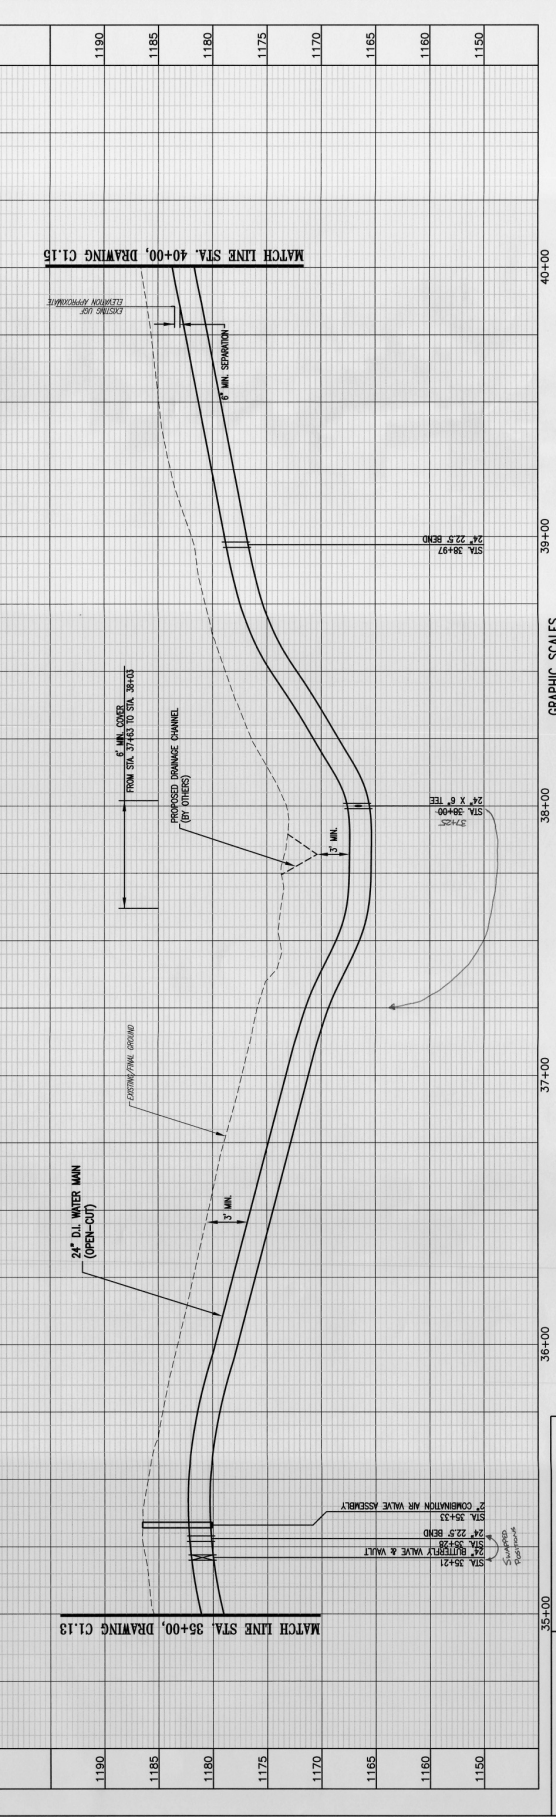 


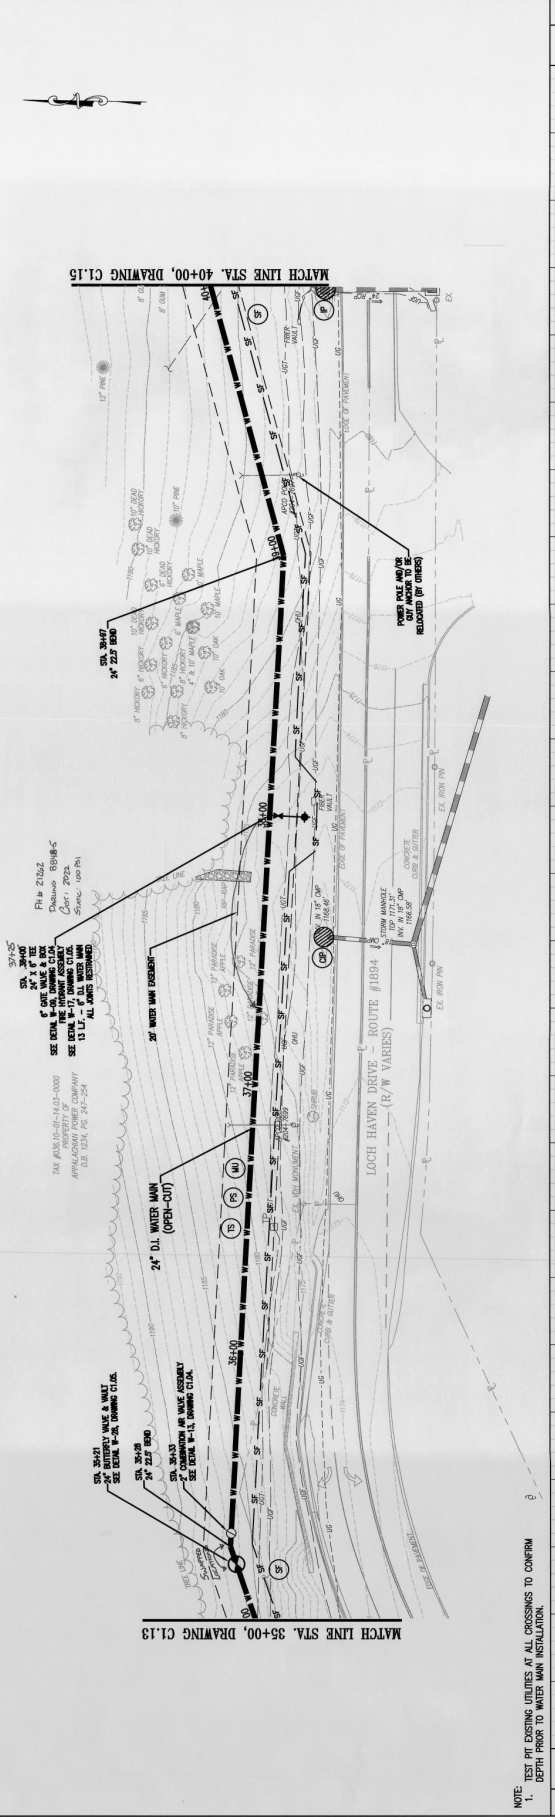

 (IN FEET) HORIZ. 1 inch = 20 feet		 (IN FEET) VERT. 1 inch = 5 feet					
DES. BY		SCALE: AS SHOWN		DRAWING		DESCRIPTION	
DRAWN: JBS		HORIZ: 1" = 20'		NORTH LOOP WATER MAIN EXTENSION		24" WATER MAIN PLAN - PROFILE	
CHECK: PM		VERT: 1" = 5'		THOMSON MEMORIAL DRIVE TO KESSLER MILL ROAD		STA. 35+00 TO STA. 40+00	
DATE: 6/23/22						C1.14	
						14	



Whitman, Requardt & Associates, LLP
1700 Kent Dr. Suite 1200 | Blacksburg, VA 24060

4/23/2022
10:11 A
J. Long
No. 000000

CONTRACT NO. 1000



NOTES:
 1. TEST PIT EXISTING UTILITIES AT ALL CROSSINGS TO CONFIRM DEPTH PRIOR TO WATER MAIN INSTALLATION.