



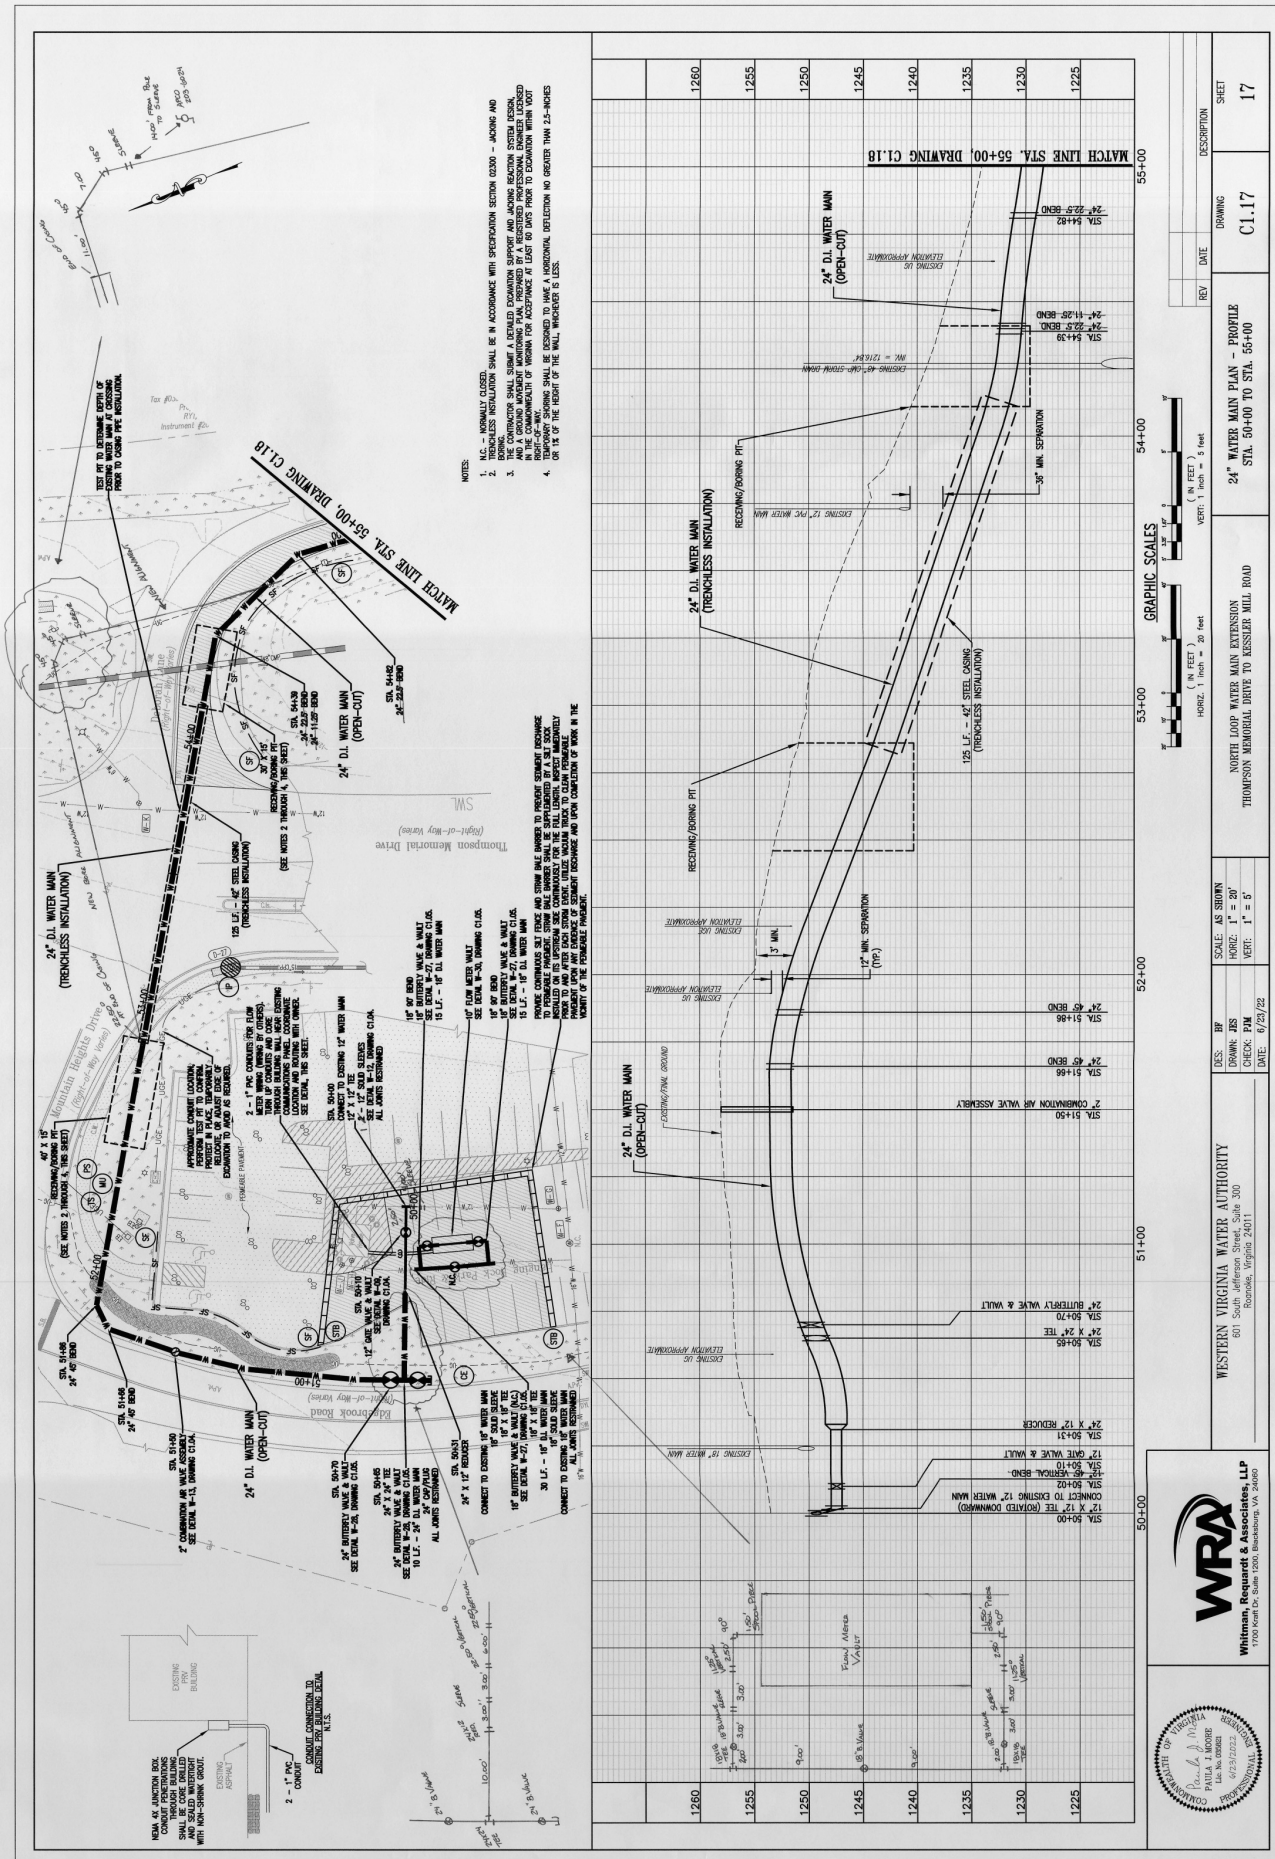

- NOTES
1. ALL CONDUITS SHALL BE IN ACCORDANCE WITH SPECIFICATION SECTION 0200 - JOINTS AND JOINTING.
 2. ALL CONDUITS SHALL BE IN ACCORDANCE WITH SPECIFICATION SECTION 0200 - JOINTS AND JOINTING.
 3. ALL CONDUITS SHALL BE IN ACCORDANCE WITH SPECIFICATION SECTION 0200 - JOINTS AND JOINTING.
 4. ALL CONDUITS SHALL BE IN ACCORDANCE WITH SPECIFICATION SECTION 0200 - JOINTS AND JOINTING.

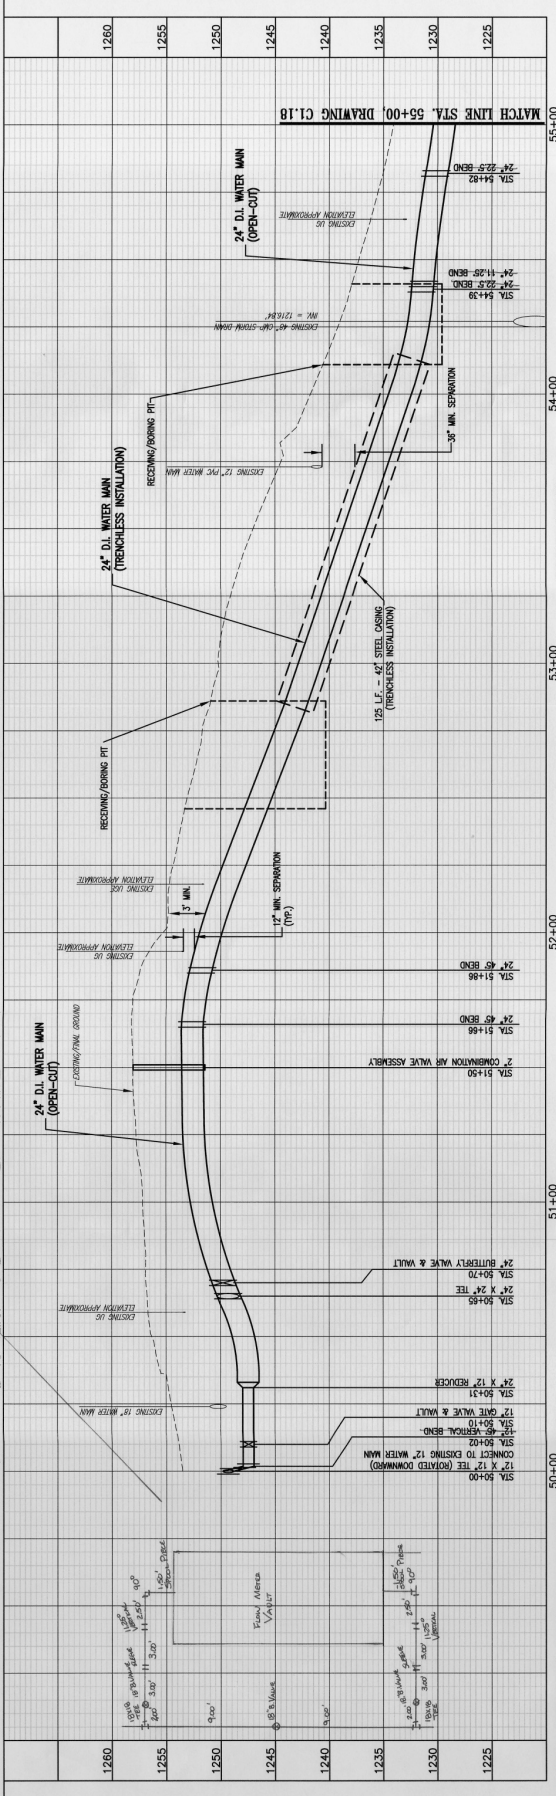

WRP
Whitman, Reardon & Associates, LLP
1700 Acad Dr., Suite 1200, Blacksburg, VA 24060

WESTERN VIRGINIA WATER AUTHORITY
601 South Jefferson Street, Suite 300
Roanoke, Virginia 24011

DESIGN: JRS
DRAWING: JRS
CHECK: JRS
DATE: 07/25/22

SCALE: AS SHOWN
HORIZ: 1" = 20'
VERT: 1" = 5'

24" WATER MAIN PLAN - PROFILE
STA. 50+00 TO STA. 55+00

GRAPHIC SCALES
HORIZ. 1 inch = 20 feet
VERT. 1 inch = 5 feet

REVISIONS

REV	DATE	DESCRIPTION
1		

SHEET
17