



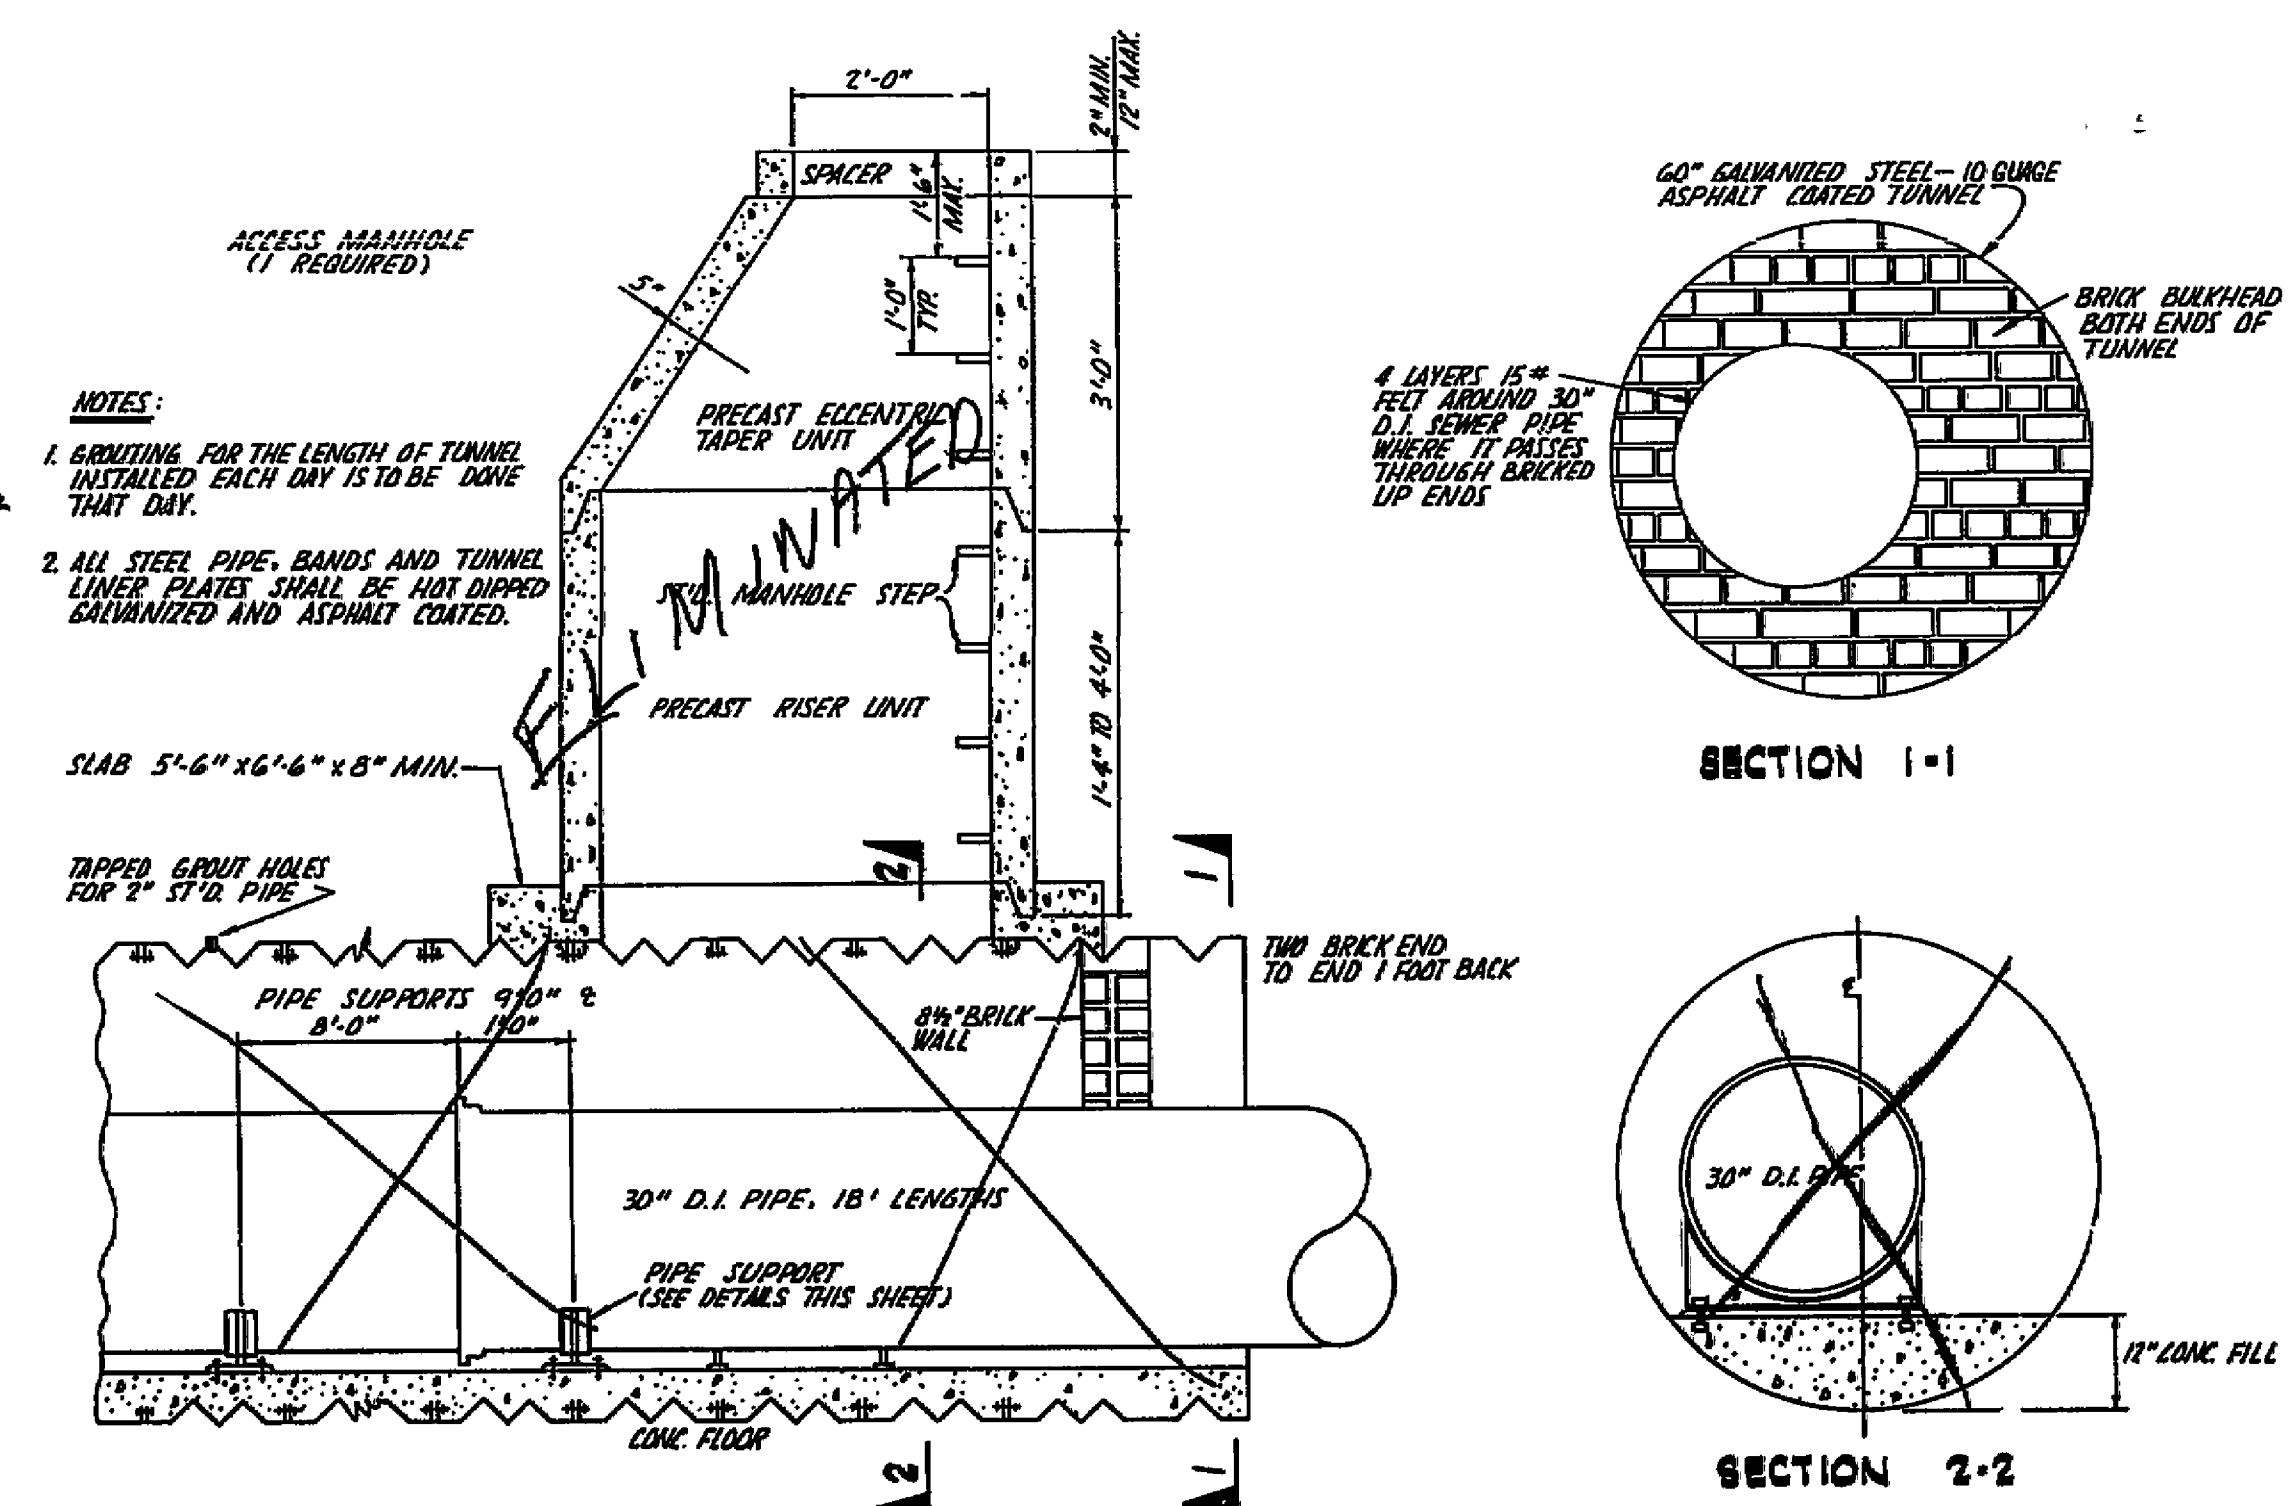

PIPE SLIT

PIPE SUPPORT SETTING DETAIL

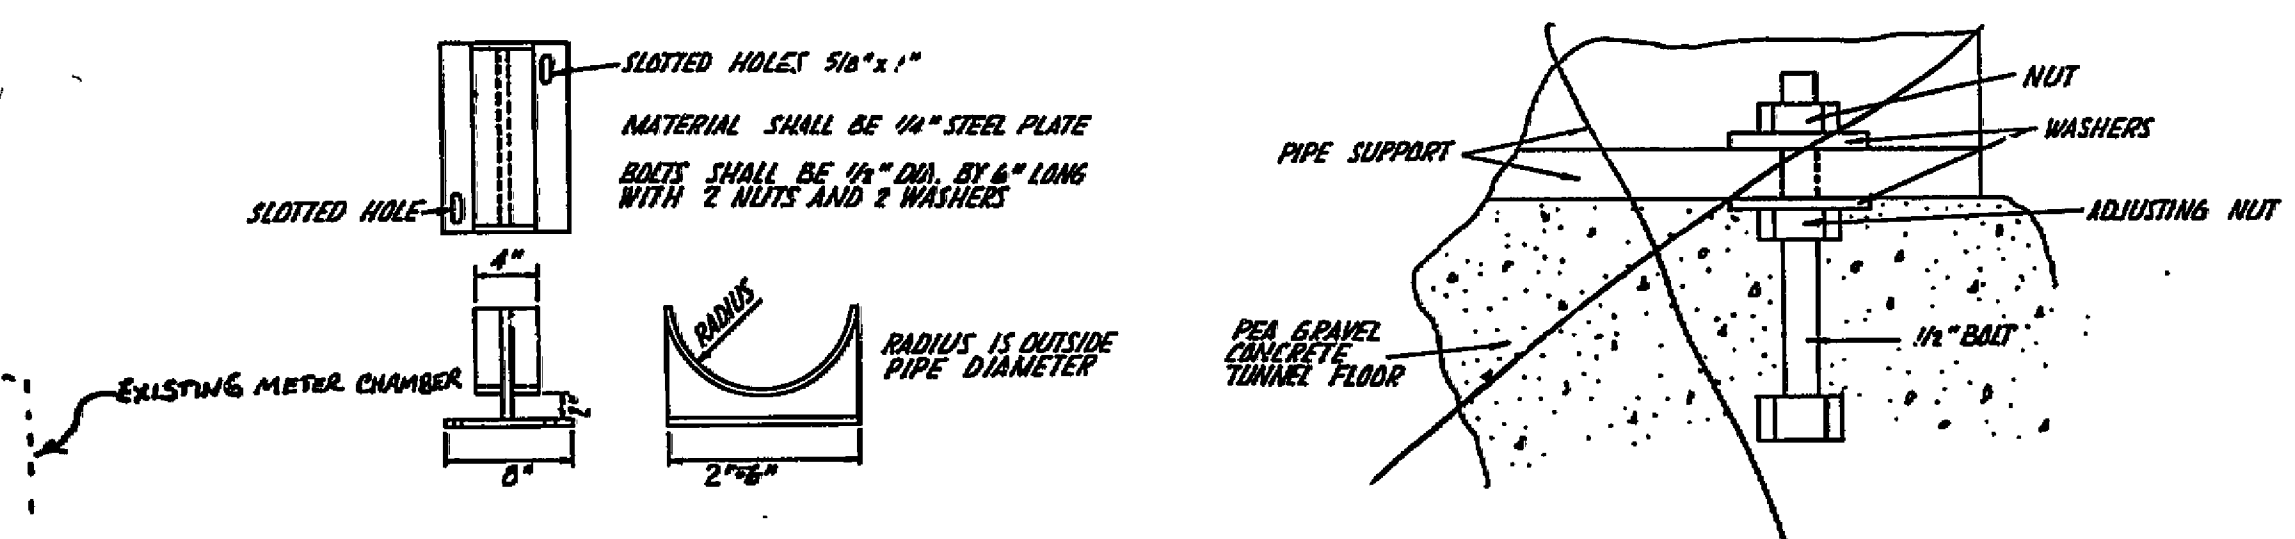

REV. 3	GENERAL REVISIONS	6-1-81
REV. 2	GENERAL REVISIONS	8-10-81
REV. 1	GENERAL REVISIONS	8-12-80
BOARD OF COUNTY SUPERVISORS ROCKNOLLE COUNTY, VIRGINIA		
WILLIAM C. OVERMAN ASSOCIATES, P.C.	TINKER CREEK STA. 190 + 00 to STA. 198 + 92	PROJECT NO. 79-S-5 DATE: JUNE 1980 SHEET 16 OF 17