


DATE STARTED					
DATE COMP.	1990				
FEET MAIN	SIZE	VALVE	VAULT	BOX	
1565'	12"	1	1		
F. H. COMP.	4				
F. H. STUB ONLY					
SERV. INS. BY:					
MAIN INS. BY:					
NO. 1/2" SERV. INS.					
CITY OR CO.	CITY				
DEPT. INSP.					

- CITY OF ROANOKE TO TAP EXIST. 12" MAIN.
- CONTRACTOR TO CONNECT NEW 12" MAIN TO EXIST. MAIN, AS SHOWN.
- CONTRACTOR SHALL INSTALL MAIN 5' OFF PROPERTY LINE, FOUR(4) FIRE HYDRANT ASSEMBLIES, & ONE(1) 12" GATE VALVE.
- CONTRACTOR TO EXPOSE 12" MAIN, PROVIDE & INSTALL TAPPING VALVE & VAULT VALVE.
- CONTRACTOR TO PROVIDE NECESSARY SHORING TO MEET OSHA REQUIREMENTS

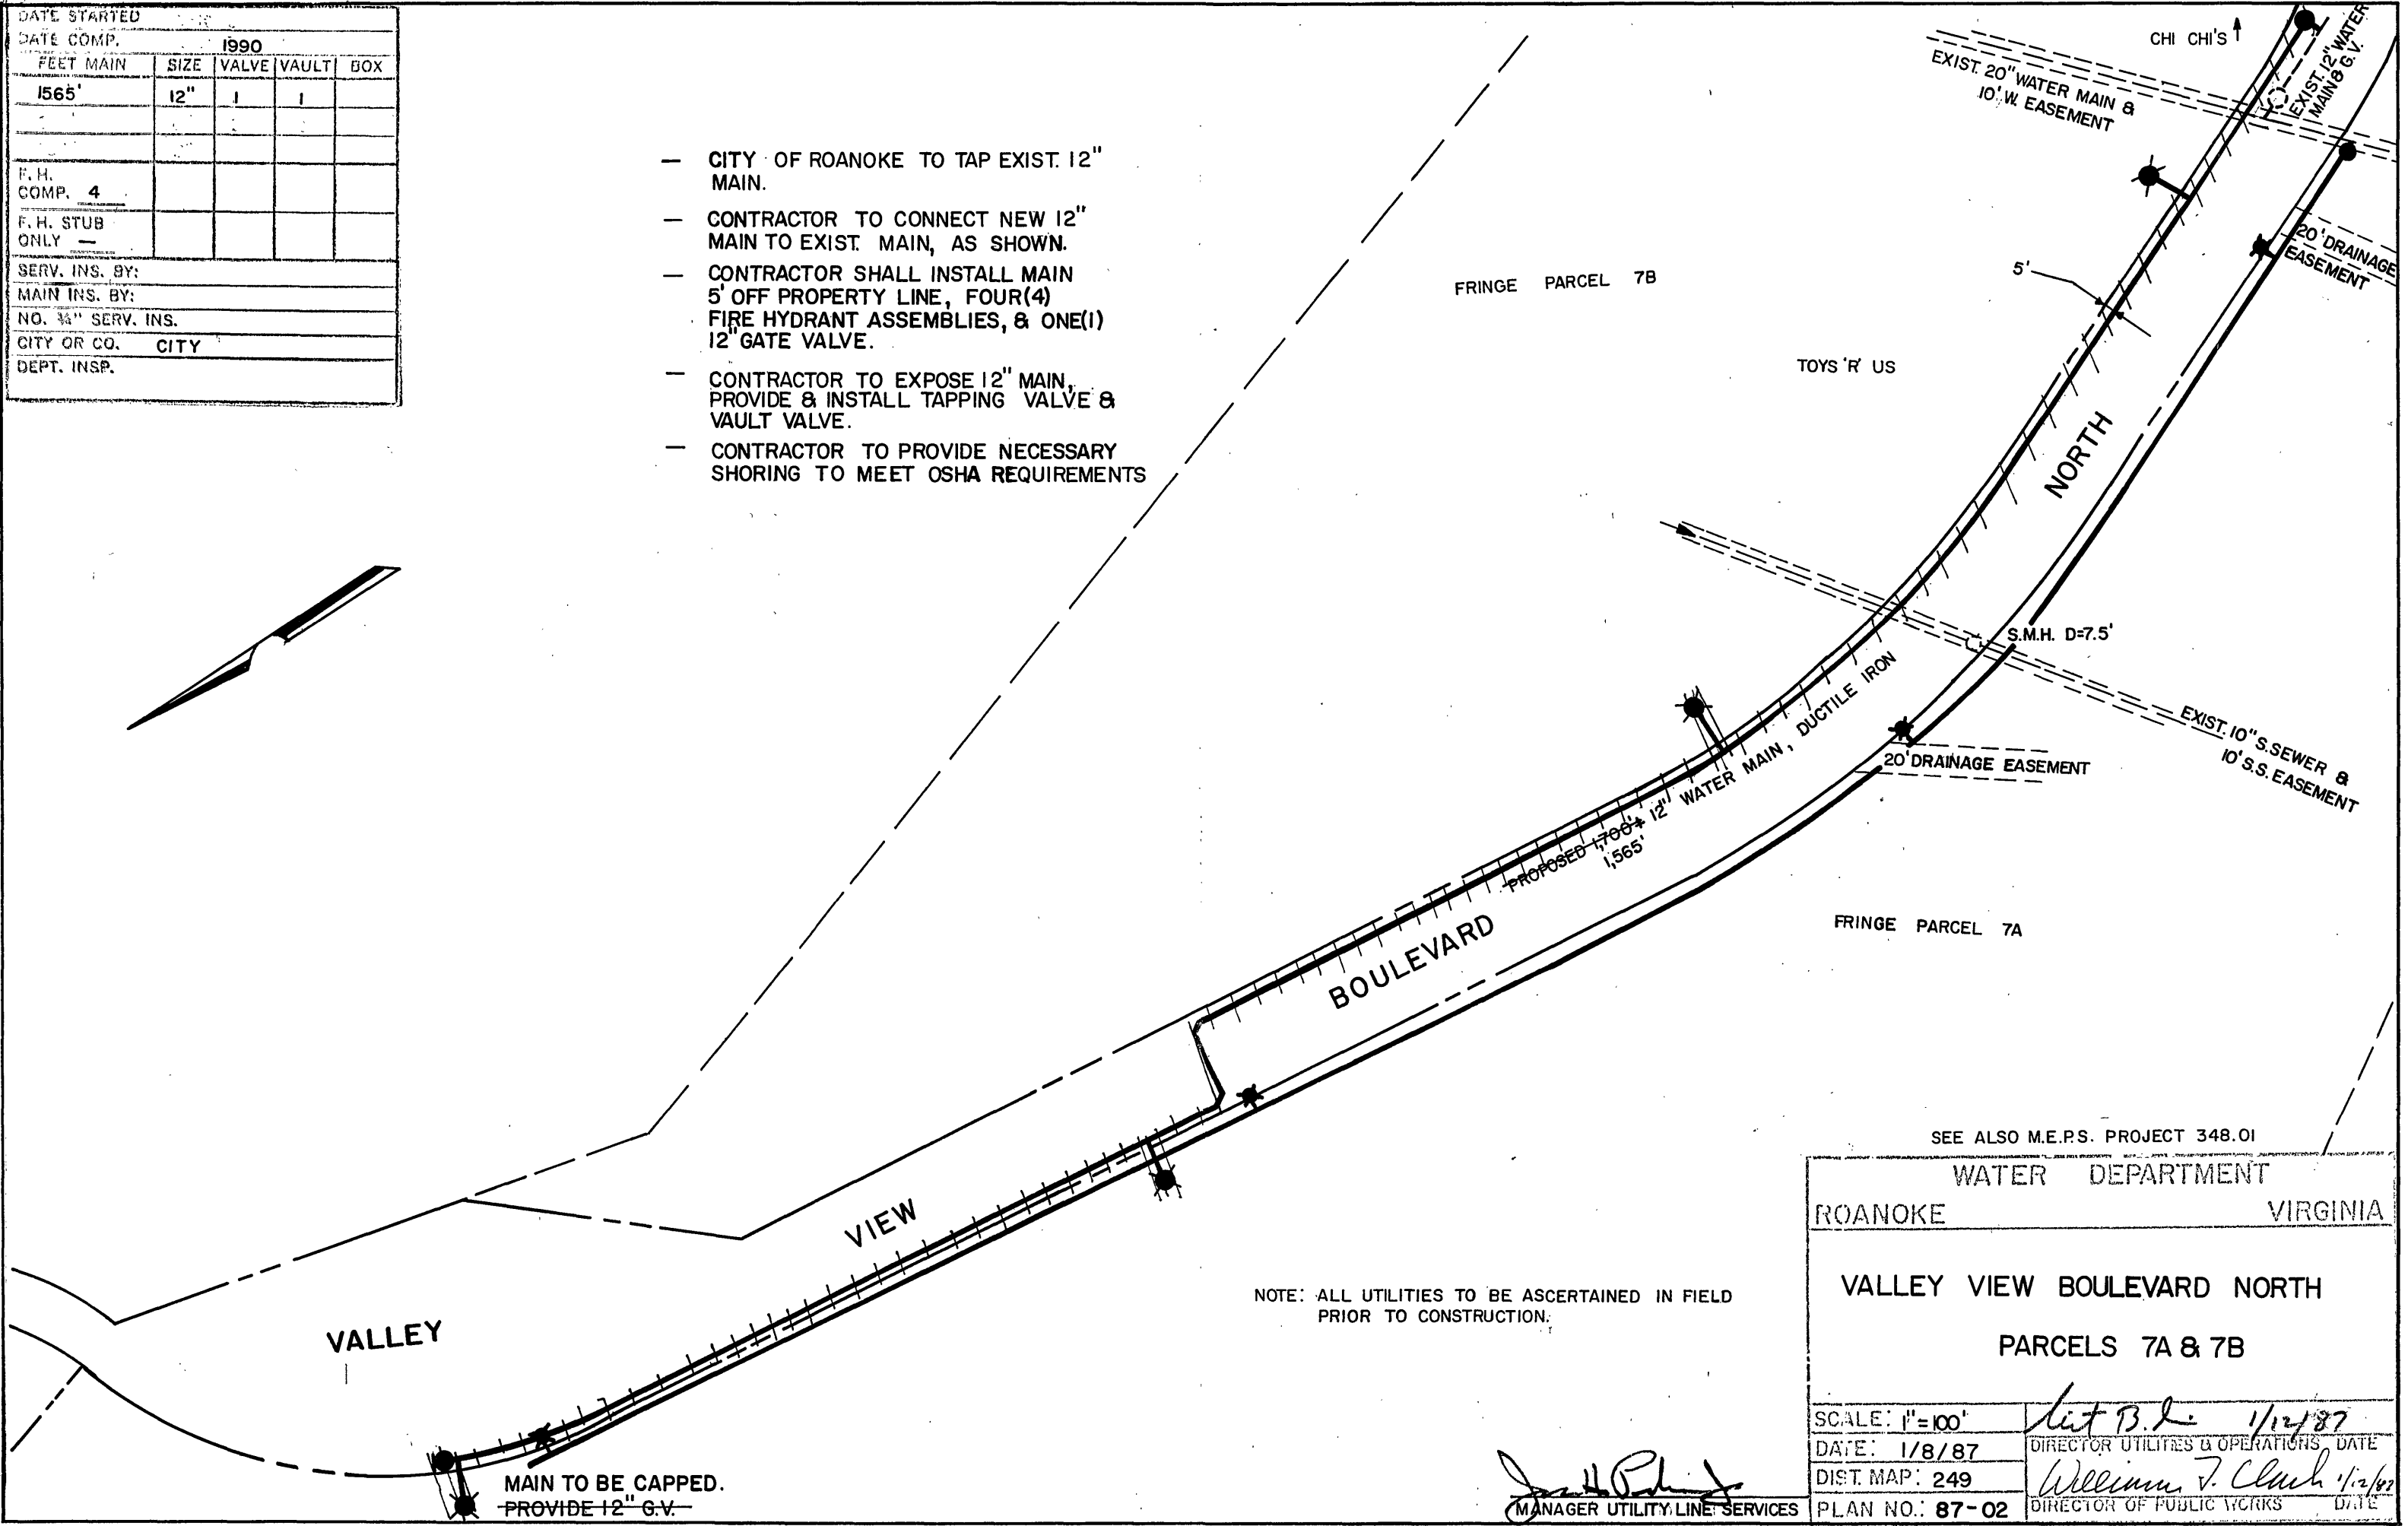

NOTE: ALL UTILITIES TO BE ASCERTAINED IN FIELD PRIOR TO CONSTRUCTION.

SEE ALSO M.E.P.S. PROJECT 348.01

WATER DEPARTMENT	
ROANOKE	VIRGINIA
VALLEY VIEW BOULEVARD NORTH	
PARCELS 7A & 7B	
SCALE: 1" = 100'	<i>lit B. L.</i> 1/12/87
DATE: 1/8/87	DIRECTOR UTILITIES & OPERATIONS DATE
DIST. MAP: 249	<i>William J. Clark</i> 1/12/87
MANAGER UTILITY LINE SERVICES	DIRECTOR OF PUBLIC WORKS DATE
PLAN NO.: 87-02	