


SEWER MANHOLE

13TH ST. N.E.

Baldwin Ave N.E.

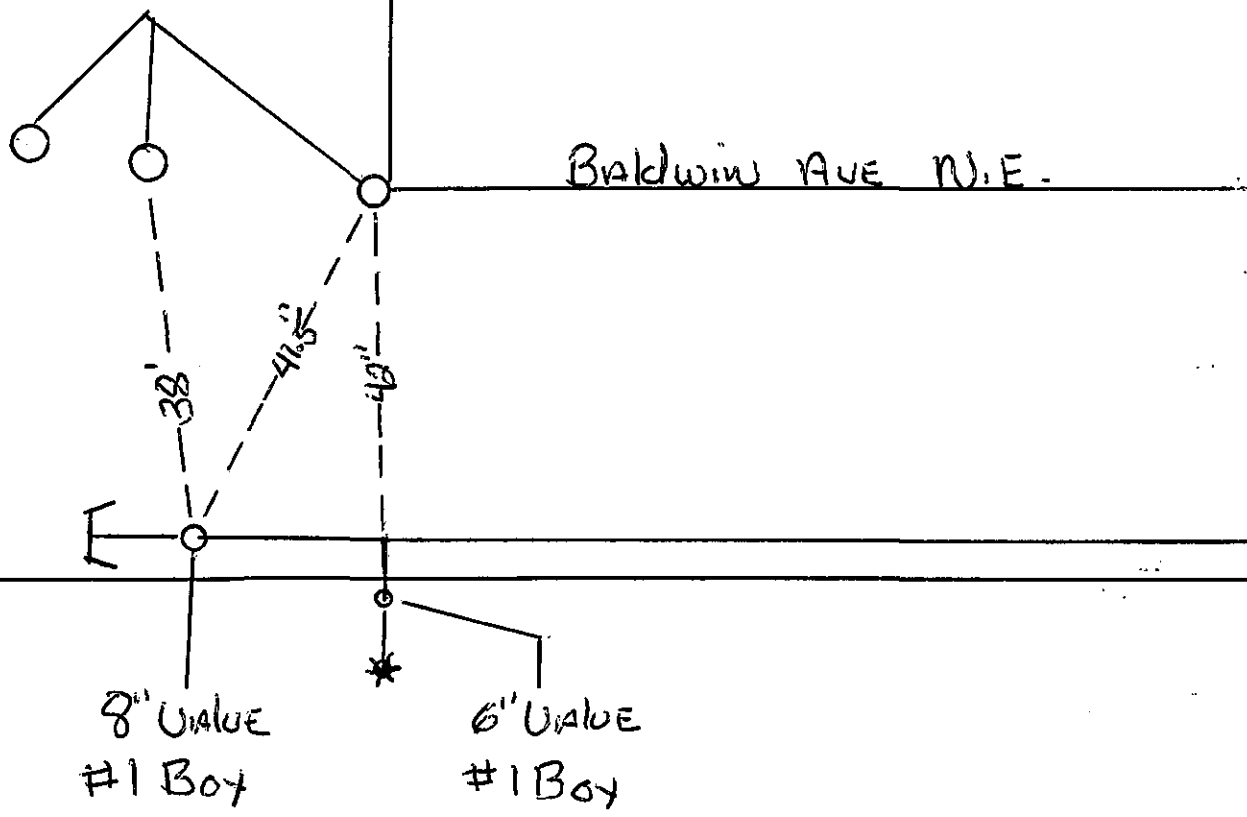

DATE	NO.	SIZE	MAKE	OPEN	TURNS
3-23-04	1	6"	AUK	R.	21
3-23-04	1	8"	AUK	R.	27

P. L. Measurements		
No.	Distance	Direction

CITY OF ROANOKE - WATER DEPT.
 VALVE DIAGRAM
 13TH ST. & Baldwin Ave N.E.
 BALDWIN & 13TH ST NE
 Sec. Map
 Date 3-23-04 Page No.

