


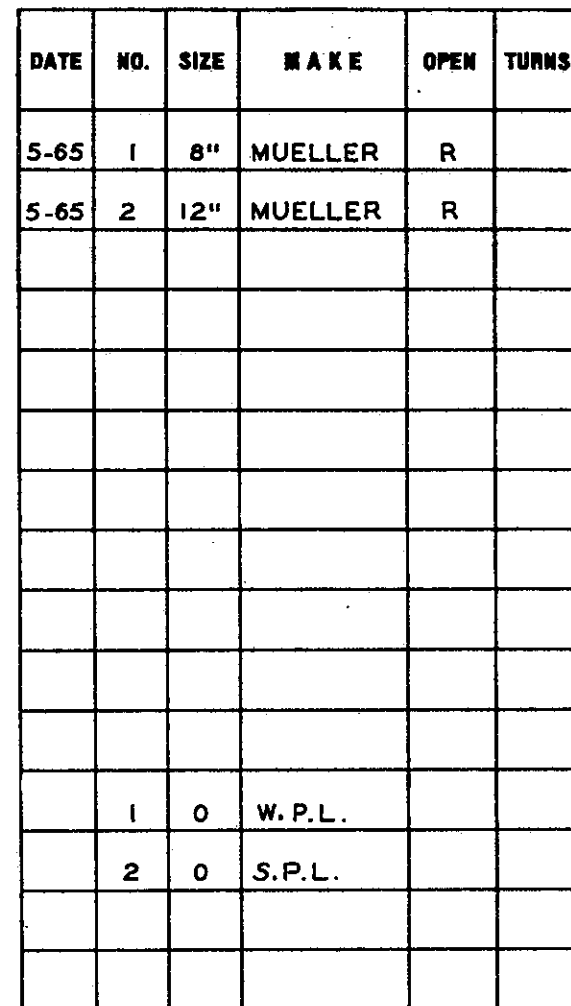

CITY OF ROANOKE - WATER DEPT.	
VALVE DIAGRAM	
BALDWIN AVENUE &	
BIBB STREET N.E.	
SEC. MAP	333
DATE	PAGE NO.