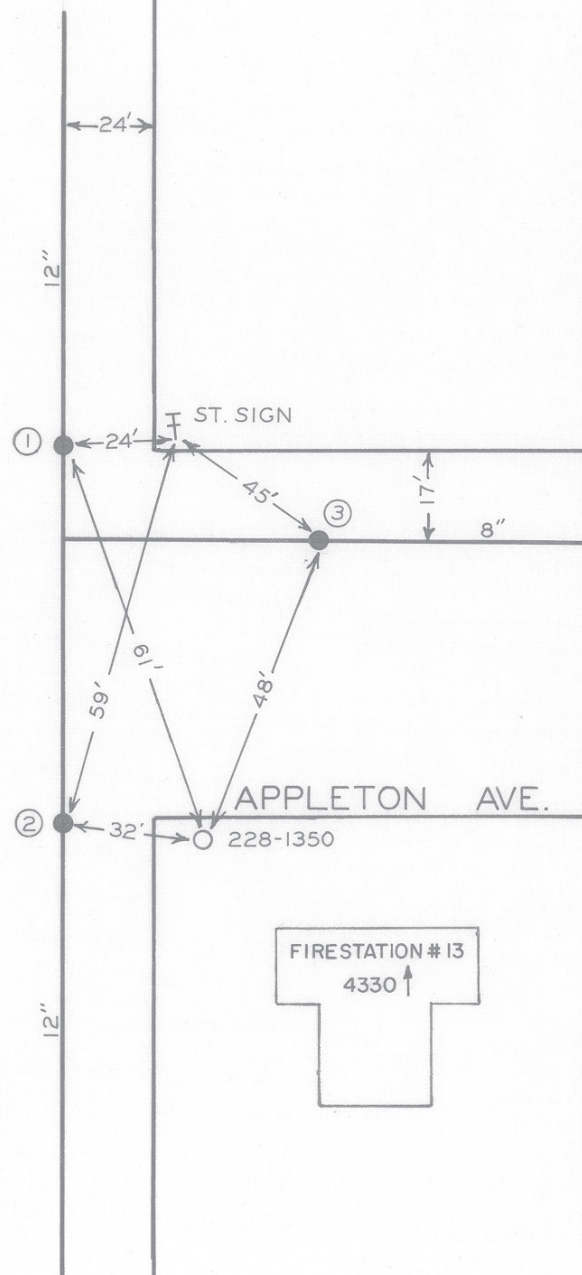


PETERS

[illegible]

CITY OF ROANOKE - WATER DEPT.
VALVE DIAGRAM

APPLETON AVE.&PETERS CREEK
ROAD

SEC. MAP 638

N.W.

DATE _____

PAGE NO.