


"IMPERIAL" TRACING CLOTH
K & E CO., N. Y.

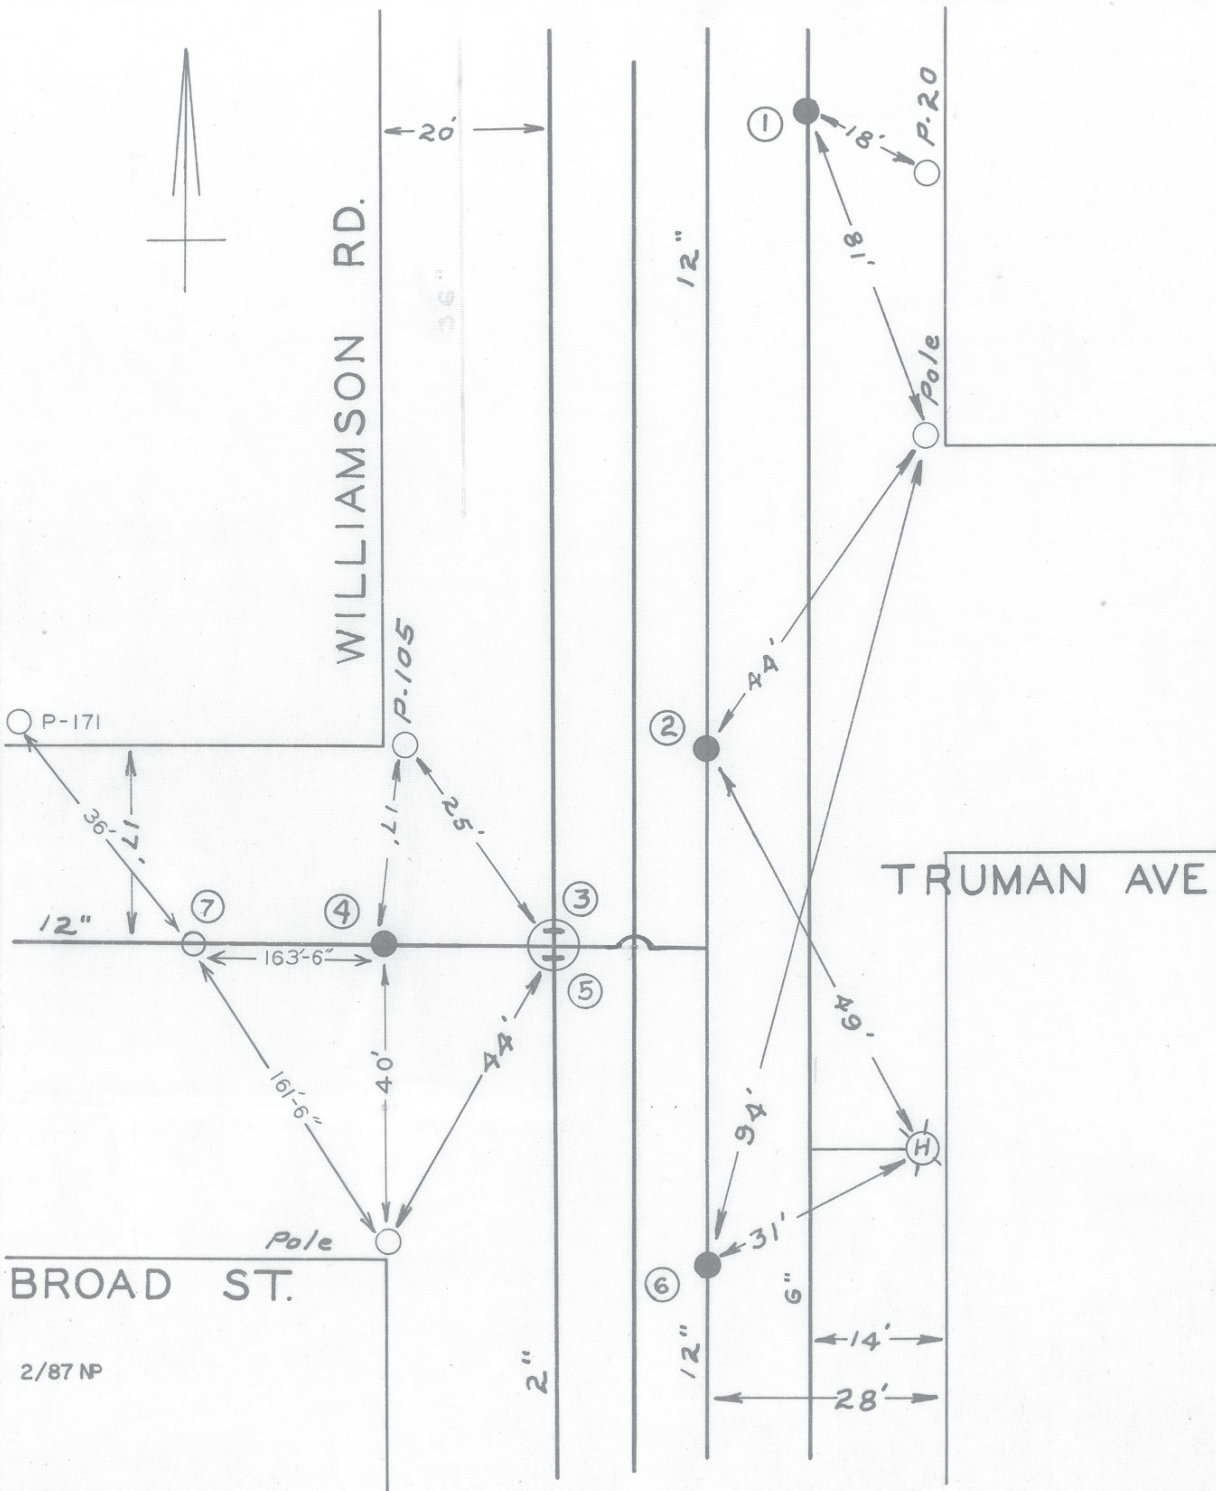

2/87 NP

DATE	NO.	SIZE	MAKE	OPEN	TURNS
1951	1	6"			
1952	2	12"	MUELLER	R	38
1951	3	2"			
1952	4	12"	MUELLER	R	38
1951	5	2"			
1953	6	12"	MUELLER	R	38
2-70	7	1"	PITOT STATION		
1 83'-N NPL - TRUMAN					
2 0 NPL - BROAD					
3 18'-S NPL - BROAD					
4 0 WPL					
5 18'-S NPL					
6 0 SPL - BROAD					

CITY OF ROANOKE - WATER DEPT.	
VALVE DIAGRAM	
BROAD ST. - TRUMAN AVE. & WILLIAMSON RD.	
SEC. MAP 209	N.W.
DATE	PAGE NO.