


HERSHBERGER ROAD

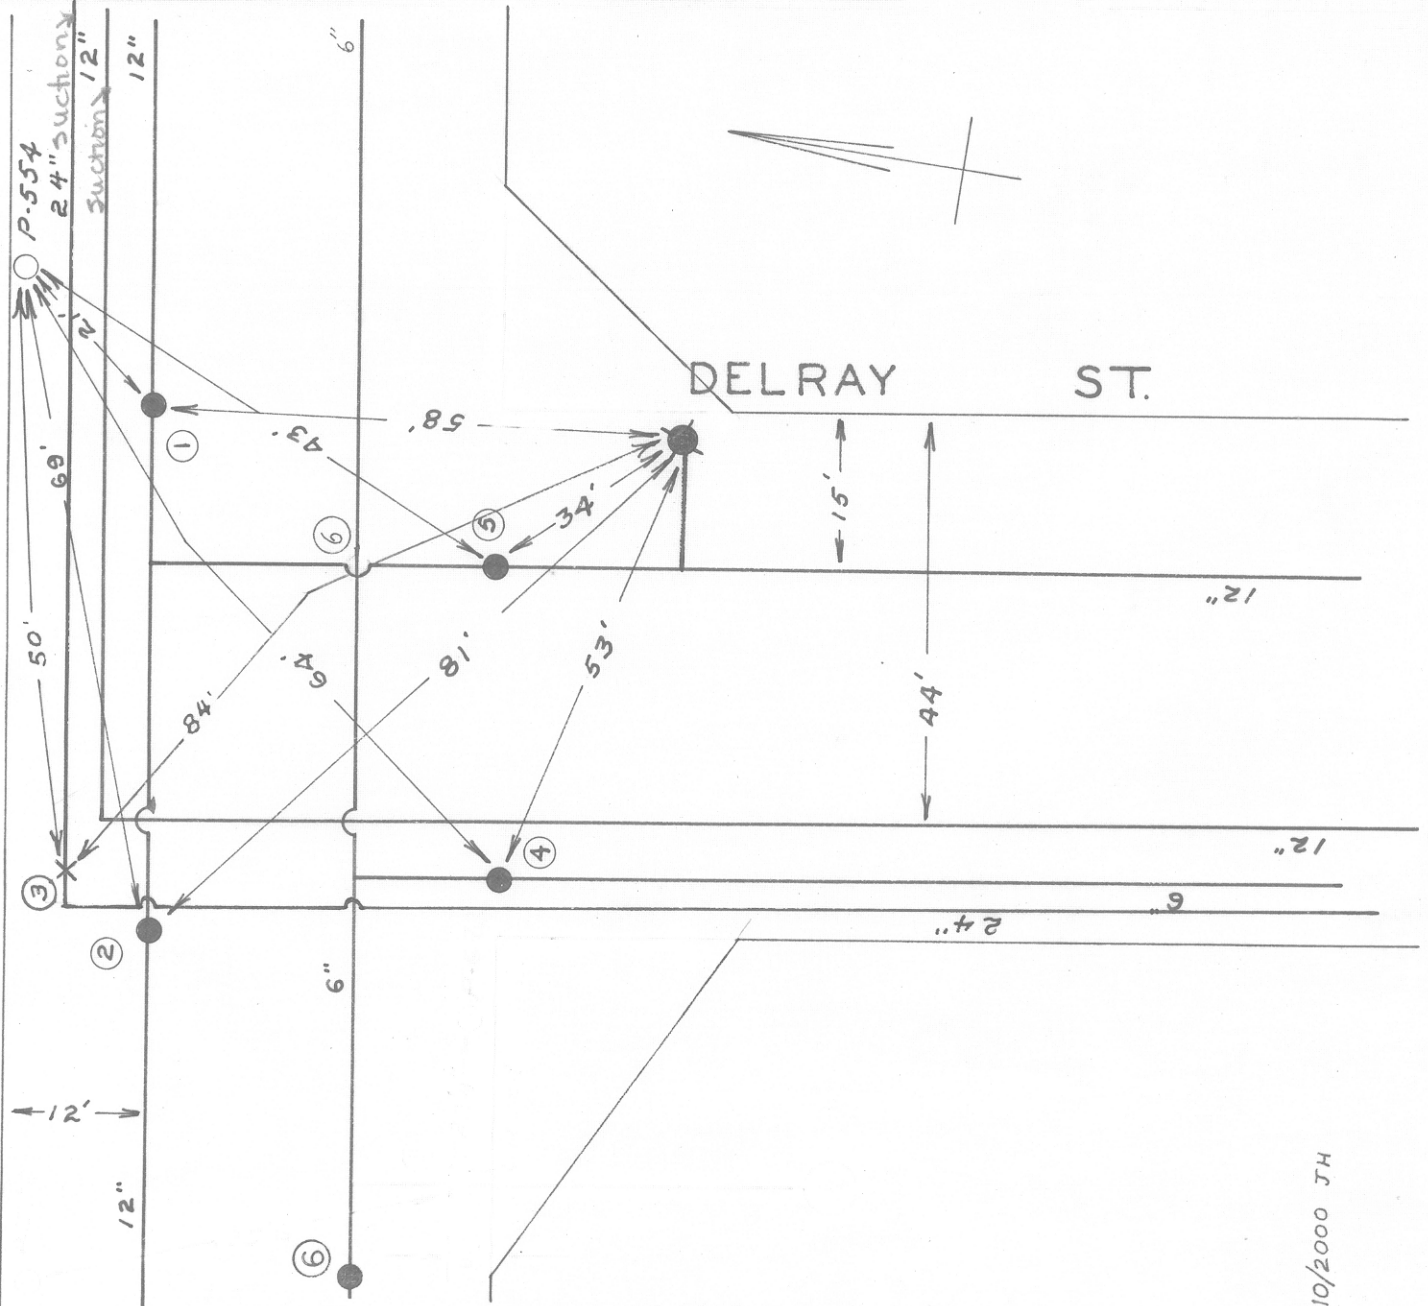

DATE	NO.	SIZE	MAKE	OPEN	TURNS
WR 1951	1	12"		R	
1952	2	12"		R	
1964	3	3/4" c.c.	AIR VALVE	R	
1951	4	6"		R	
WR 1952	5	12"	MUELLER	AIR RELIEF VALVE	
	6		BLOW OFF		
	1	0	EPL		
	2	0	WPL		
	3	24'	W.-E.P.L.		
	4	0	SPL		
	5	0	SPL		

CITY OF ROANOKE - WATER DEPT.
 VALVE DIAGRAM
 DELRAY ST. & HERSHBERGER ROAD
 HERSHBERGER ROAD
 SEC. MAP 228 N.W.
 DATE PAGE NO.