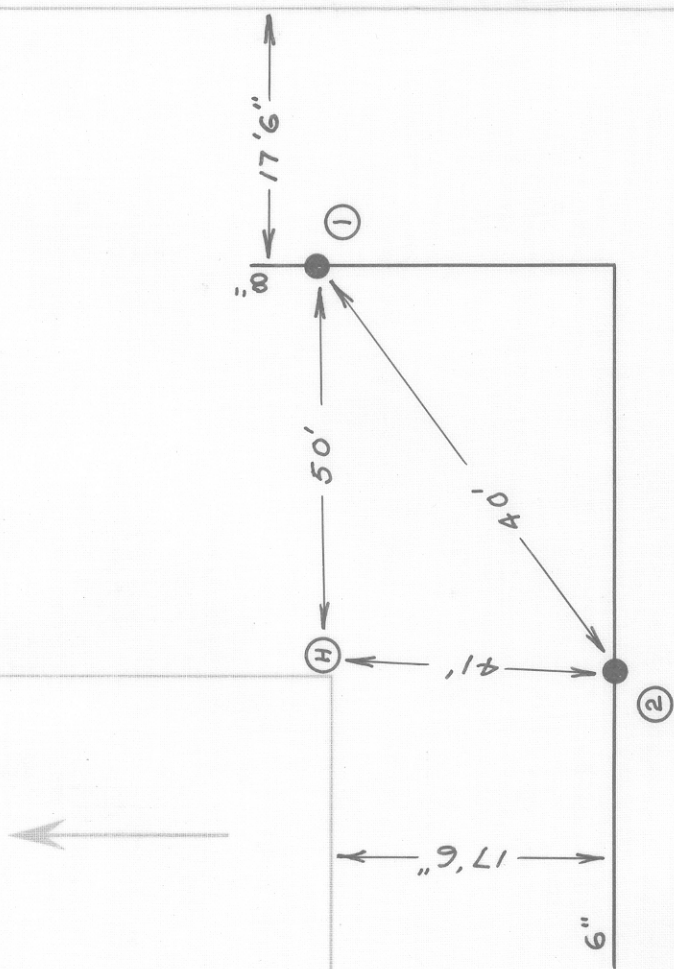


[illegible]

CITY OF ROANOKE—WATER DEPT

VALVE DIAGRAM

HILDEBRAND ROAD &

WHITNEY AVE. N.W.

SEC. MAP 220

DATE _____

PAGE NO.