


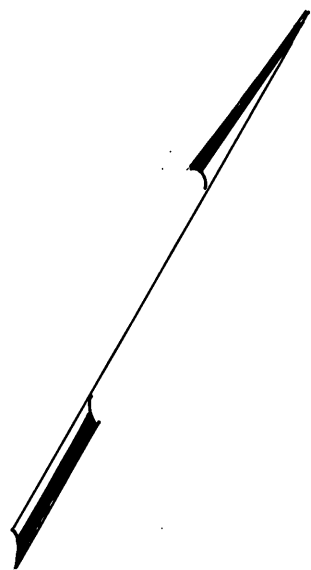

MABRY ~~ST.~~ S.E.
Ave.

6

1527

A.E.P. POLE NO.
302-7513

[illegible]

CITY OF ROANOKE—WATER DEP'T VALVE DIAGRAM

1527 MABRY ST. Ave.

S.E.

SEC. MAP 438

DATE

PAGE NO.