


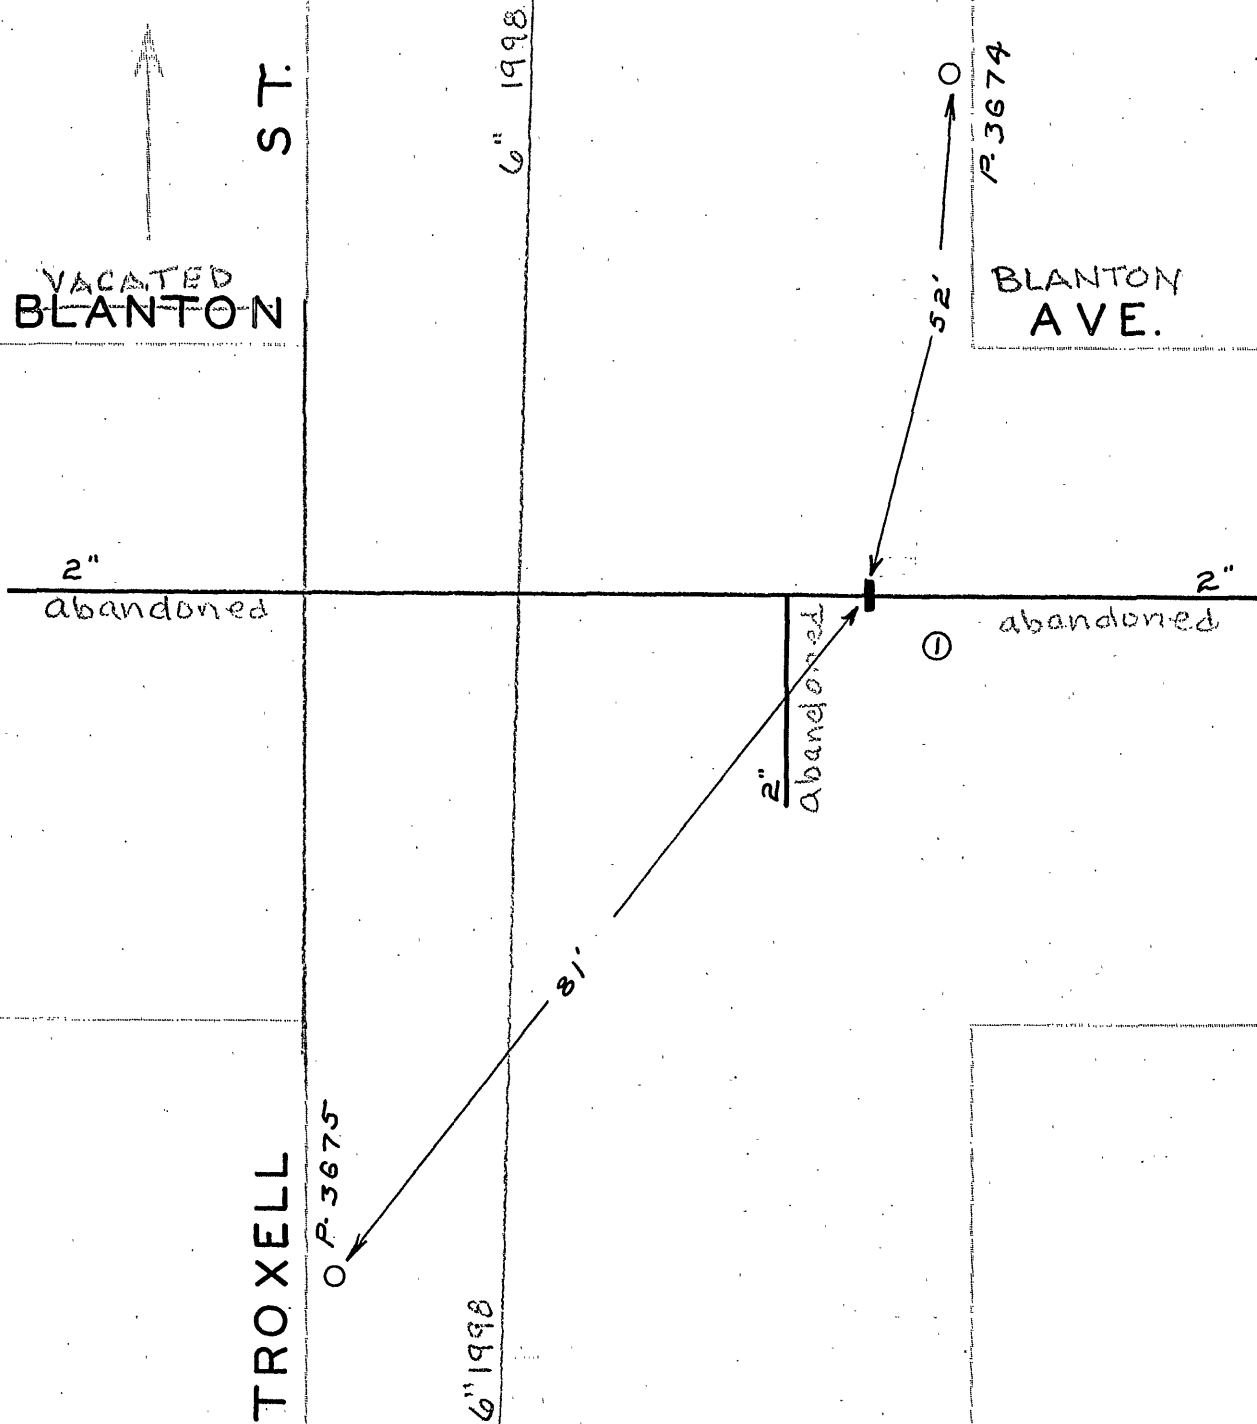

DATE	NO.	SIZE	NAME	OPEN	THRU
C.C.	1	2"			

CITY OF HOAHORE—WATER GENT
VALVE DIAGRAM

BLANTON AVE. &
TROXELL ST. S. E.

564. WAF 439

SAFE

PAGE NO.