
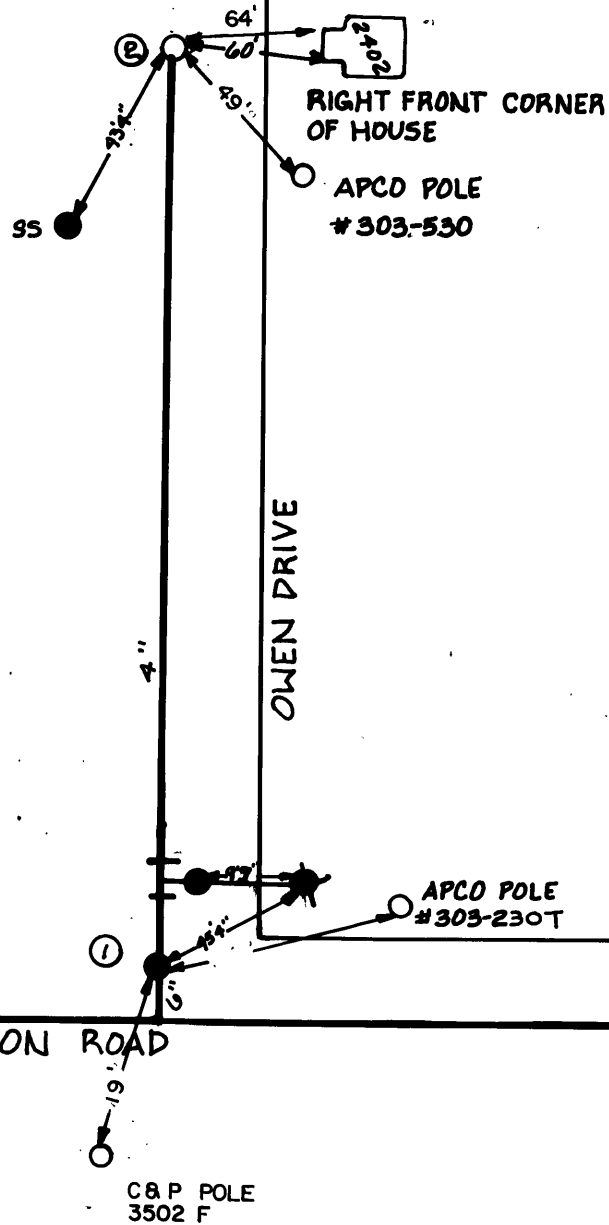


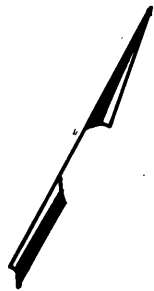

DATE	NO.	SIZE	MAKE	OPEN	TURNS
11-80	1	6"	MUELLER	R	
11-80	2	2"	BLOWOFF	L	

CITY OF ROANOKE—WATER DEPT
VALVE DIAGRAM
CRAIG-ROBERTSON AND
OWEN DRIVE
SE.
SEC. MAP 437
DATE NOV. 28, 1980 PAGE NO.