


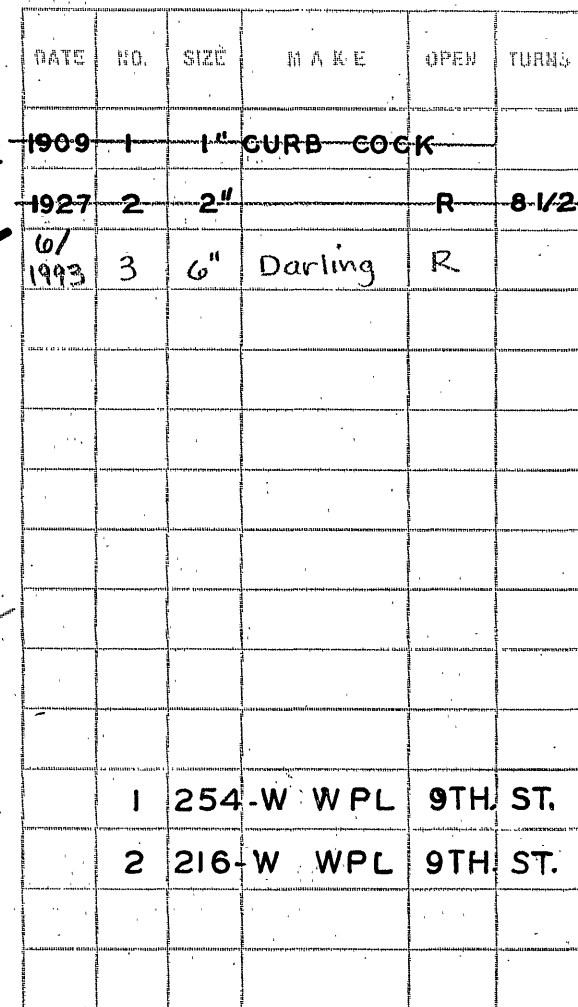

DATE: _____ PAGE NO. **S.E.139**

11/20/42. J.H.W.